
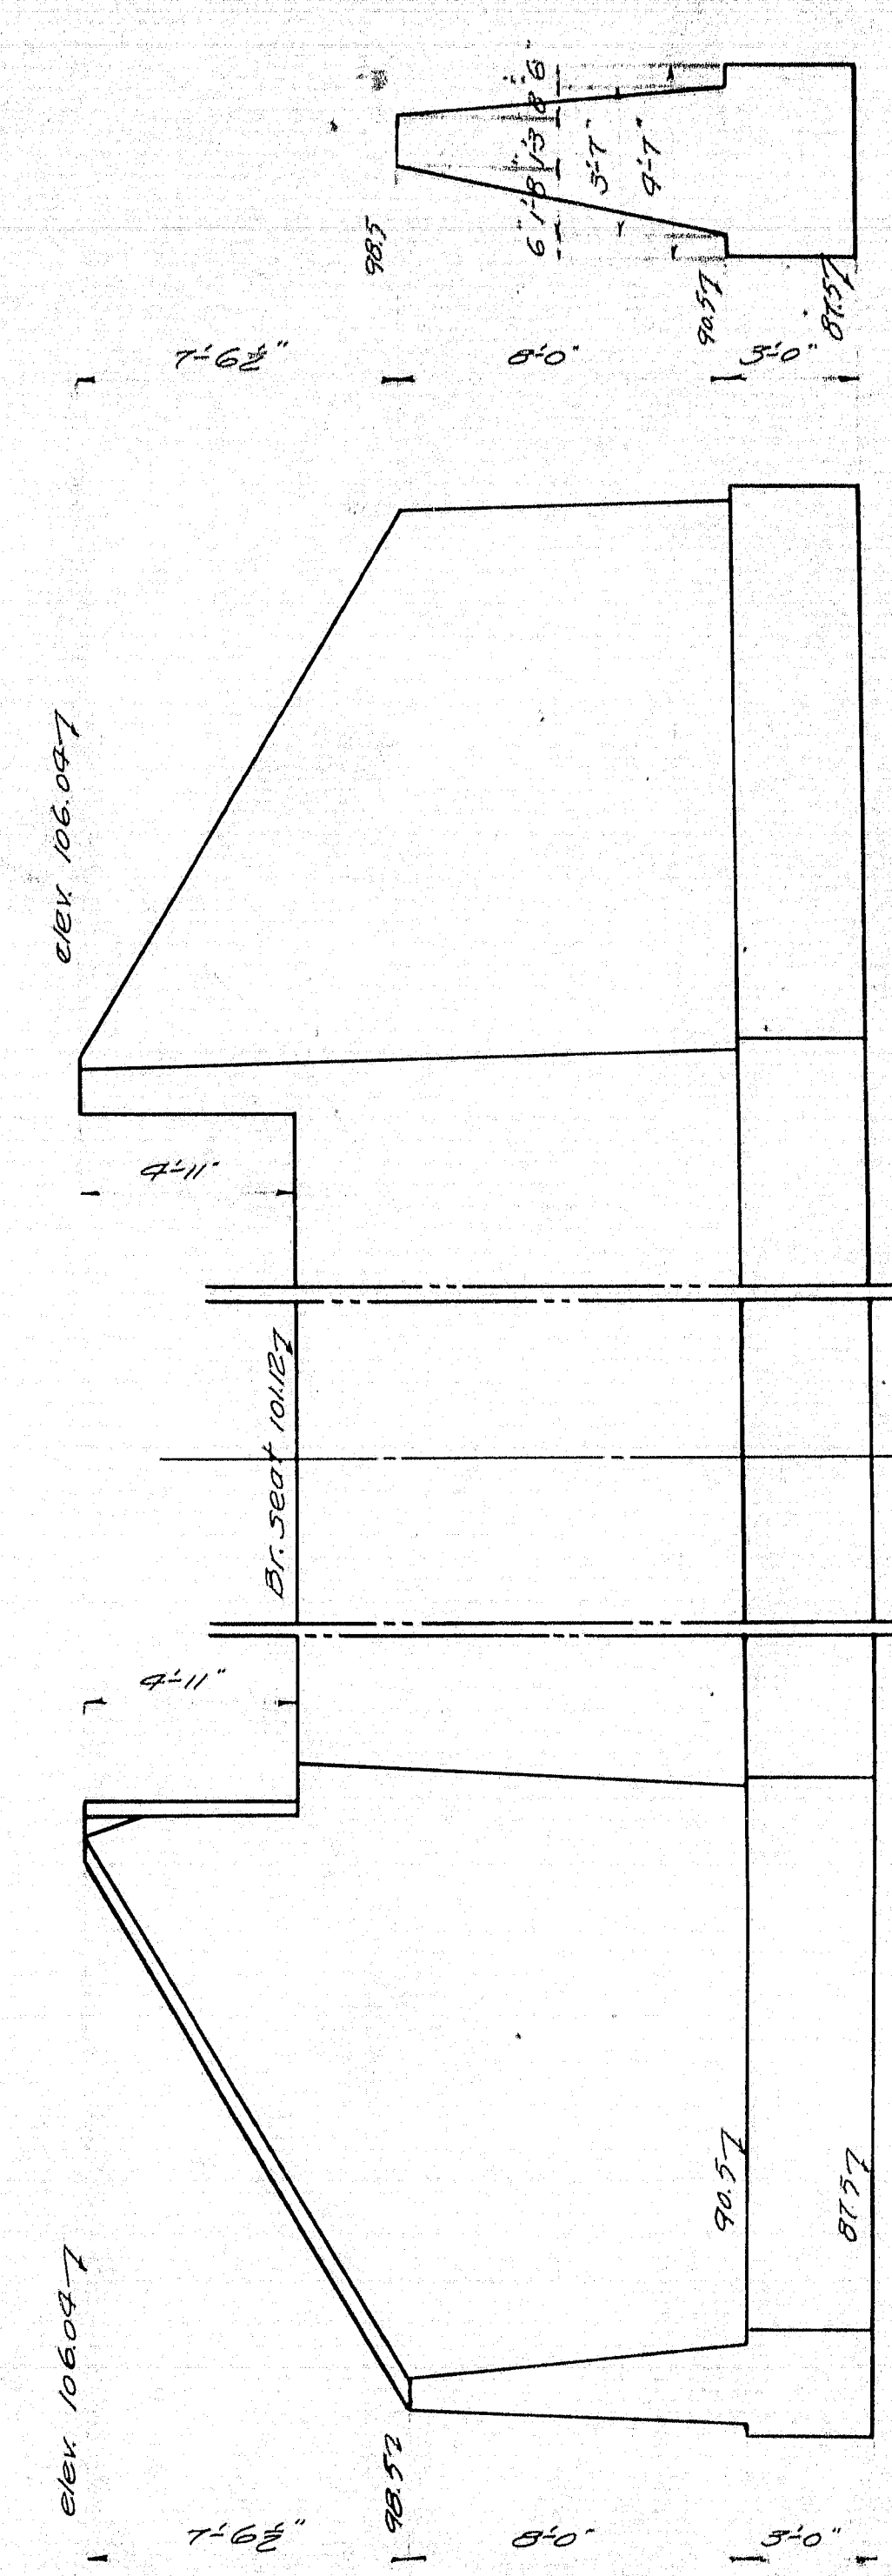


MAINE HIGHWAY COMM.
BRIDGE DIV.
BEAR RIVER BRIDGE
IN THE TOWN OF
NEWRY OXFORD CO.
SURVEY PLAN
SHEET 1 OF 3 AUGUSTA, ME JAN. 21, 1929

11-101

0 1 2 3 4 5 INCHES

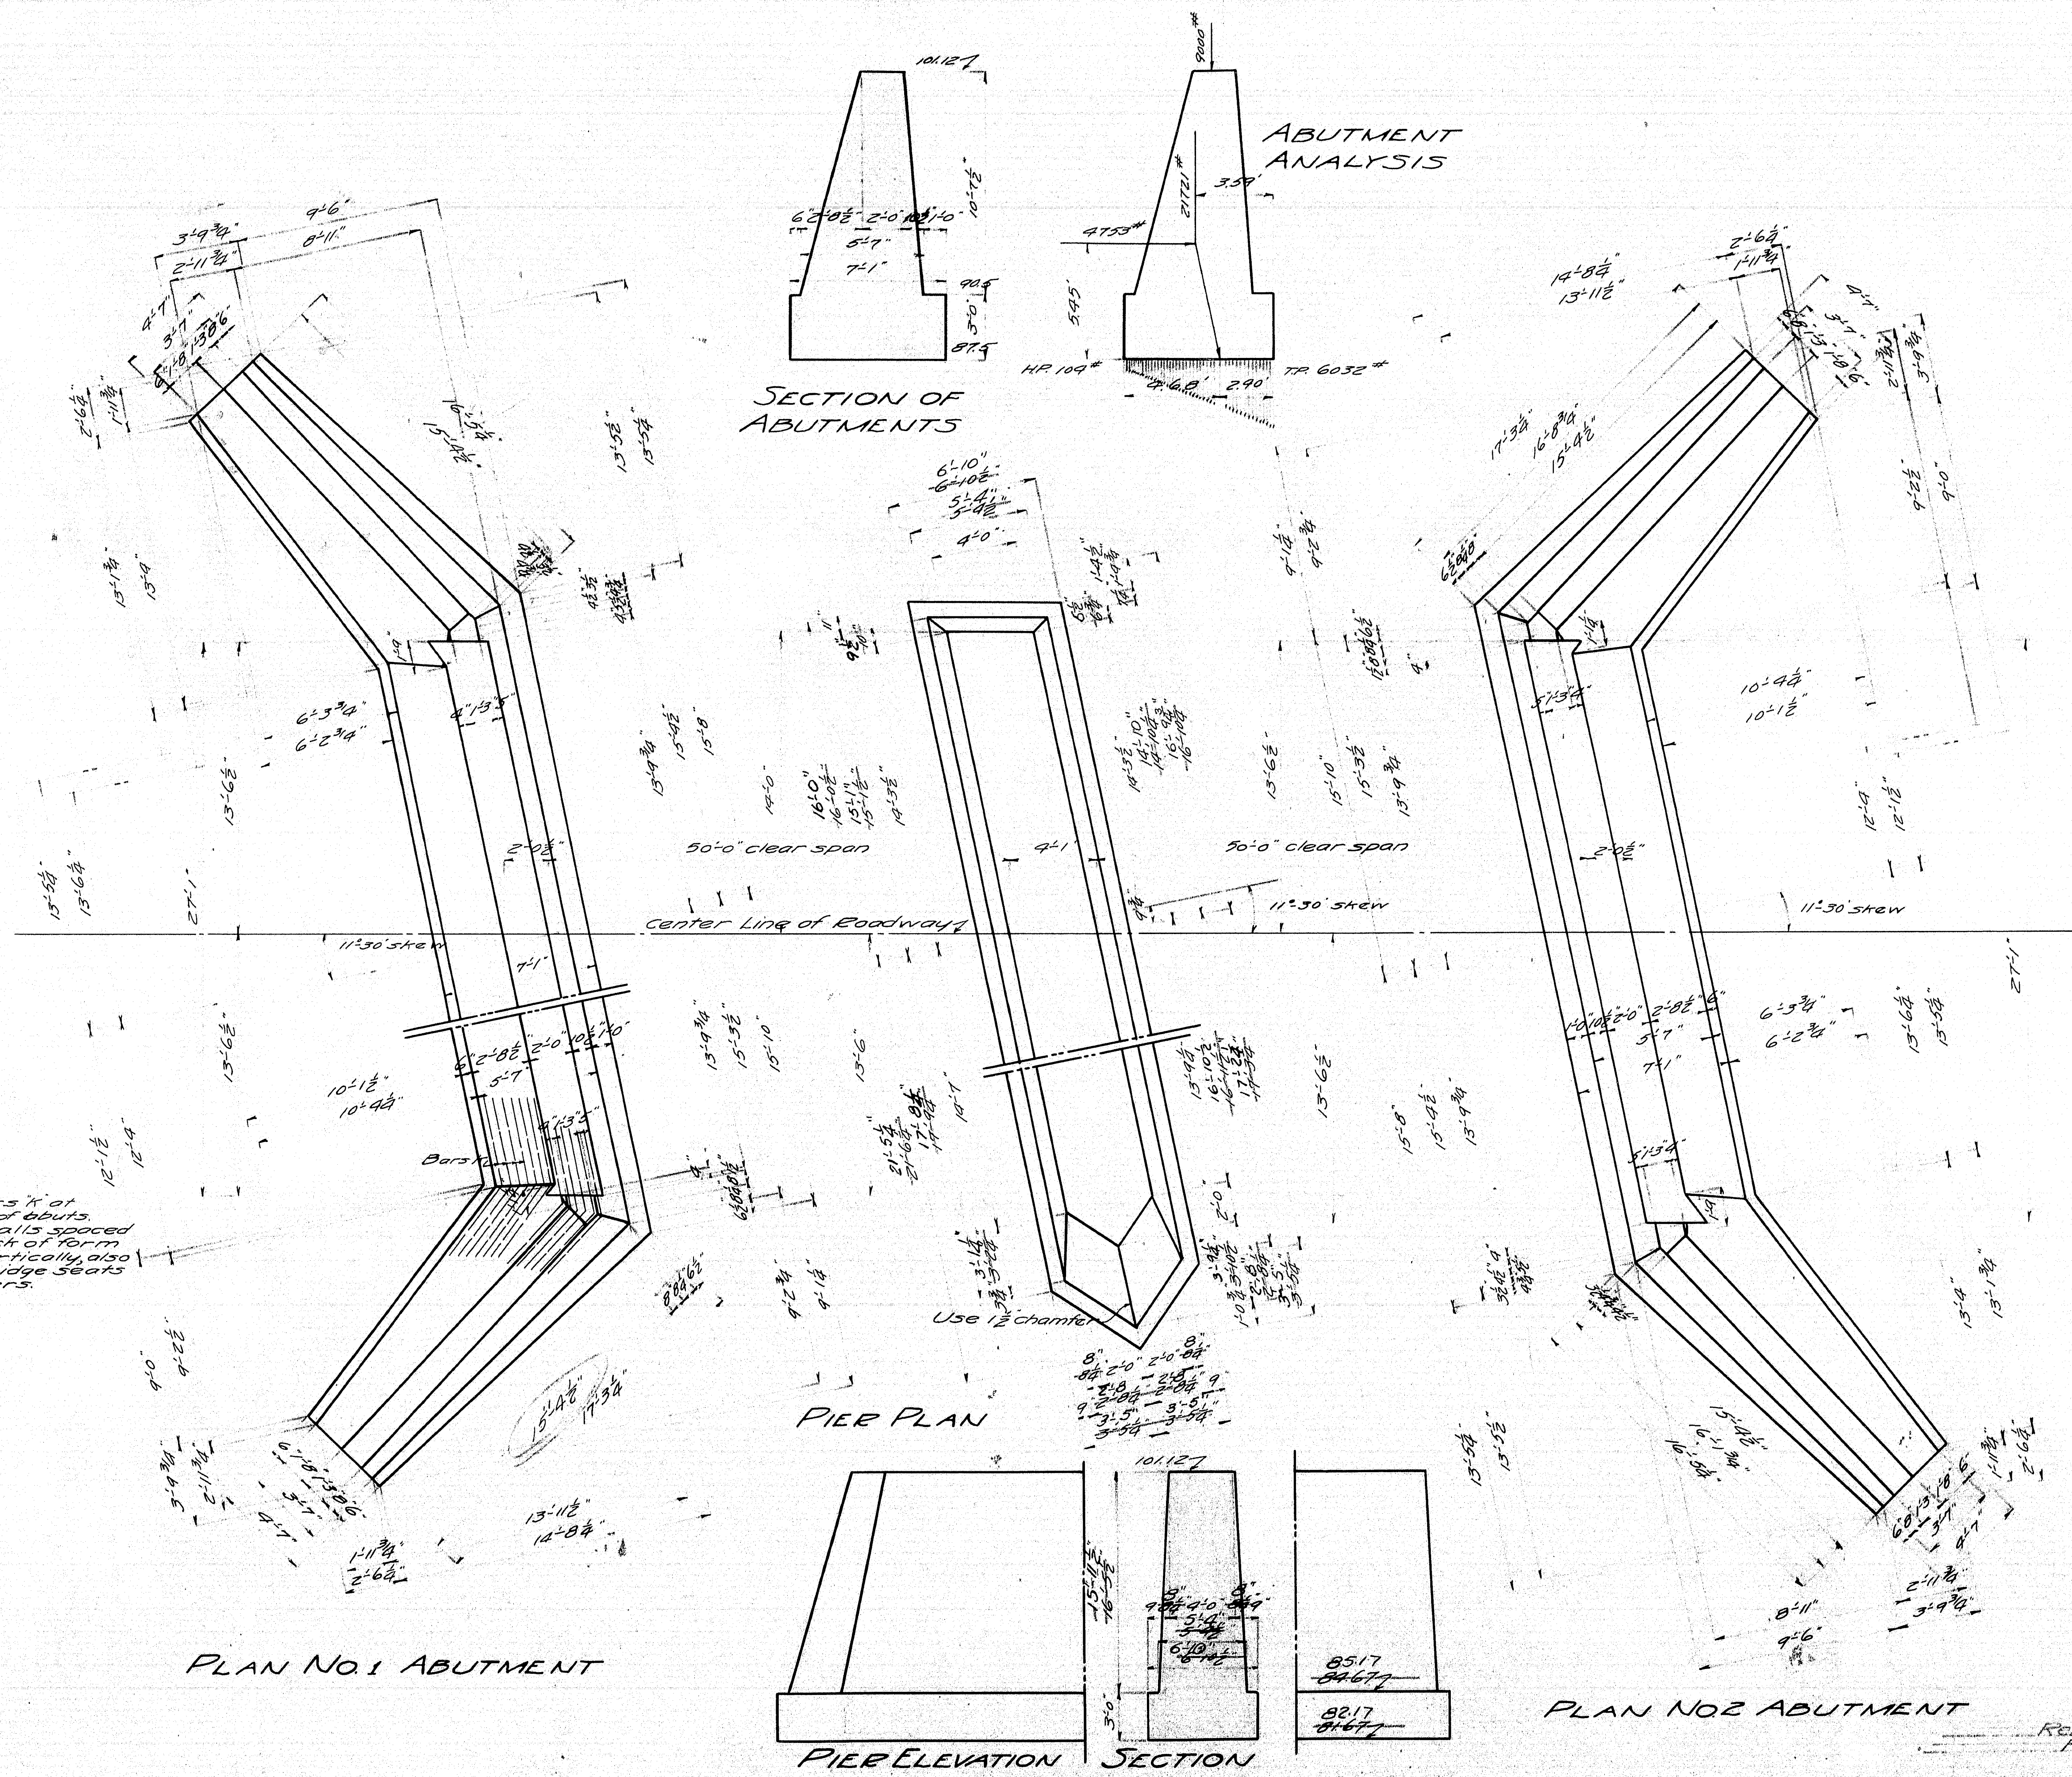

MAINE HIGHWAY COMMISSION
BRIDGE DIVISION

**BEAR RIVER
BRIDGE**







IN THE TOWN OF
NEWRY

OXFORD COUNTY

SUBSTRUCTURE

Sheet 2 of 3 August 16, Mar. 16, 29

Revised as built
Feb. 10, 1930
E.E.B.

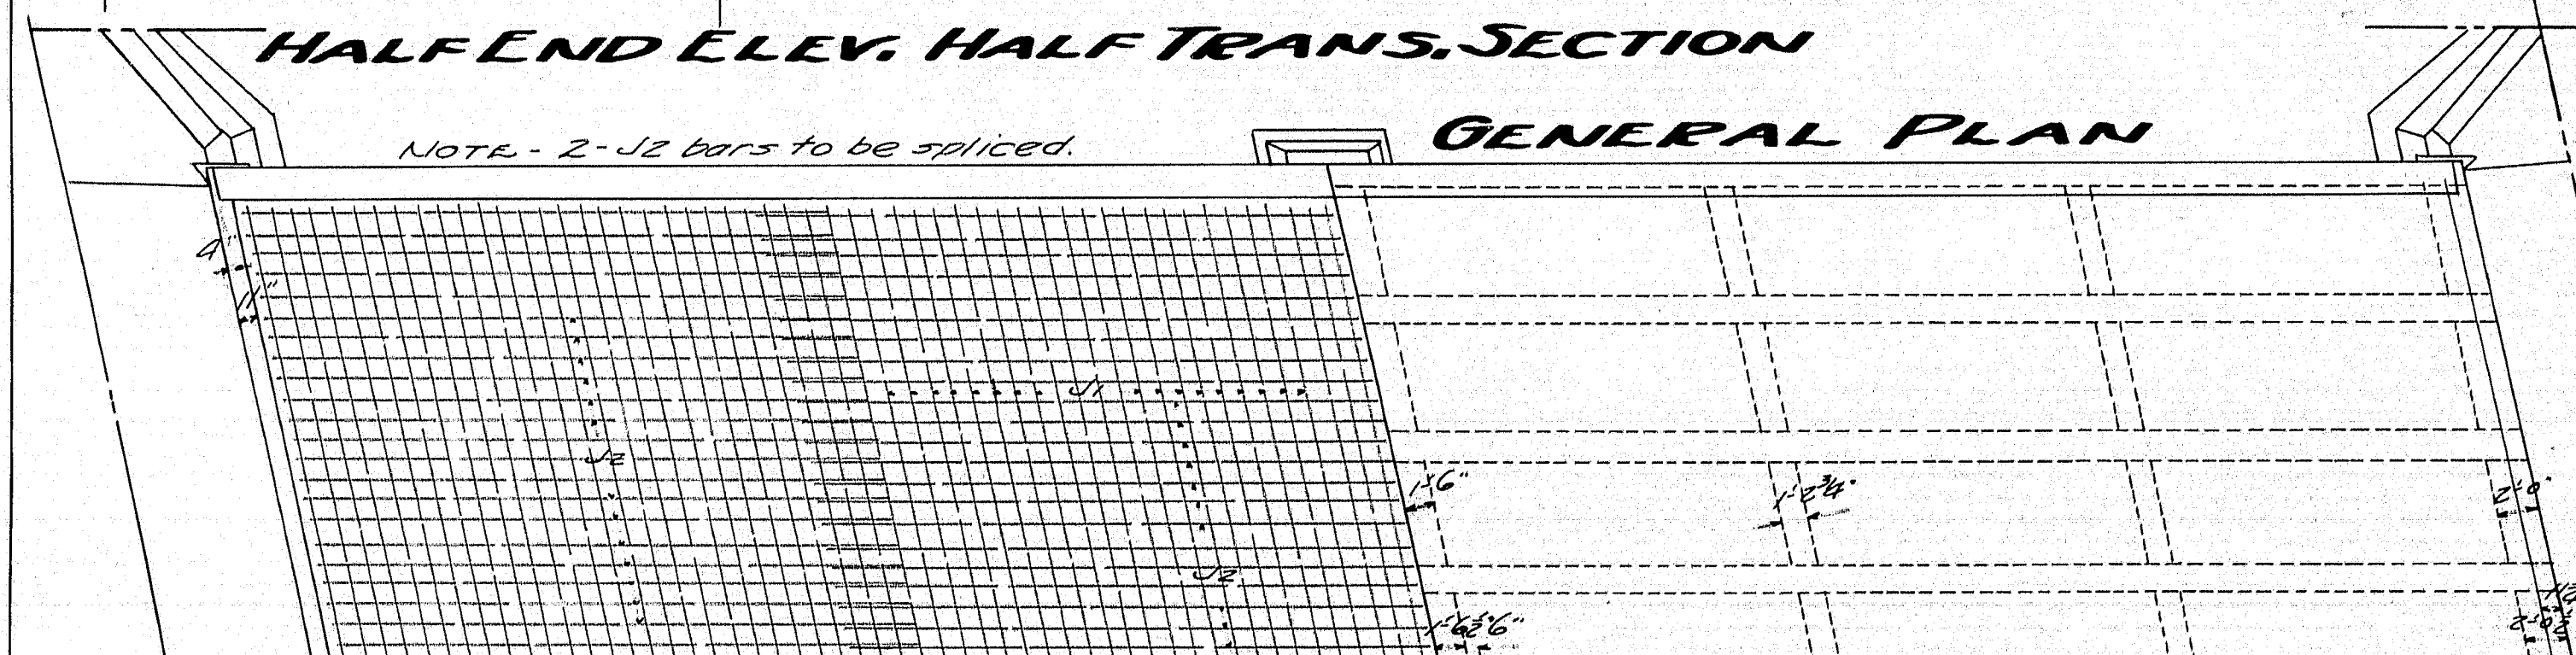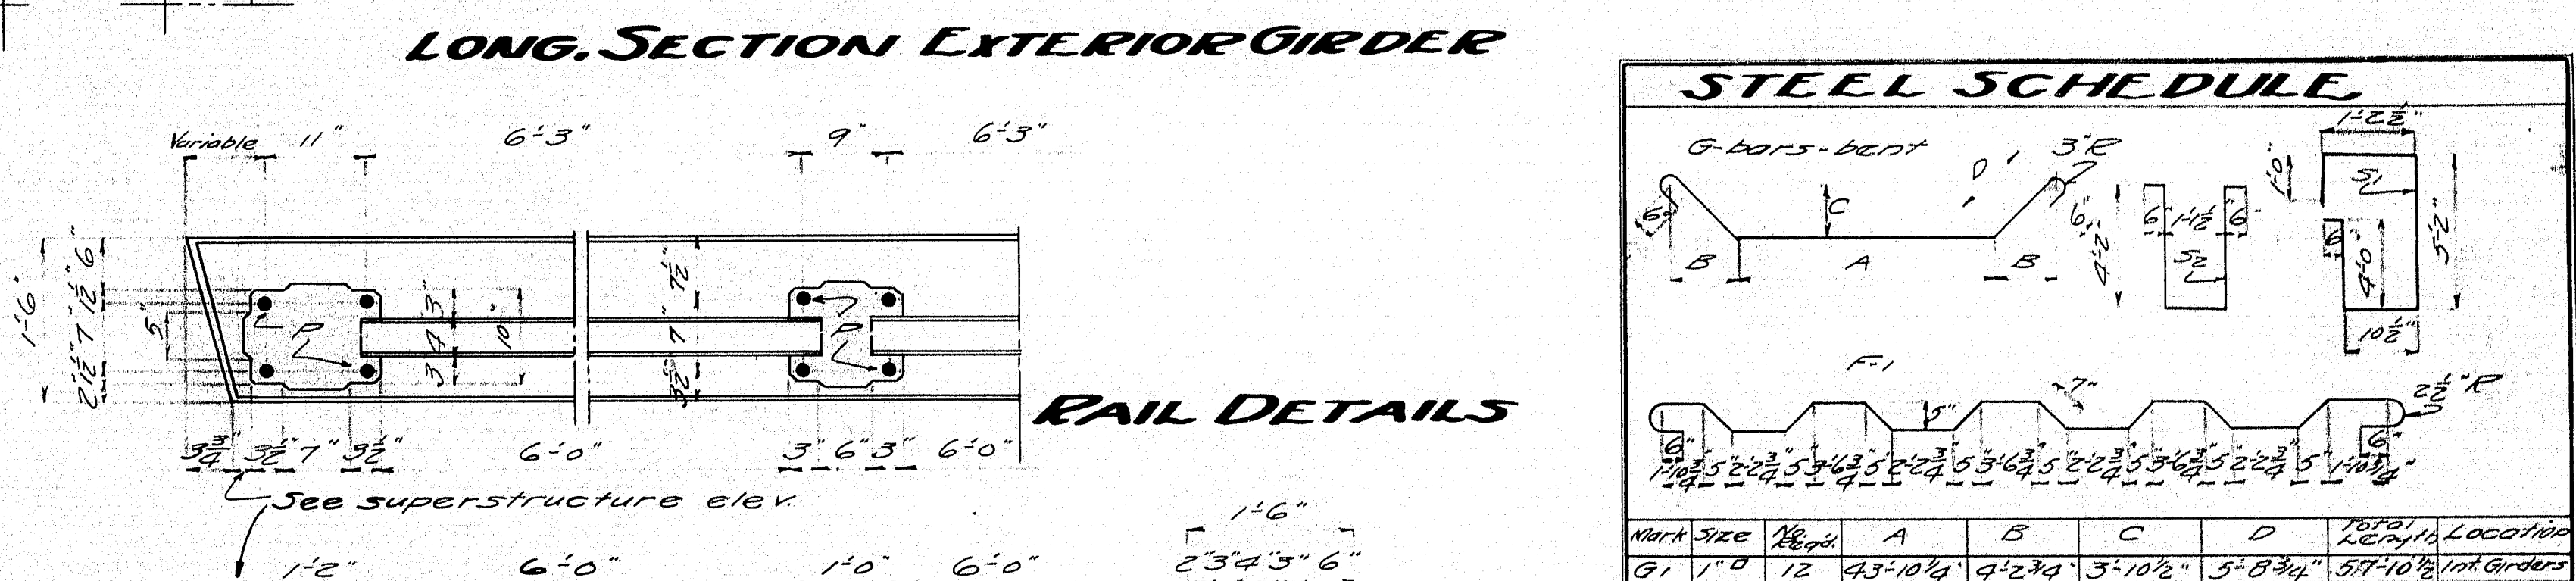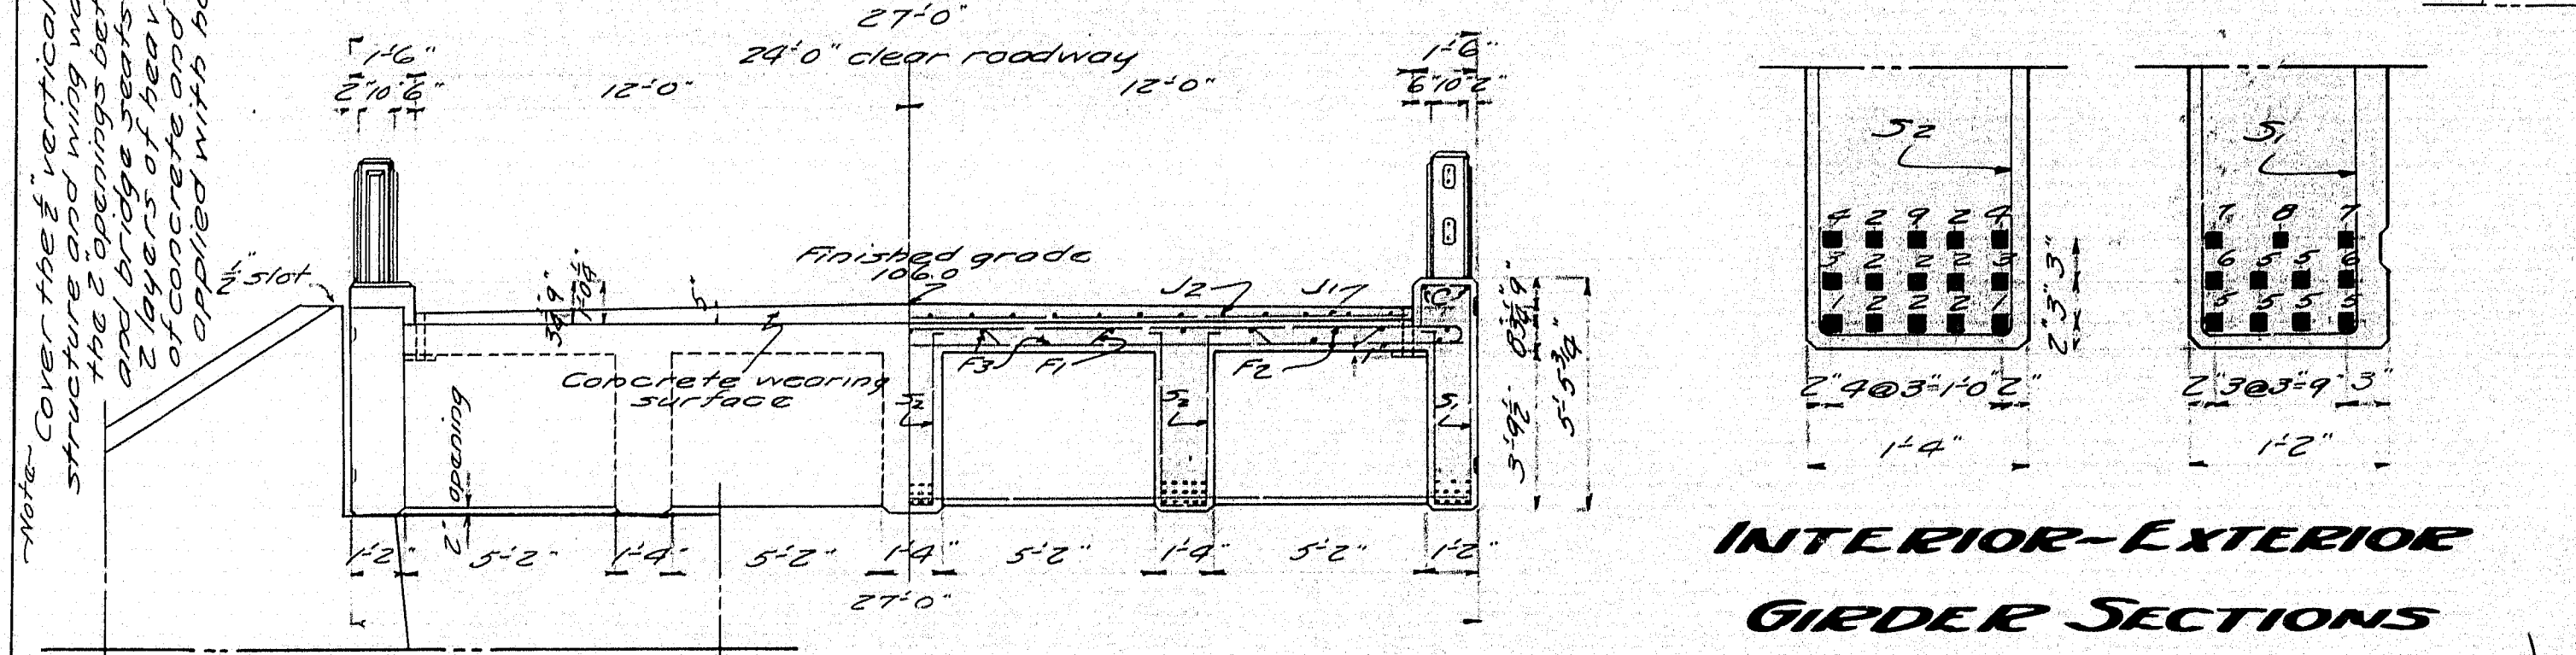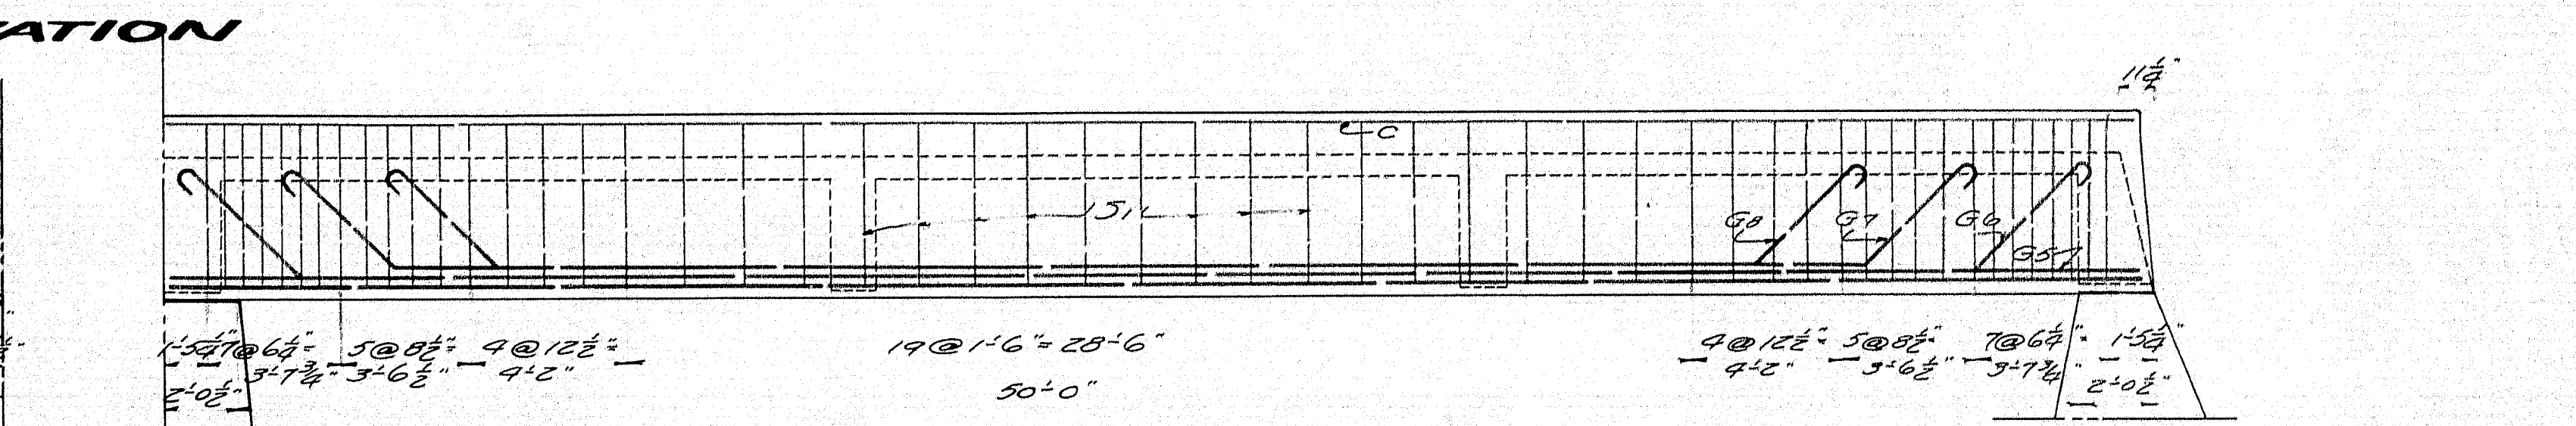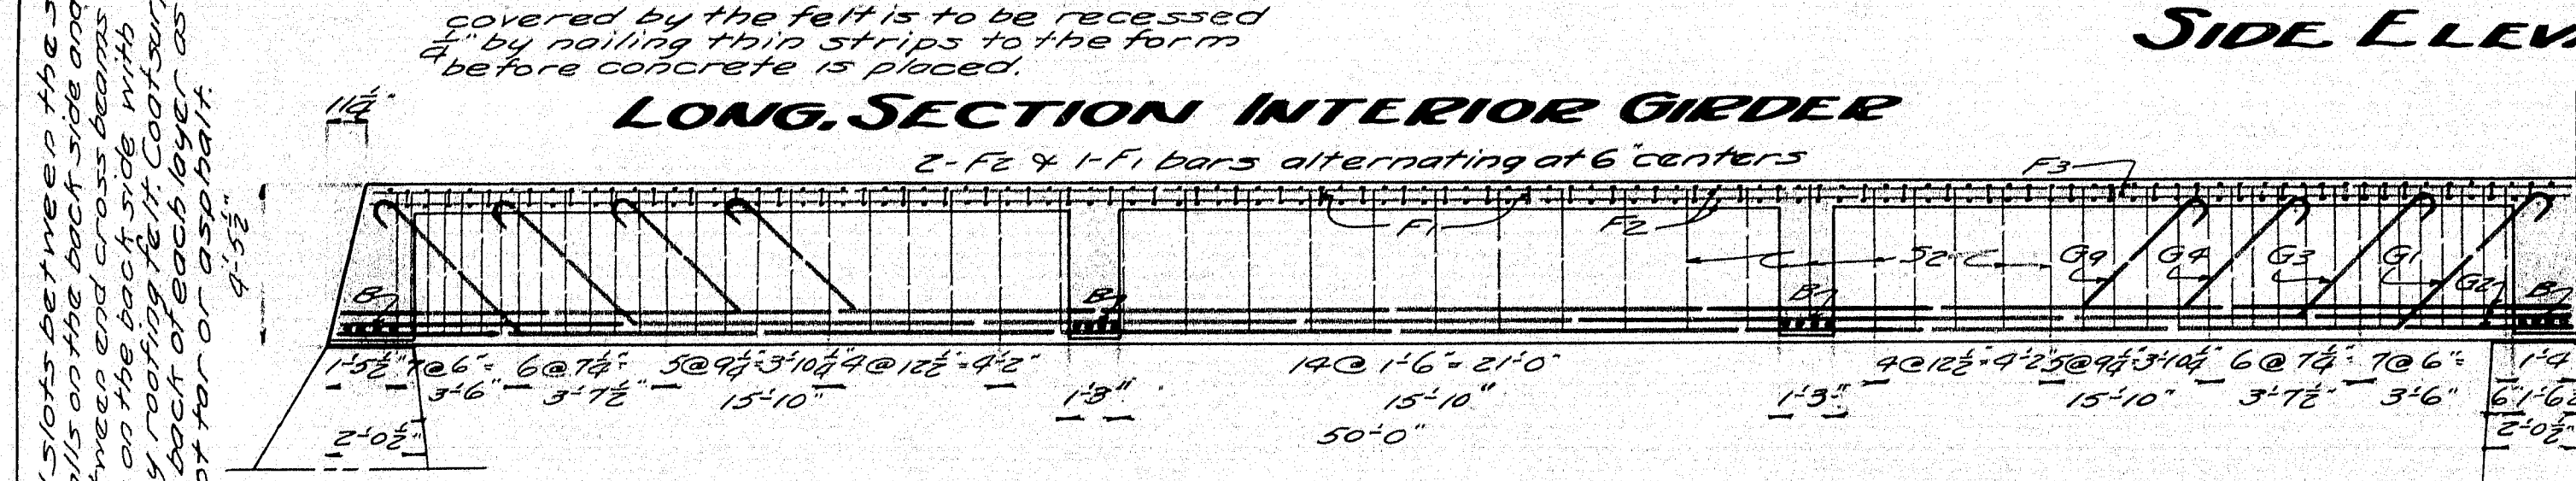
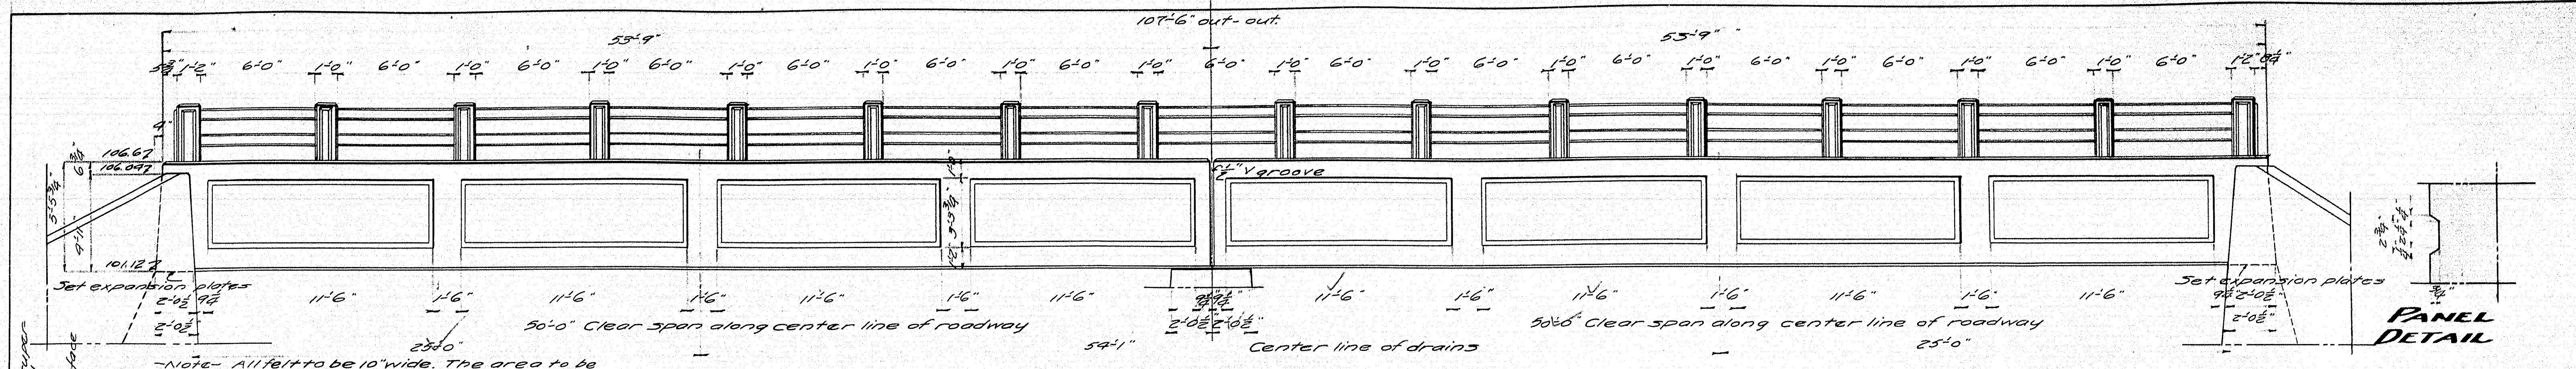


STEEL SCHEDULE

Mark	Size	No.	Length	Location
G1	1" x 12"	12	43'-10 1/4"	Interior girders
G3	1" x 12"	12	33'-4 3/4"	Interior girders
G4	1" x 12"	12	27'-4 3/4"	Interior girders
G6	1" x 12"	8	44'-4 3/4"	Interior girders
G7	1" x 12"	8	36'-4 3/4"	Interior girders
G8	1" x 12"	8	28'-1 1/4"	Interior girders
G9	1" x 12"	6	19'-10 3/4"	Interior girders
G2	1" x 12"	48	53'-7"	Exterior girders
G5	1" x 12"	24	63'-7"	Exterior girders
F1	3/8" x 10"	104	30'-4 1/2"	Slab
F2	3/8" x 10"	212	27'-2"	Slab
F3	3/8" x 10"	38	52'-10"	Slab
C	1/2" x 8"	8	53'-6"	Curbs
U	3/8" x 10"	106	24'-1"	Wearing surface
J2	3/8" x 10"	96	27'-1"	Posts
E	3/8" x 10"	240	6'-0"	Ends
K	3/8" x 10"	32	9'-0"	Abut. & Wings
S1	3/8" x 10"	208	12'-9"	Ext. Girders
S2	3/8" x 10"	354	10'-5 1/2"	Int. Girders
B	1" x 12"	32	27'-0"	Cross beams

NOTE: All steel (except G-bars) to be plain round. G-bars to be square. All bars will be plain and of structural grade. Dimensions are on center line of bars.


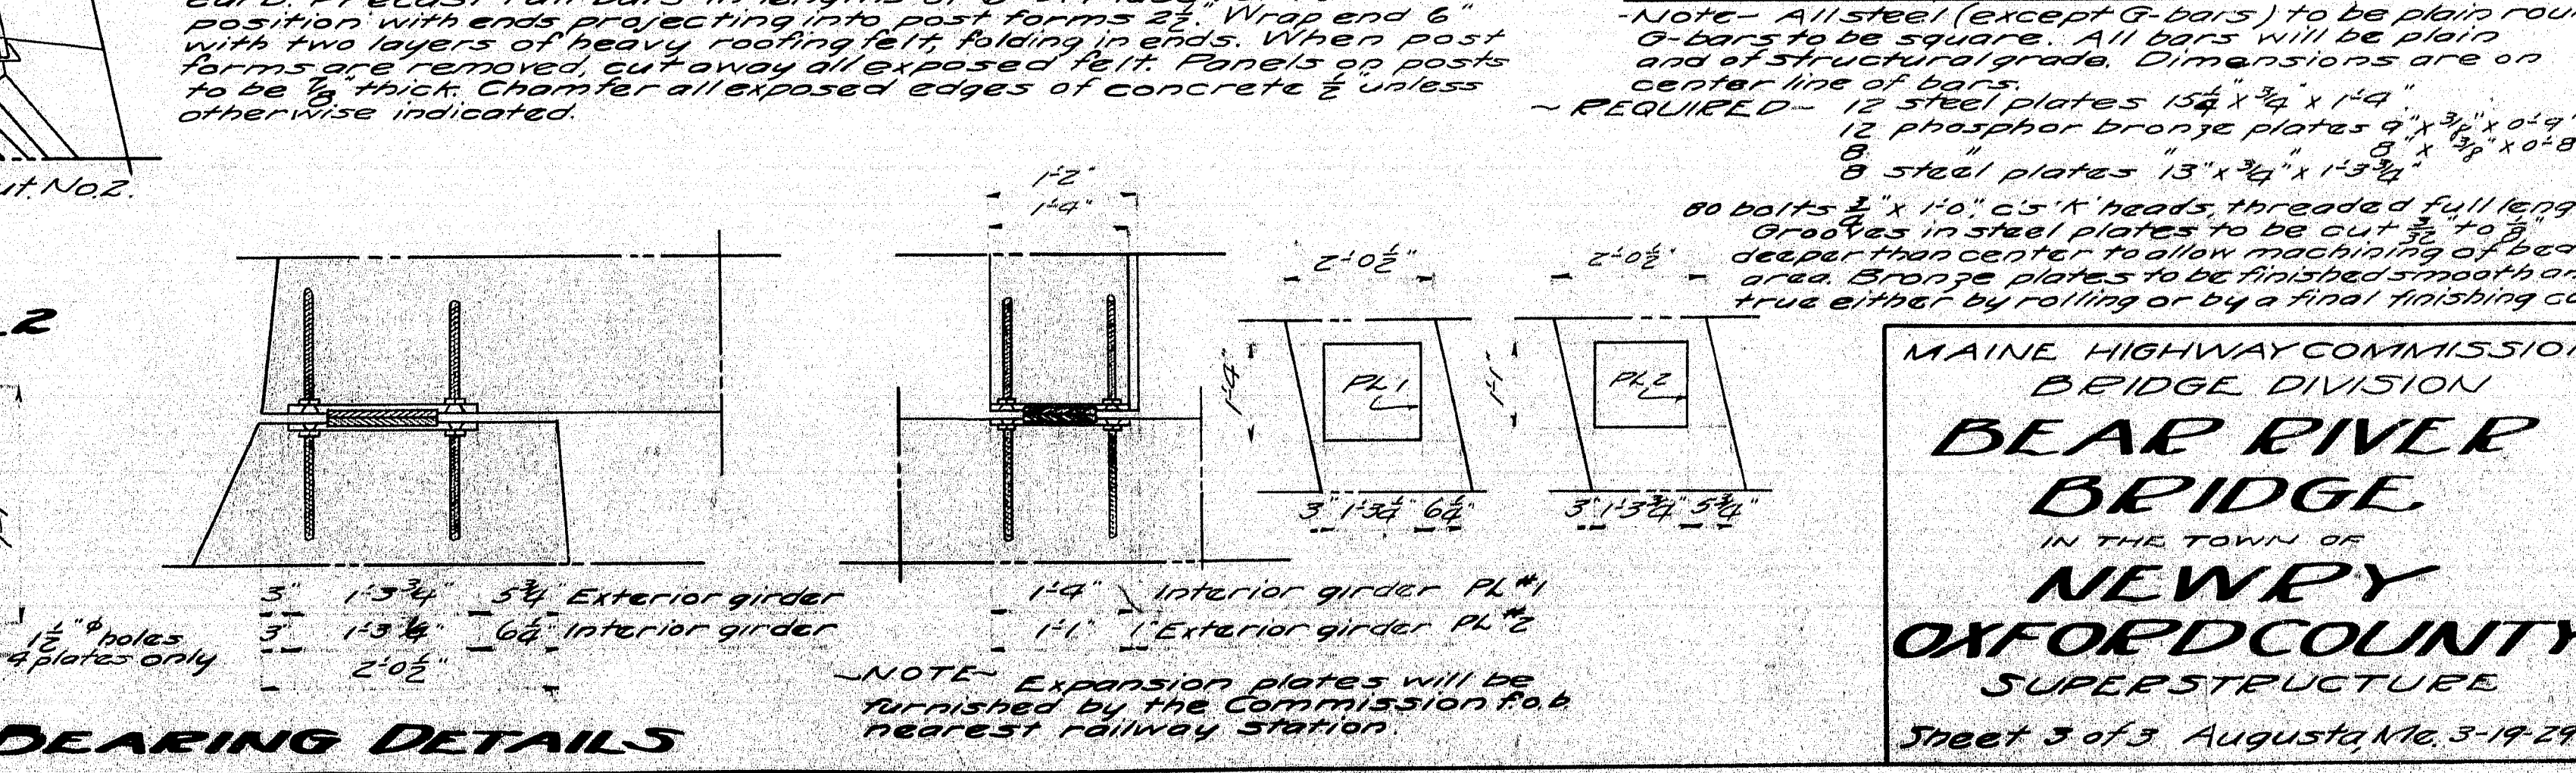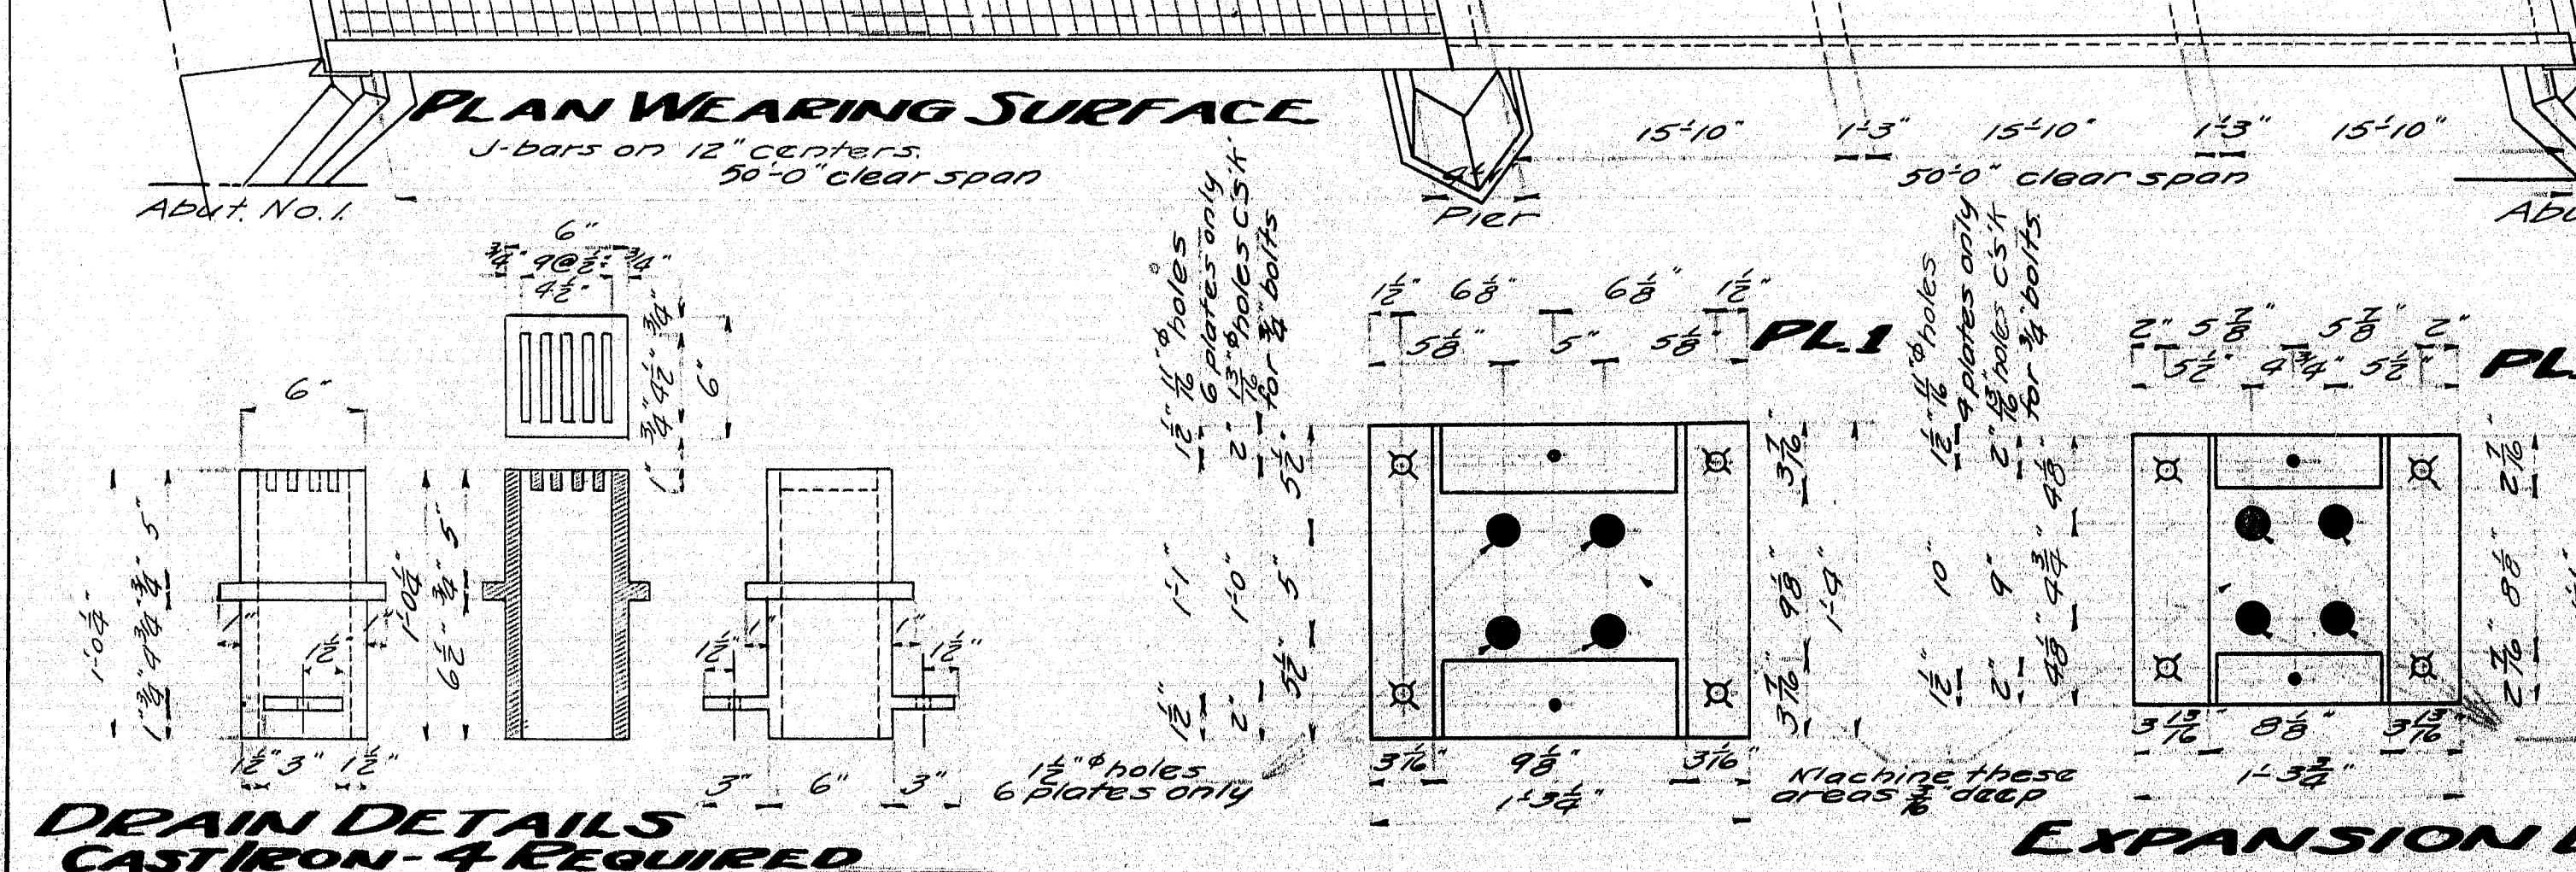

MAINE HIGHWAY COMMISSION
BRIDGE DIVISION
BEAR RIVER BRIDGE
IN THE TOWN OF
NEWRY
OXFORD COUNTY
SUPERSTRUCTURE

11-103

0 1 2 3 4 5 INCHES