FAP No.	STATE	PROJECT NUMBER	SHEET NO.	TOTAL SHEETS
1	MAINE	BH-043-1(34)	23	49

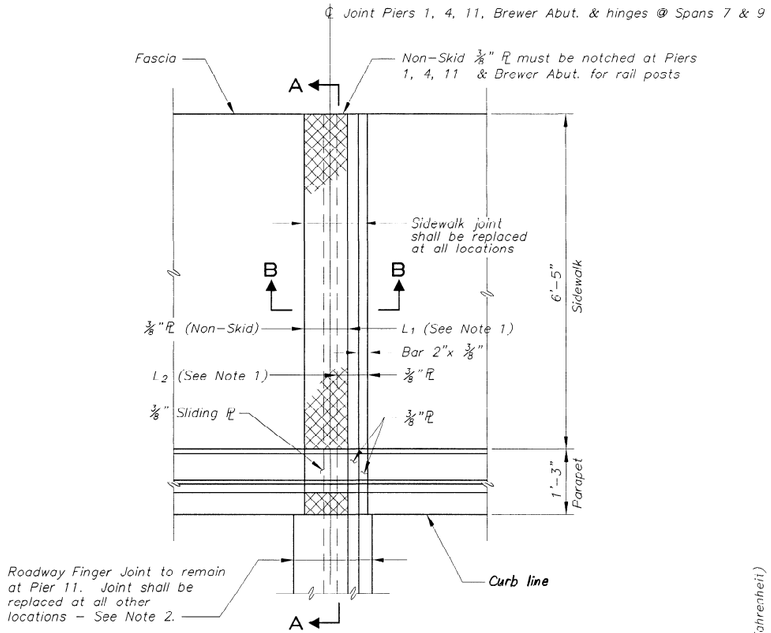

PLAN

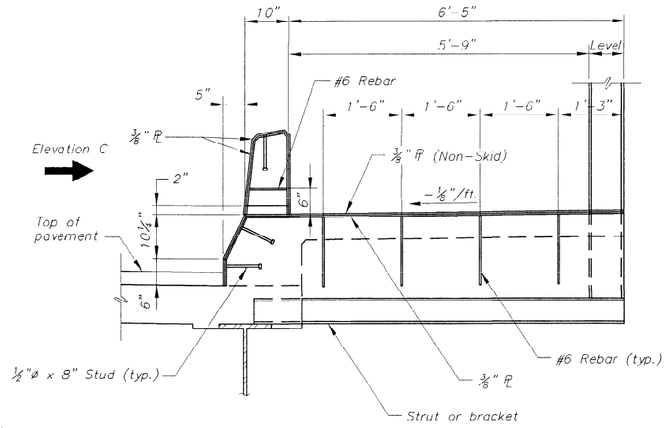

SECTION A-A

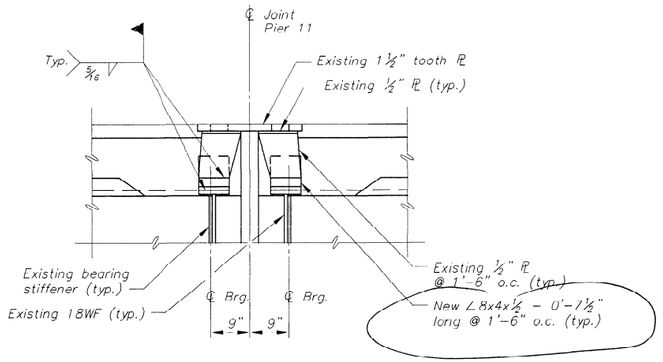

1½" PL added to top existing fingers

TYPICAL ROADWAY SECTION @ PIER 11

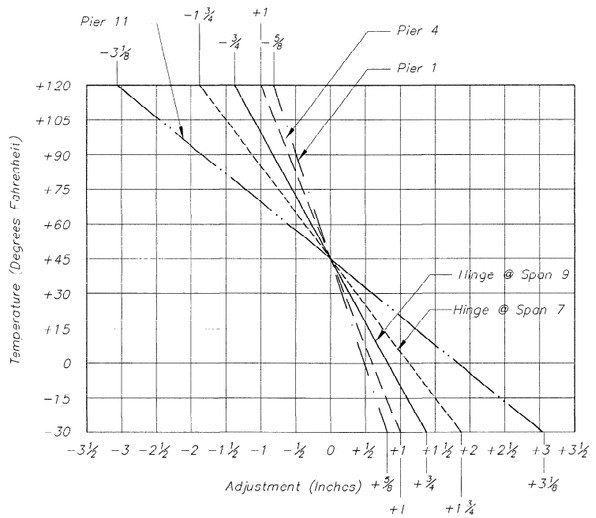

SEAL ADJUSTMENT CHART

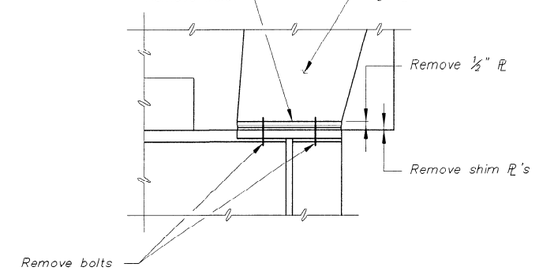

EXISTING EXPANSION JOINT REMOVAL AT PIER 11

DETAIL A

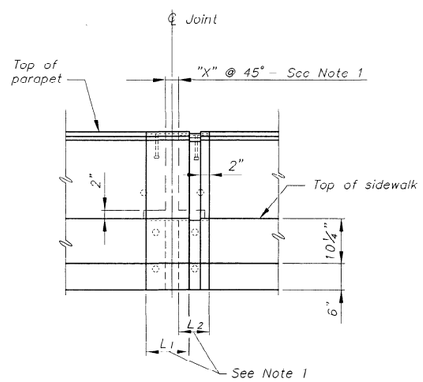

ELEVATION C

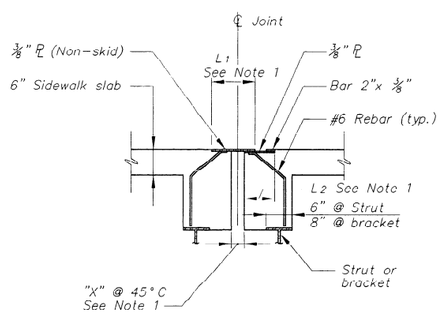

SECTION B-B

NOTES

1. Dimensions "X", L_1 & L_2 – See Standard Details BD301-93, BD302-93 and BD304-93.
2. Use Compression seal @ Pier 1, Pier 4 and Hinge at Span 9 – See BD301-93. Use Gland Seal @ Brewer Abutment and Hinge at Span 7 – See BD302-93.

As Built 1998

STATE OF MAINE
DEPARTMENT OF TRANSPORTATION

JOSHUA L. CHAMBERLAIN BRIDGE
U.S. Route 1A over the Penobscot River

BANGOR/BREWER
Penobscot County

EXPANSION JOINT DETAILS

1085JC99 / 3-4 | SHEET 23 OF | AUGUSTA, MAINE | OCT. 1995