

CR16769


44.096105, -69.110622

Remove and regrade sidewalk.

Remove bituminous curb then place new tip up and tip down. (32'+/-)

DWF 2x4

Saw cut 2' from face of curb/gutterline. Base and repave after curb install.

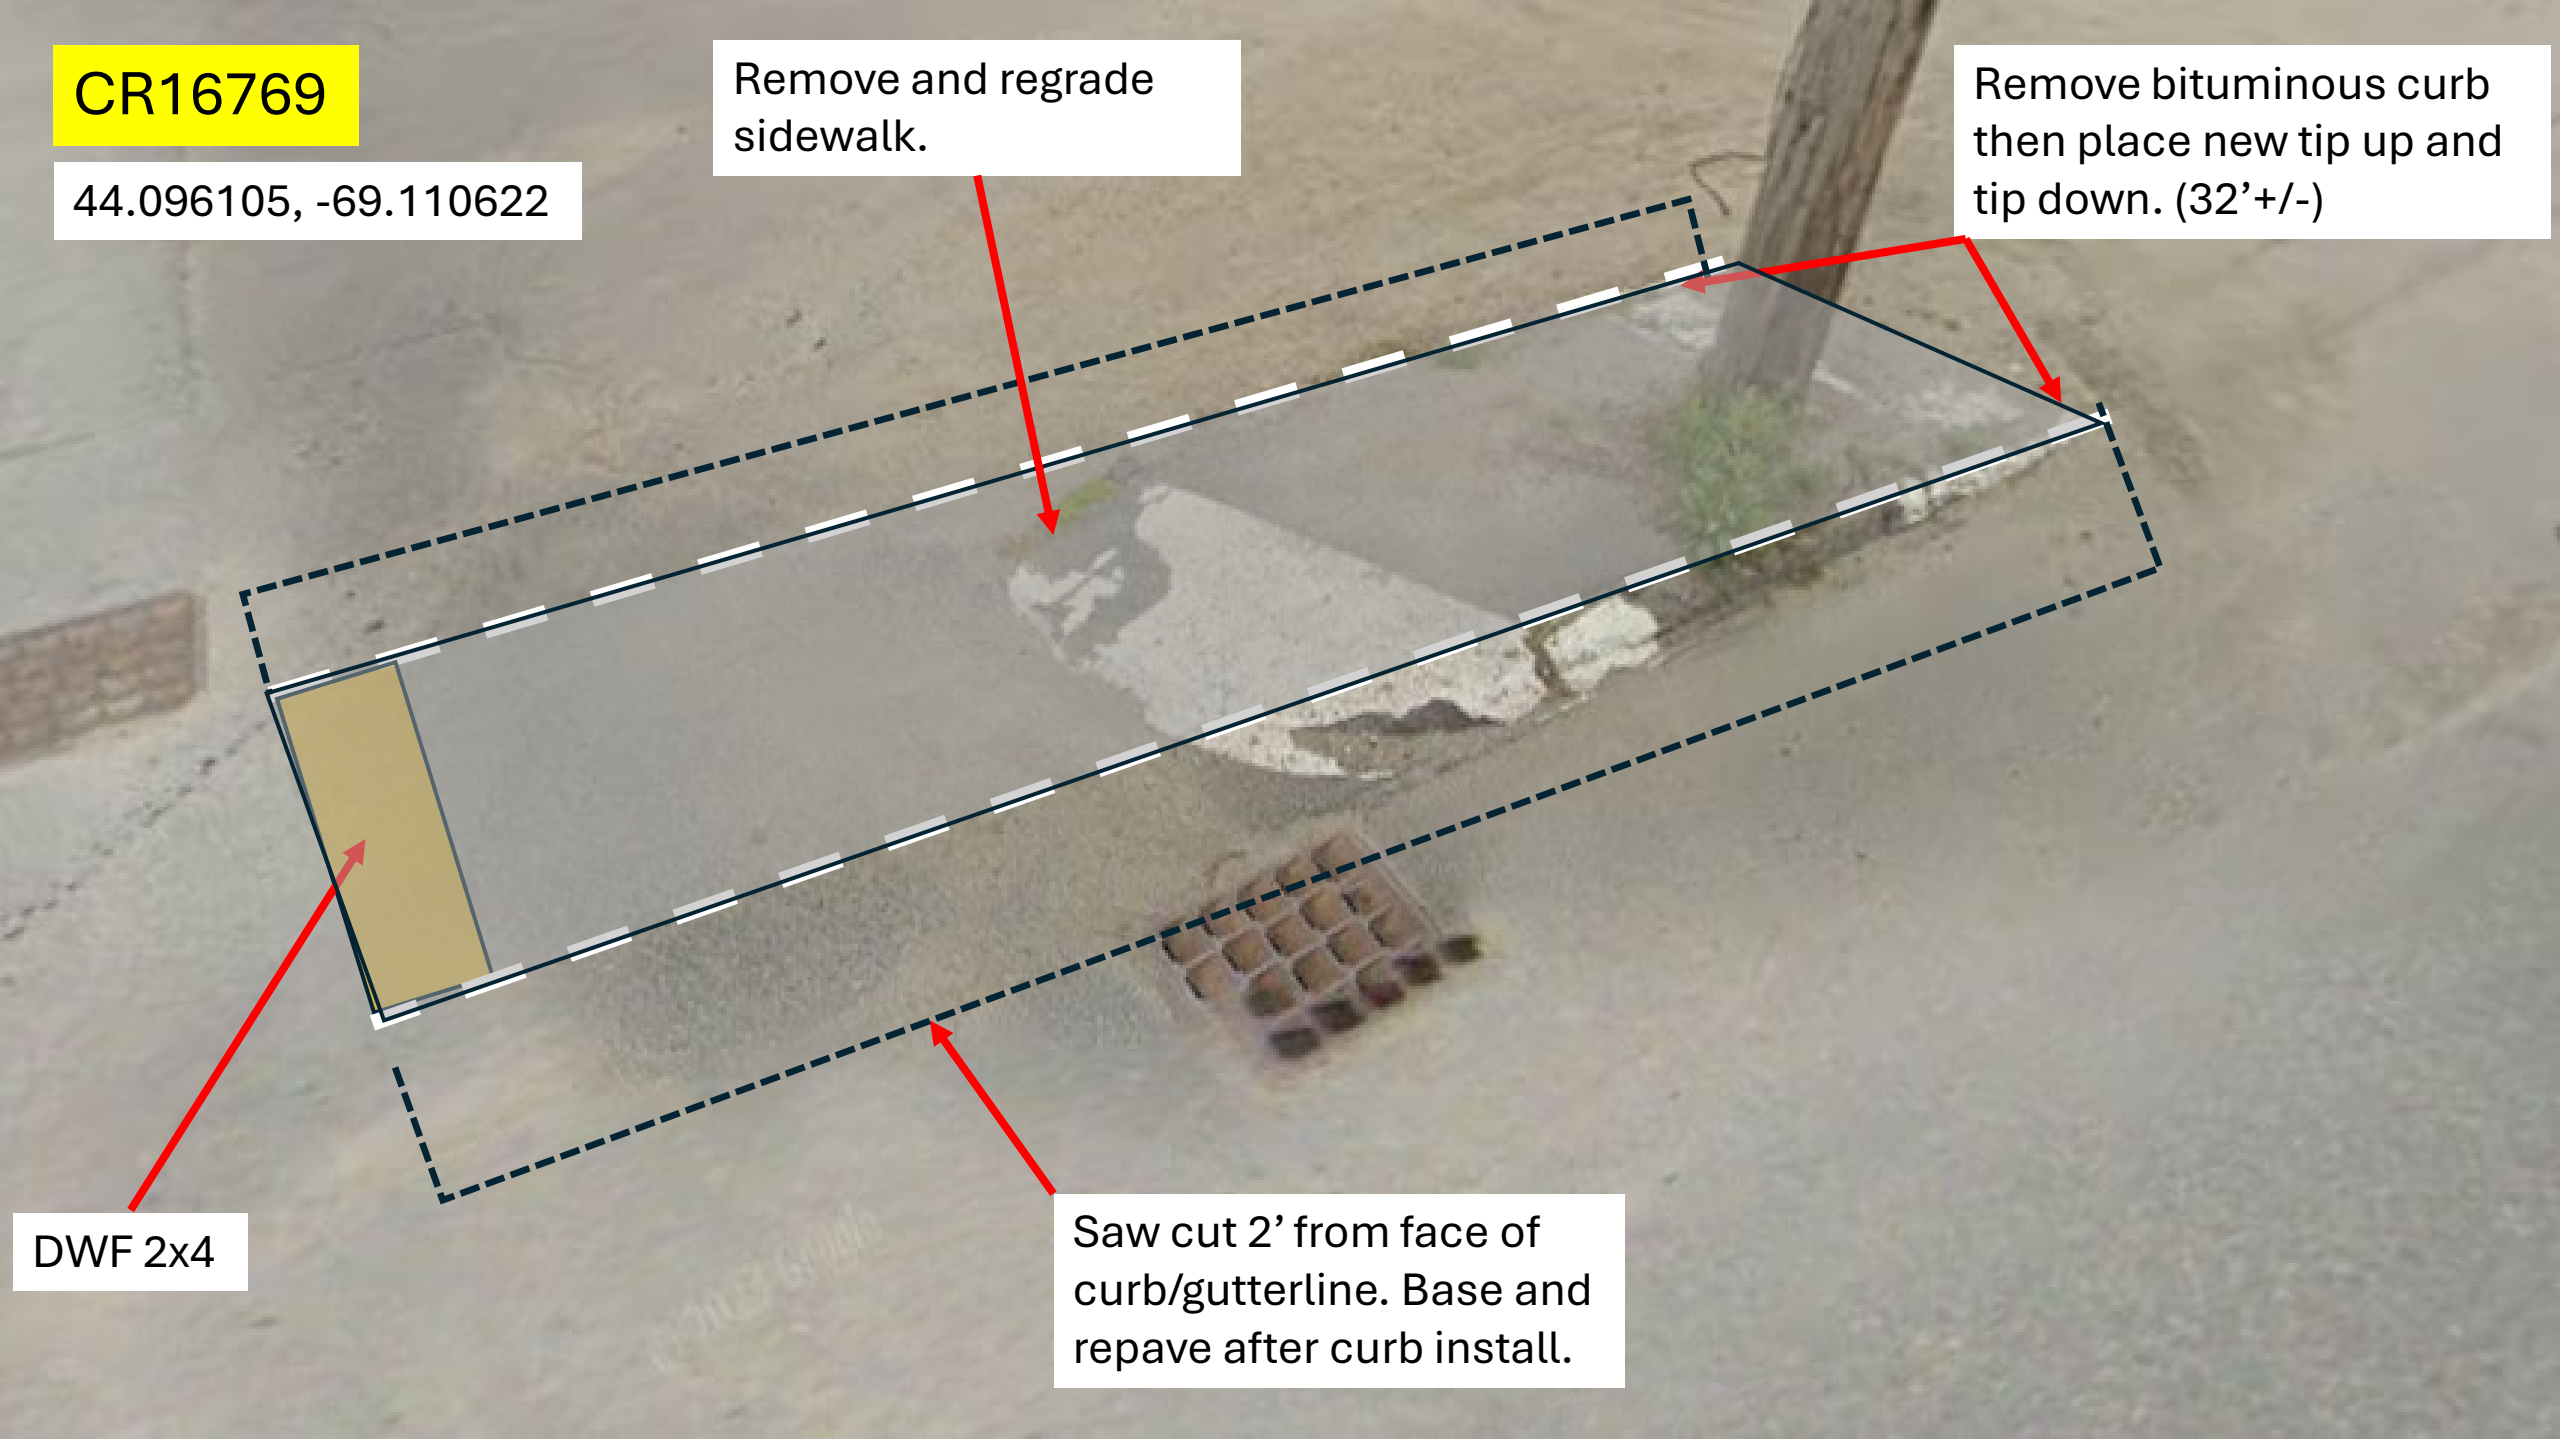

CR09031

44.09569243, -69.11066252


Remove and regrade sidewalk.

Remove 16' bituminous curb then place new tip down.

Remove 16' bituminous curb then place new tip down.

Saw cut 2' from face of curb/gutterline. Base and repave after curb install. Both sides of island.

DWF 2x4

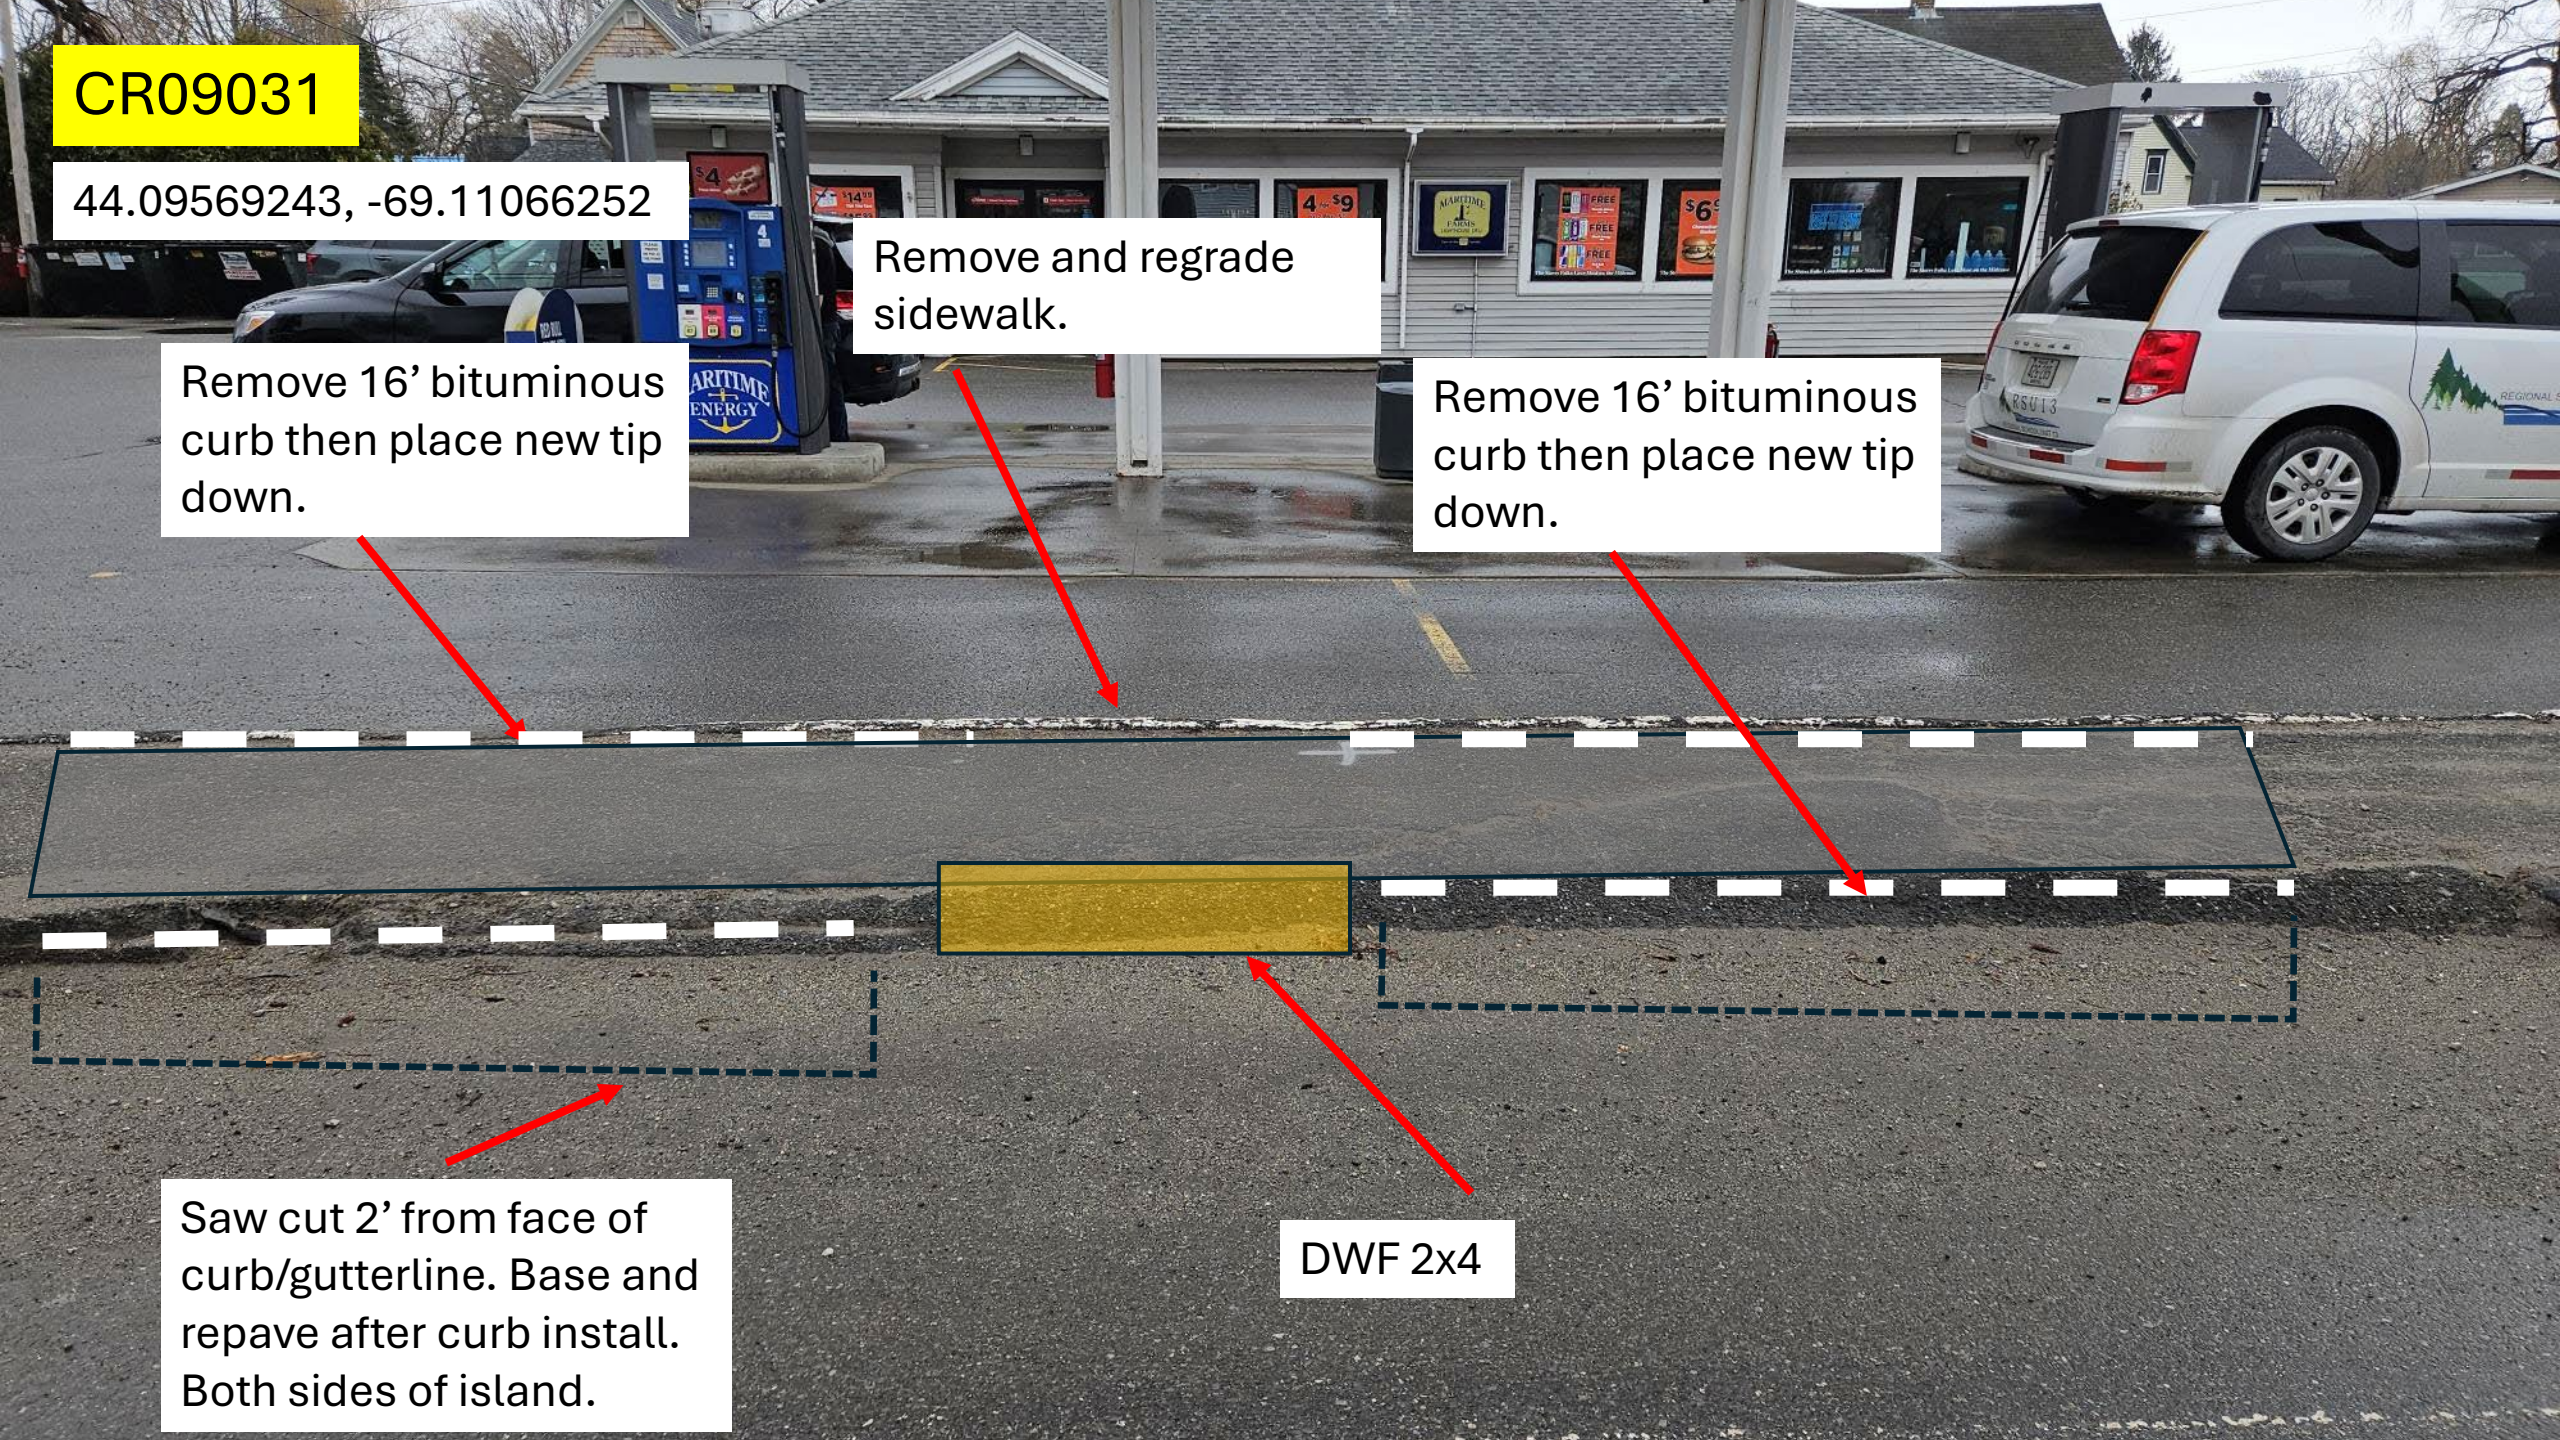

CR09033

44.0956978, -69.11072764

Remove and regrade
sidewalk.

Loam
and
seed.

DWF 2x4

Remove 16'+/-
bituminous curb then
place new tip down.

Saw cut 2' from face of
curb/gutterline. Base and
repave after curb install.

RR Crossing (North)


44.09548, -69.110616

Remove and regrade sidewalk.

DWF 2x4

Saw cut 2' from face of curb/gutterline. Base and repave after curb install.

Remove bituminous curb then place new up and tip down on both Sides of the sidewalk.

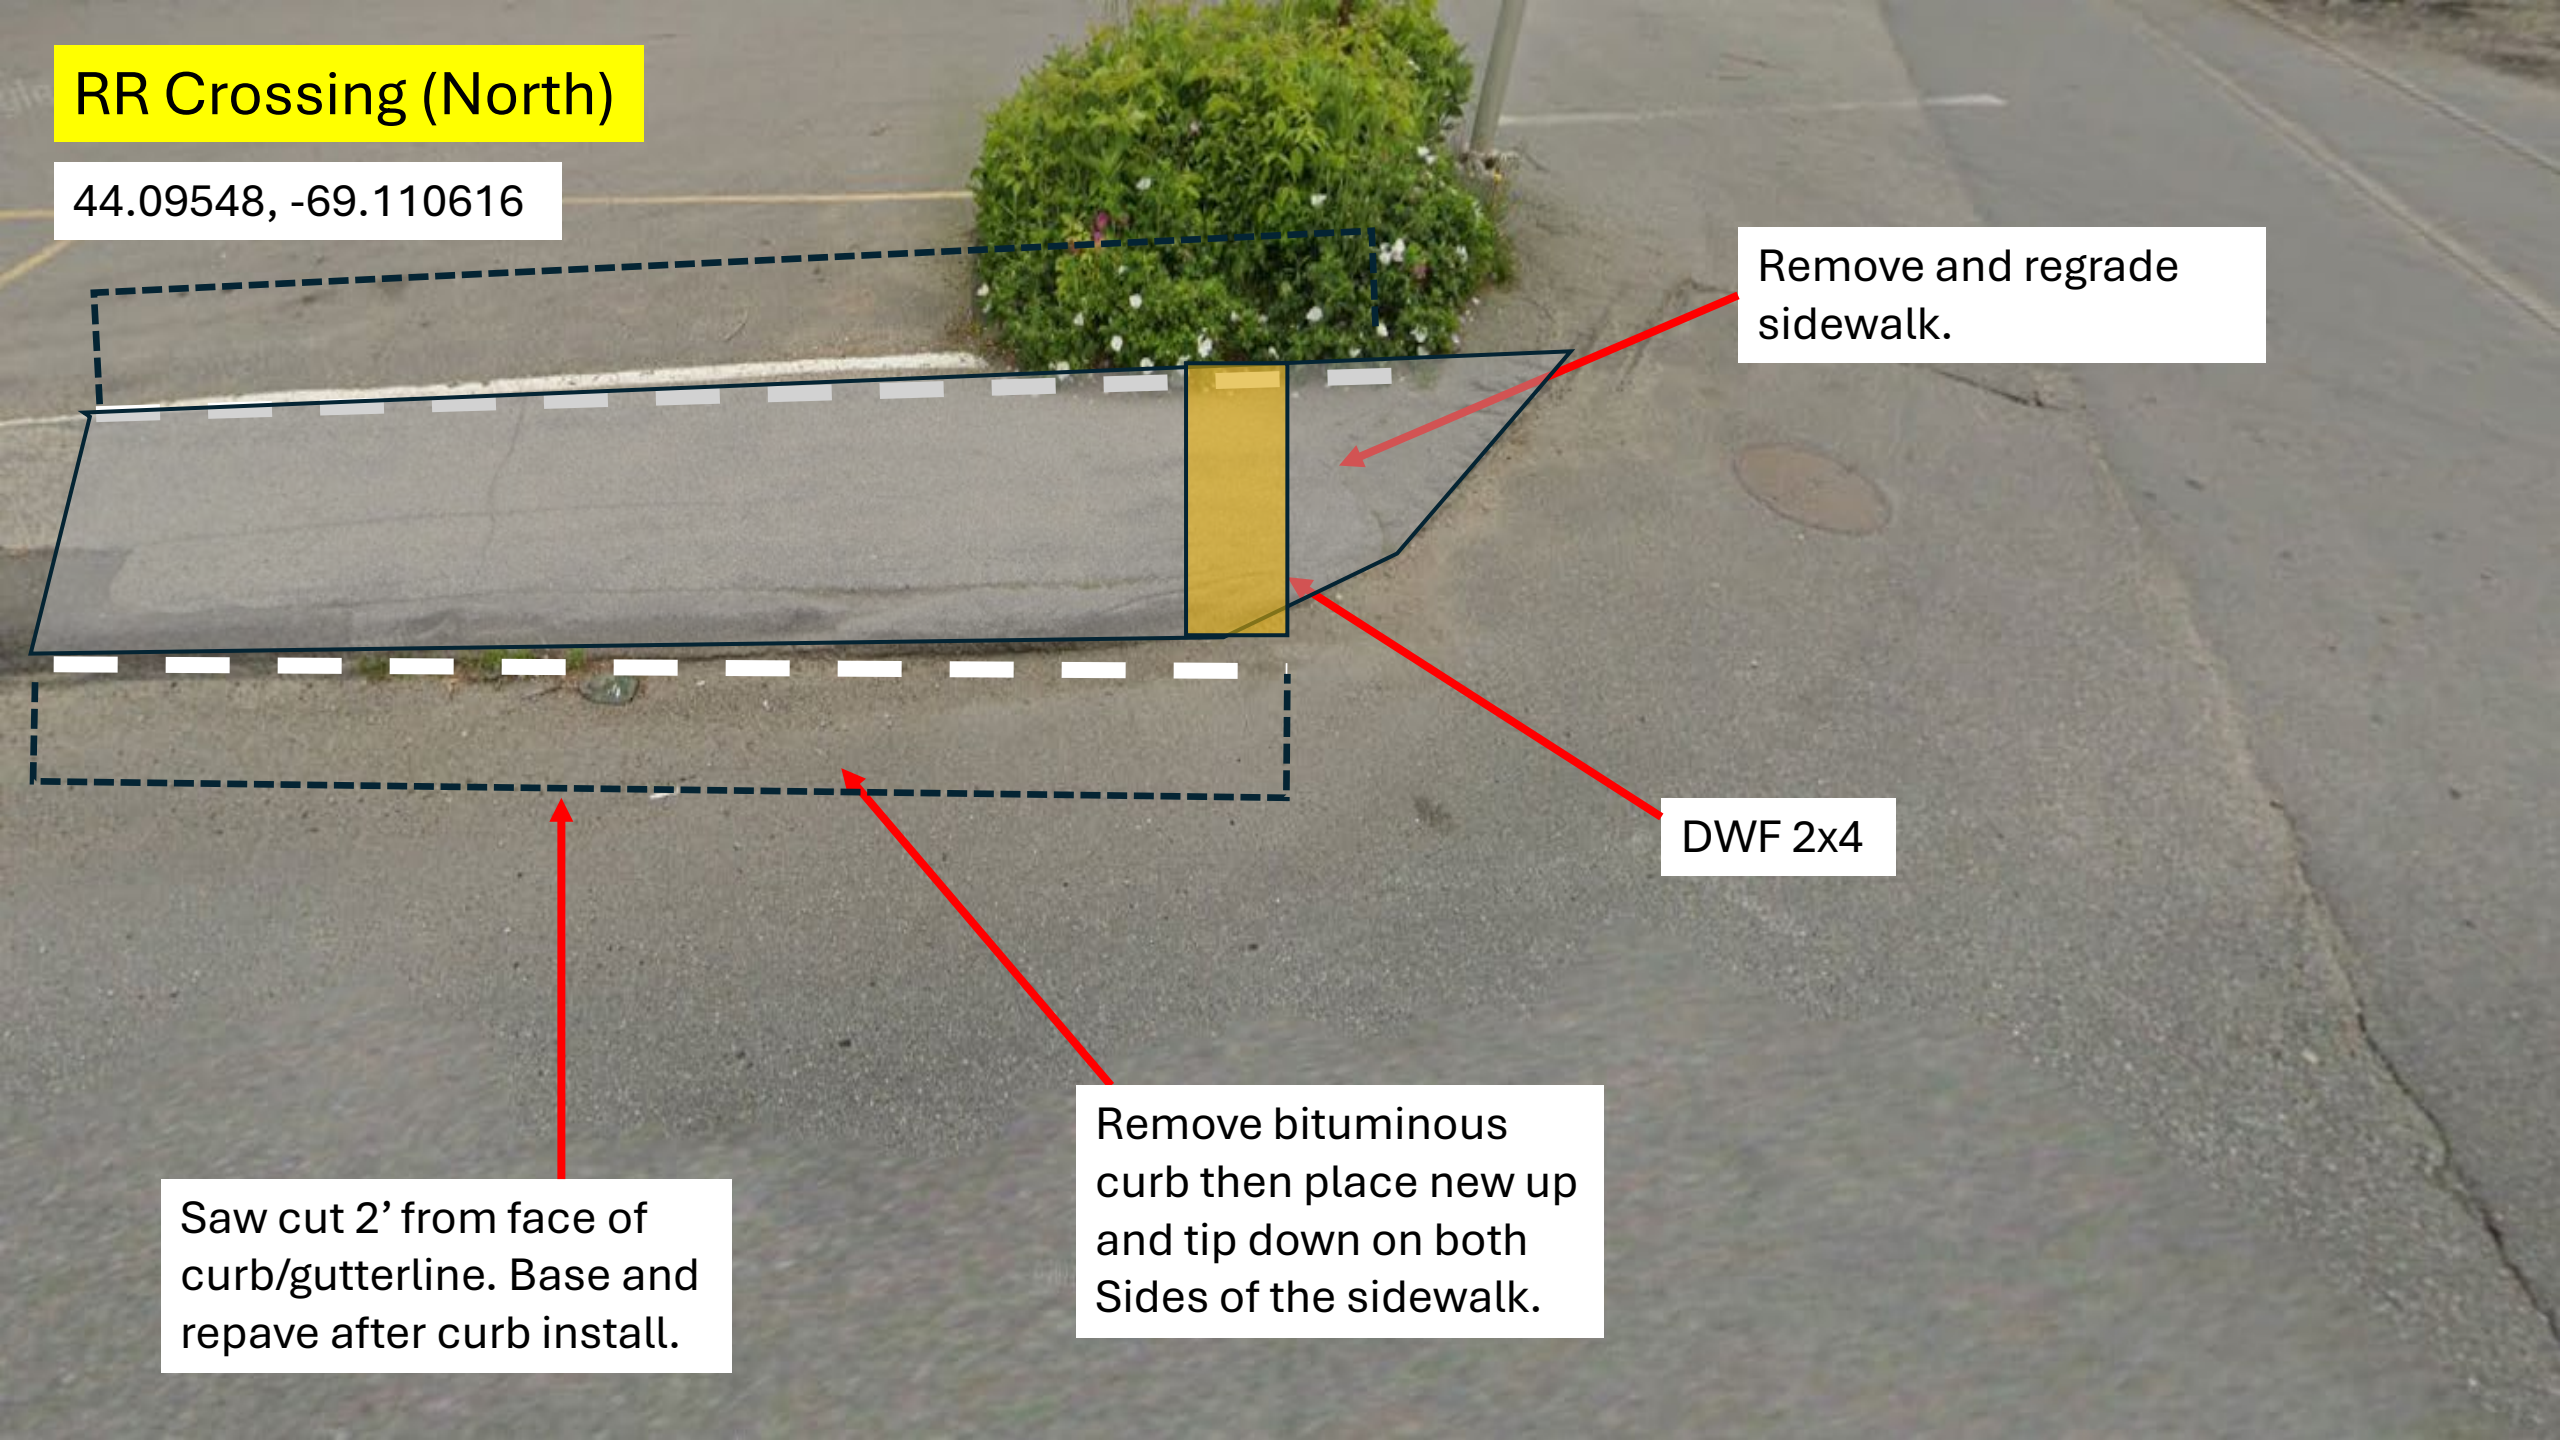

CR 09032

44.0953405, -69.110619


Remove and regrade
sidewalk.

Loam
and
seed

DWF 2x4

Remove 8' bituminous
curb then place new tip
down.

Saw cut 2' from face of
curb/gutterline. Base and
repave after curb install.

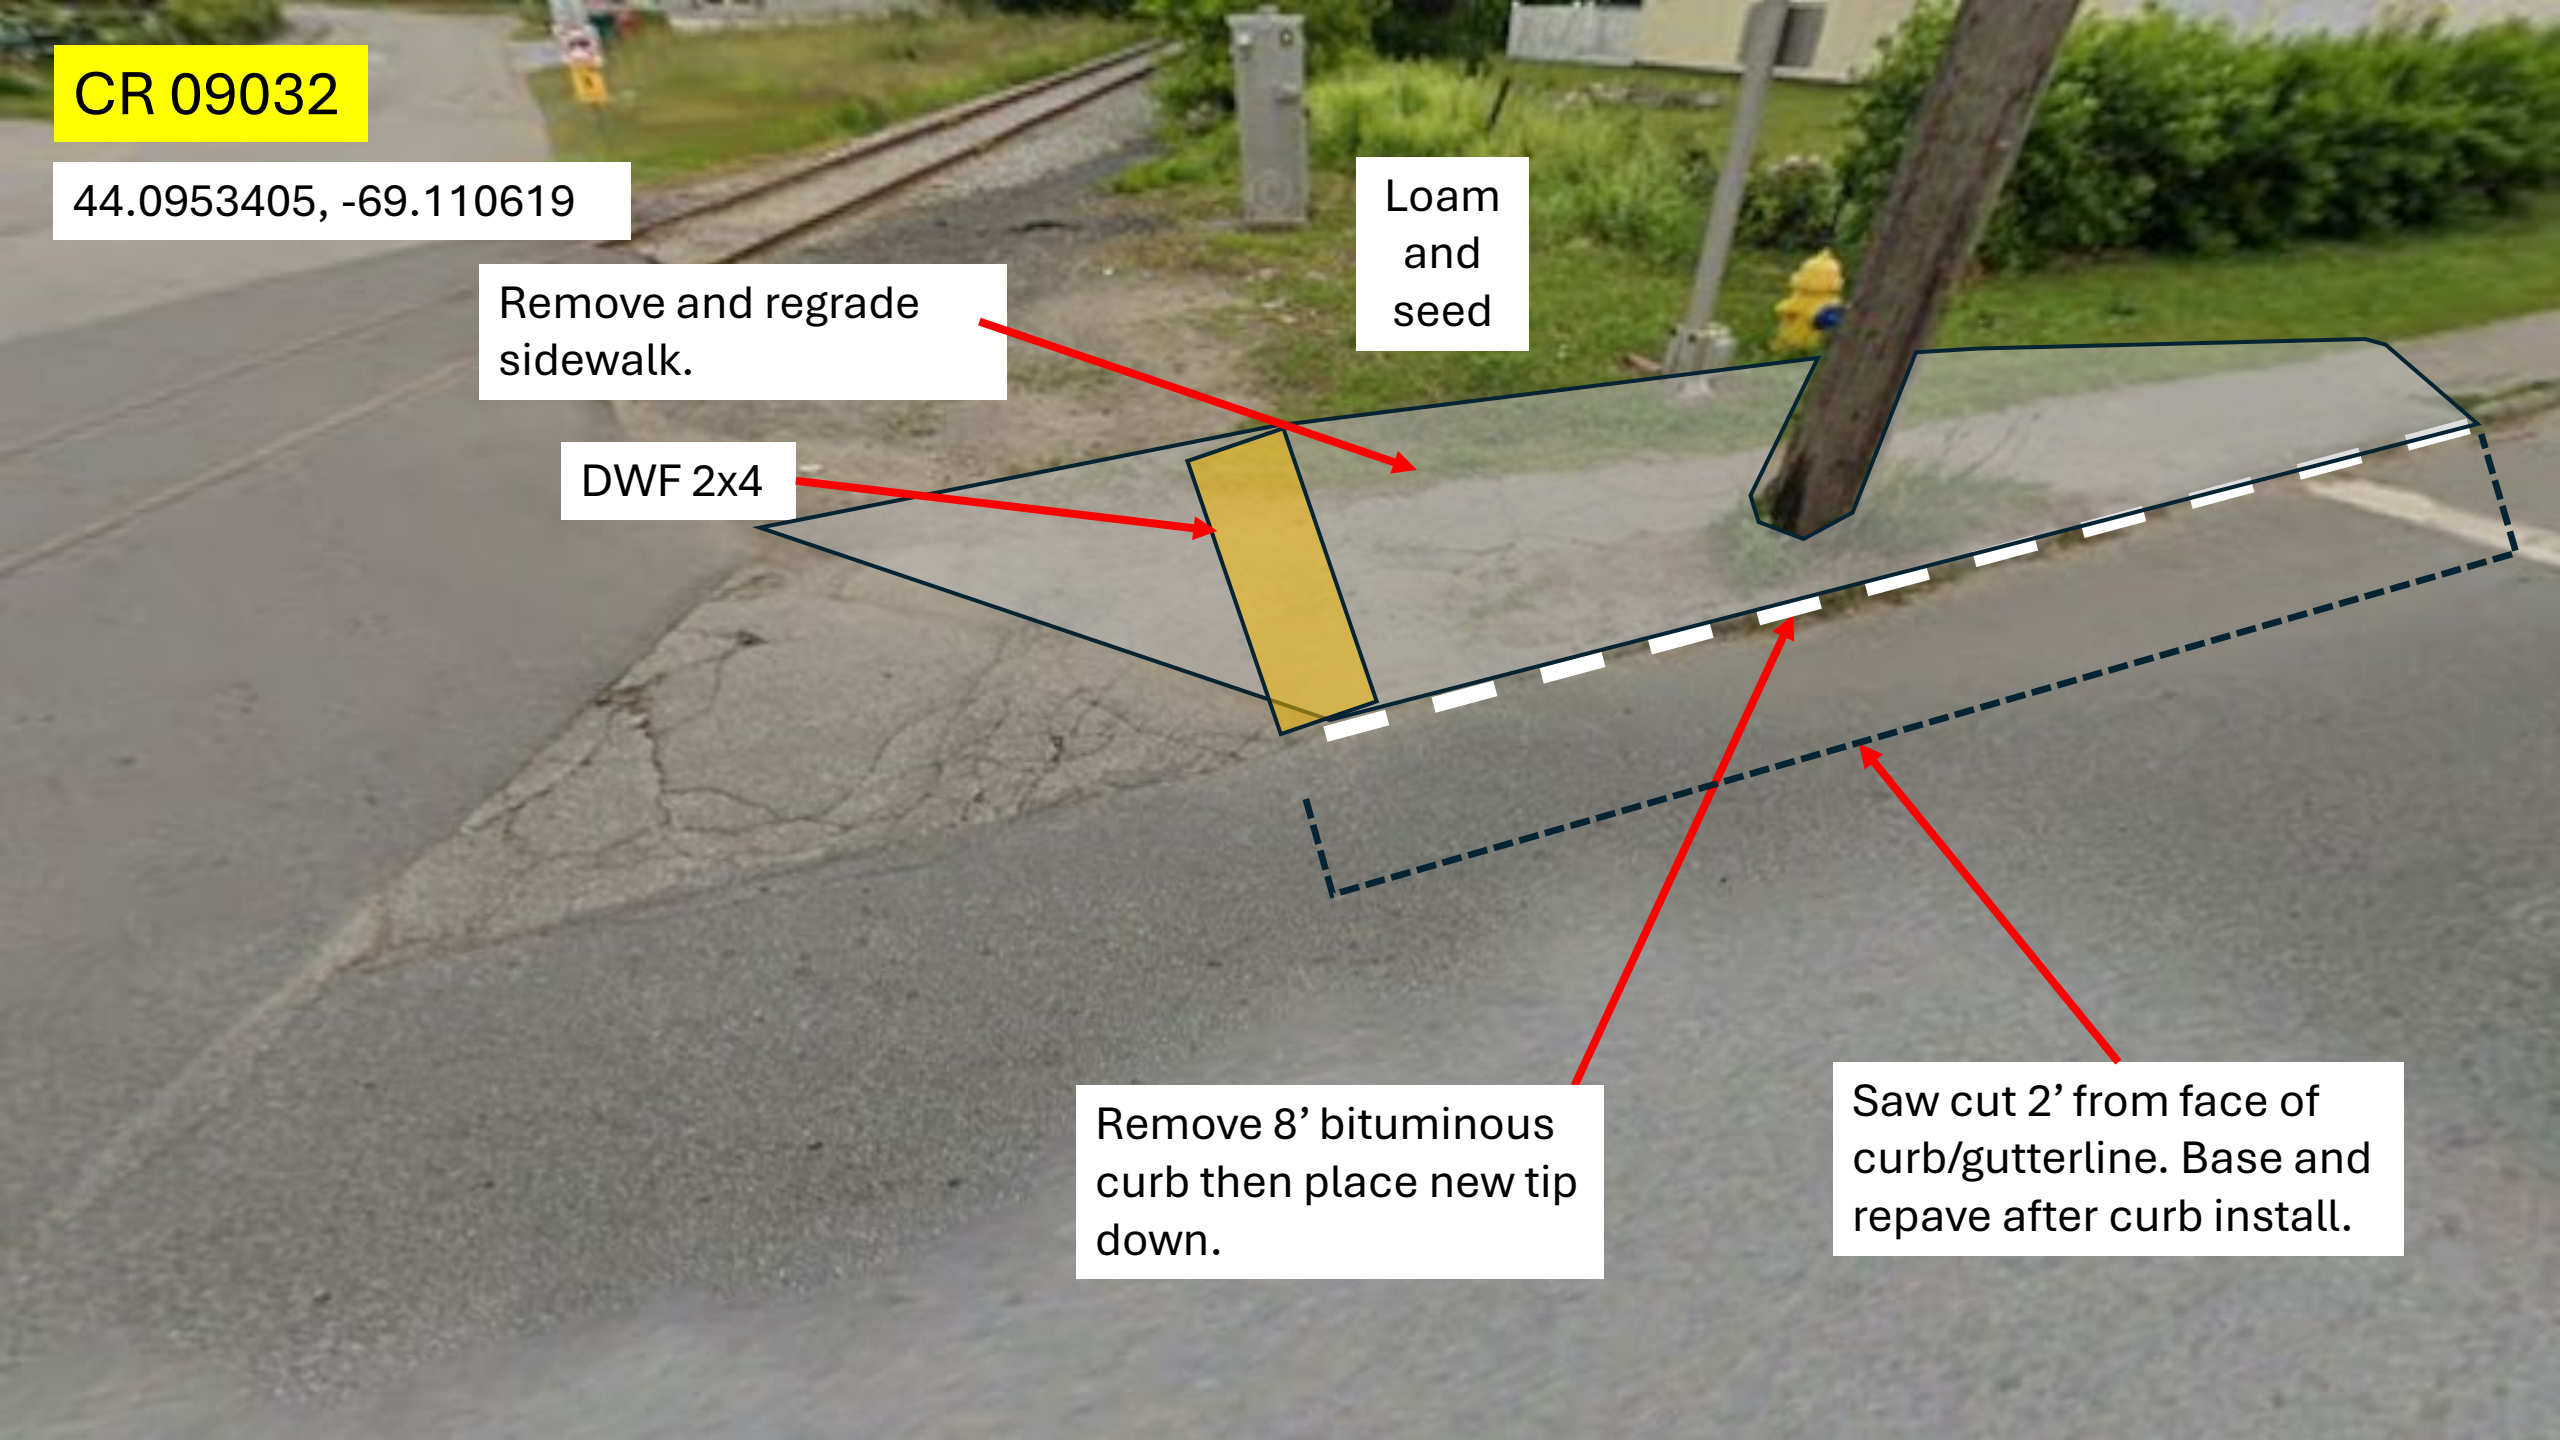



RAMP REPORT REGION 2 ADA 2026

Lawerence St., & Ingraham Lane,
Rockland

CR09034

44.094568, -69.110588

Remove and regrade sidewalk.

Loam and seed.

Remove 8' bituminous curb then place new tip down.

Saw cut 2' from face of curb/gutterline. Base and repave after curb install.



DWF 2x4

CR9035

44.094508, -69.110579


Remove and regrade
sidewalk.

Loam
and
seed.

DWF 2x4

Saw cut 2' from face of
curb/gutterline. Base and
repave after curb install.

Remove 8' bituminous
curb then place new tip
down.

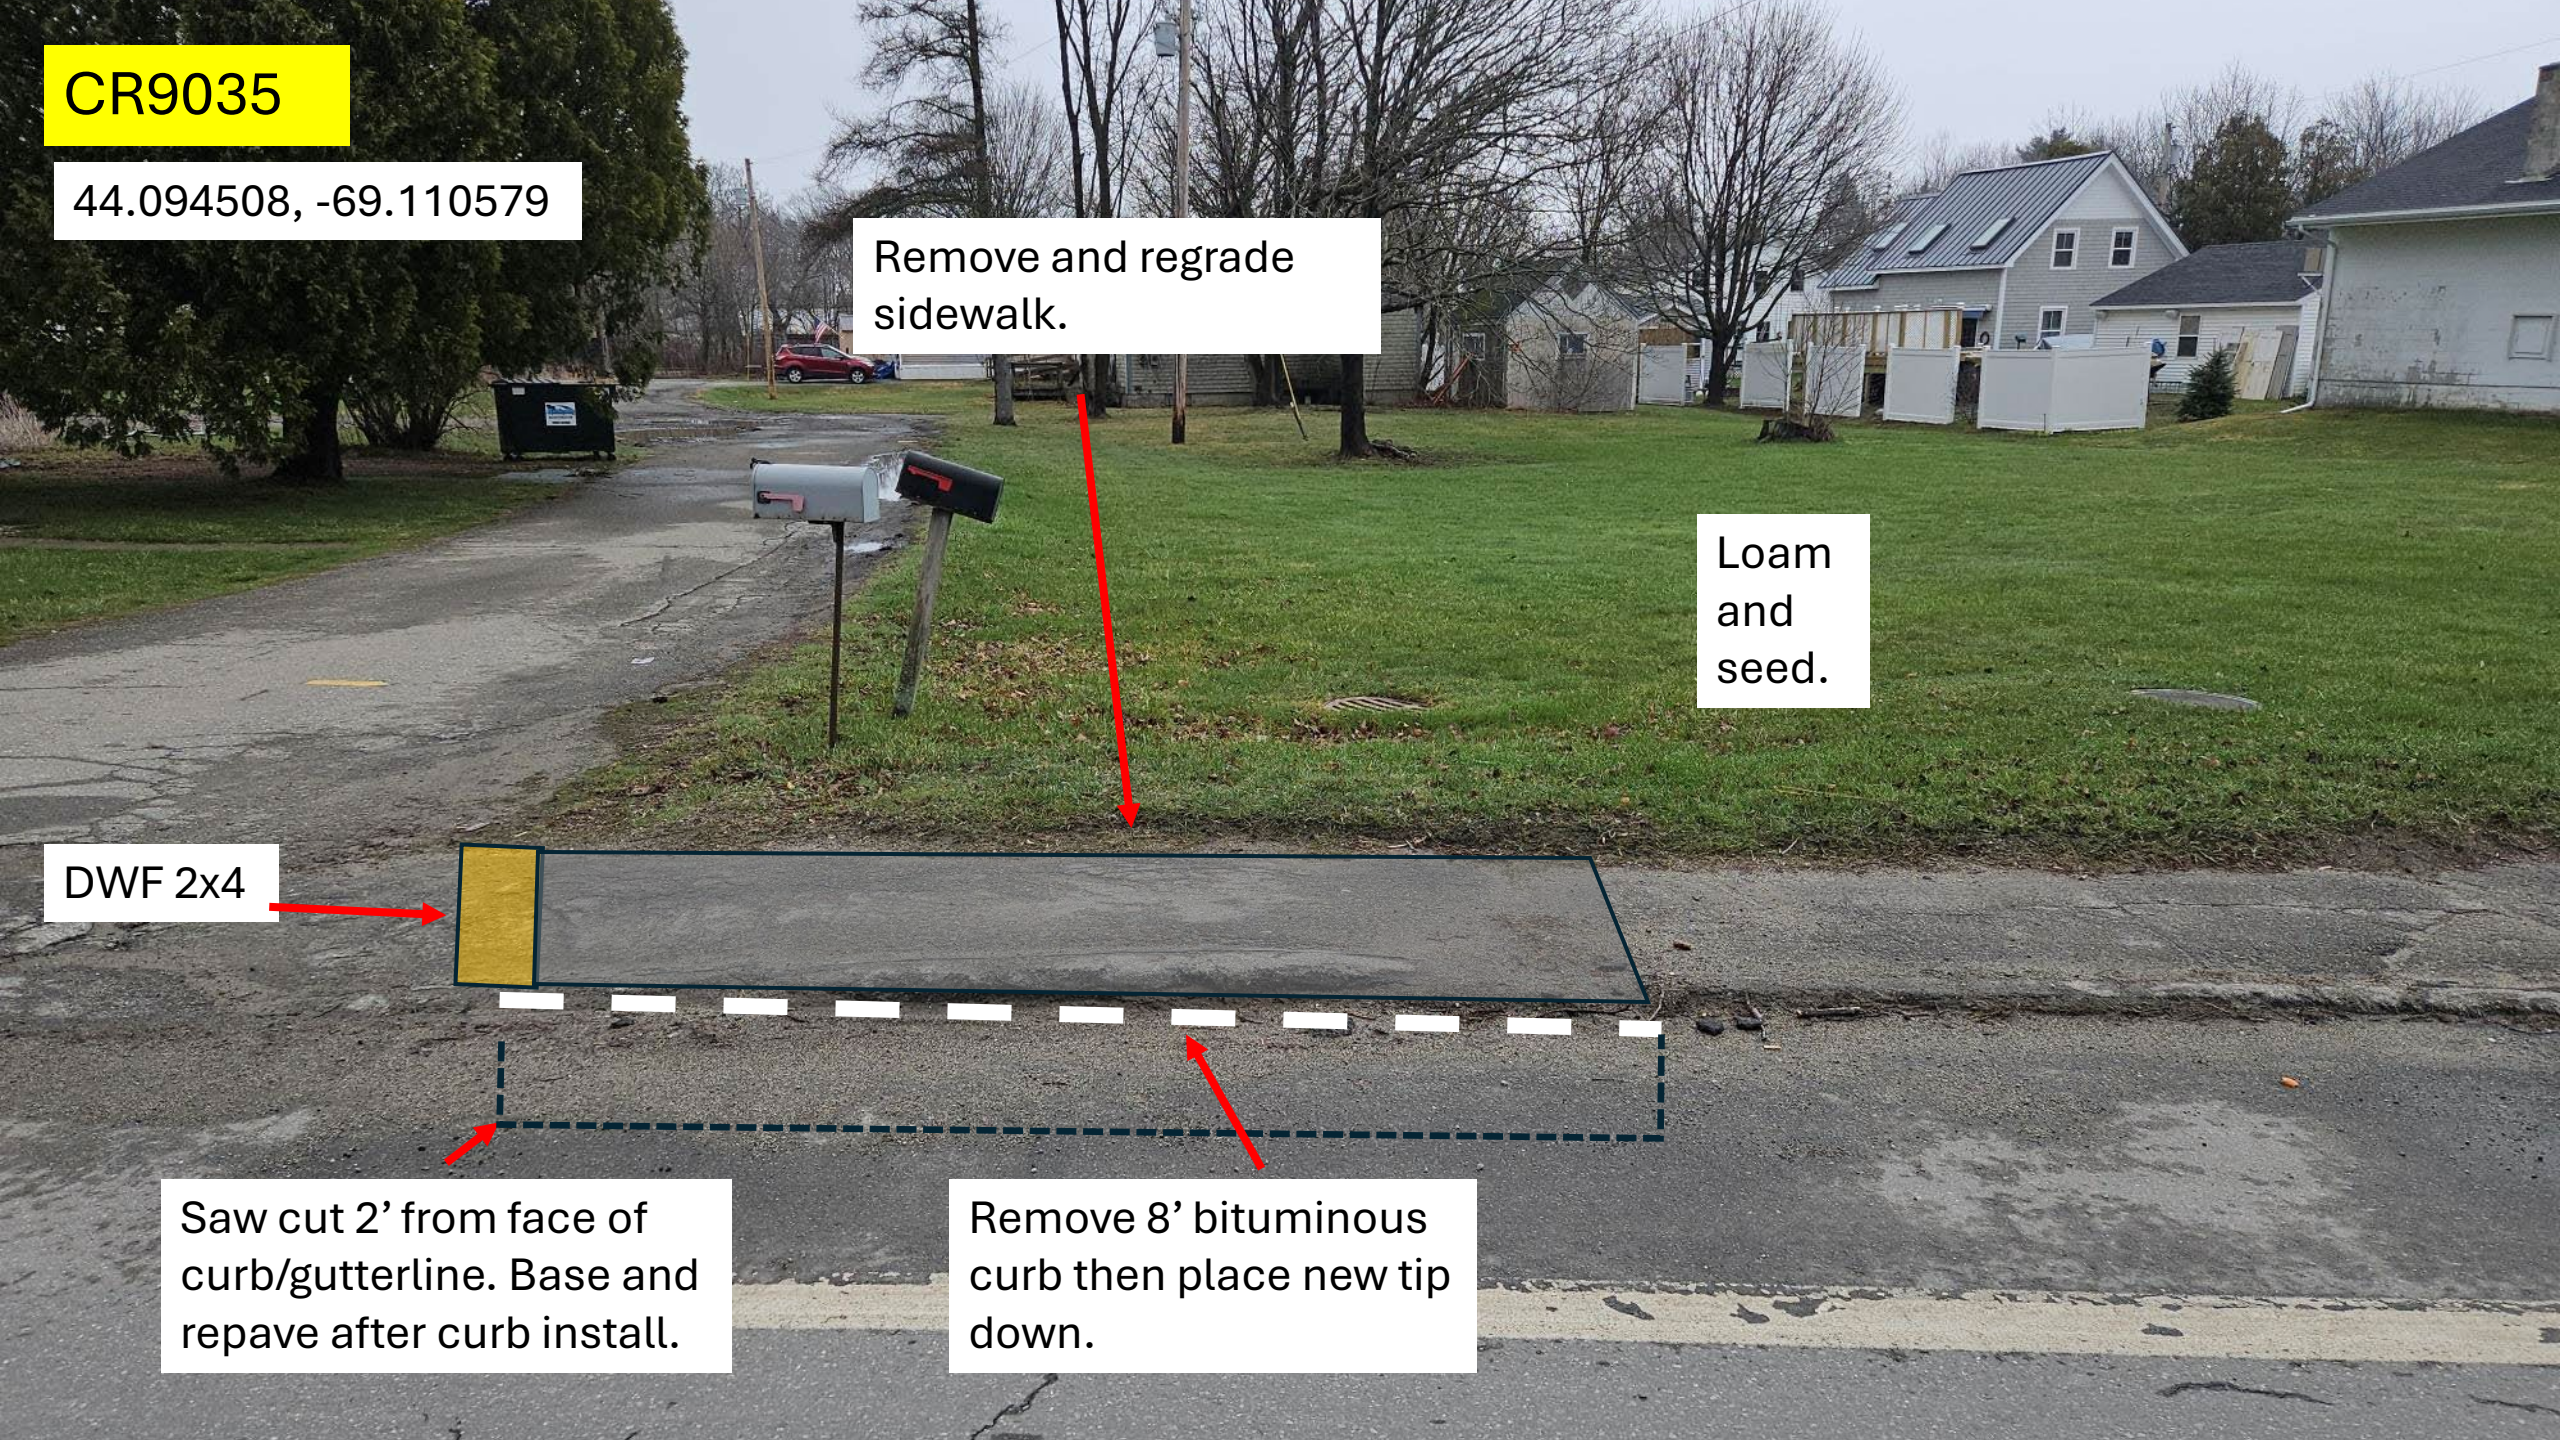

CR09036


44.093967, -69.110544

Remove and regrade
sidewalk.

DWF 2x4

Saw cut 2' from face of
curb/gutterline. Base and
repave after curb install.

Add new 8' Bituminous
curb. (Both sides,
making an island)

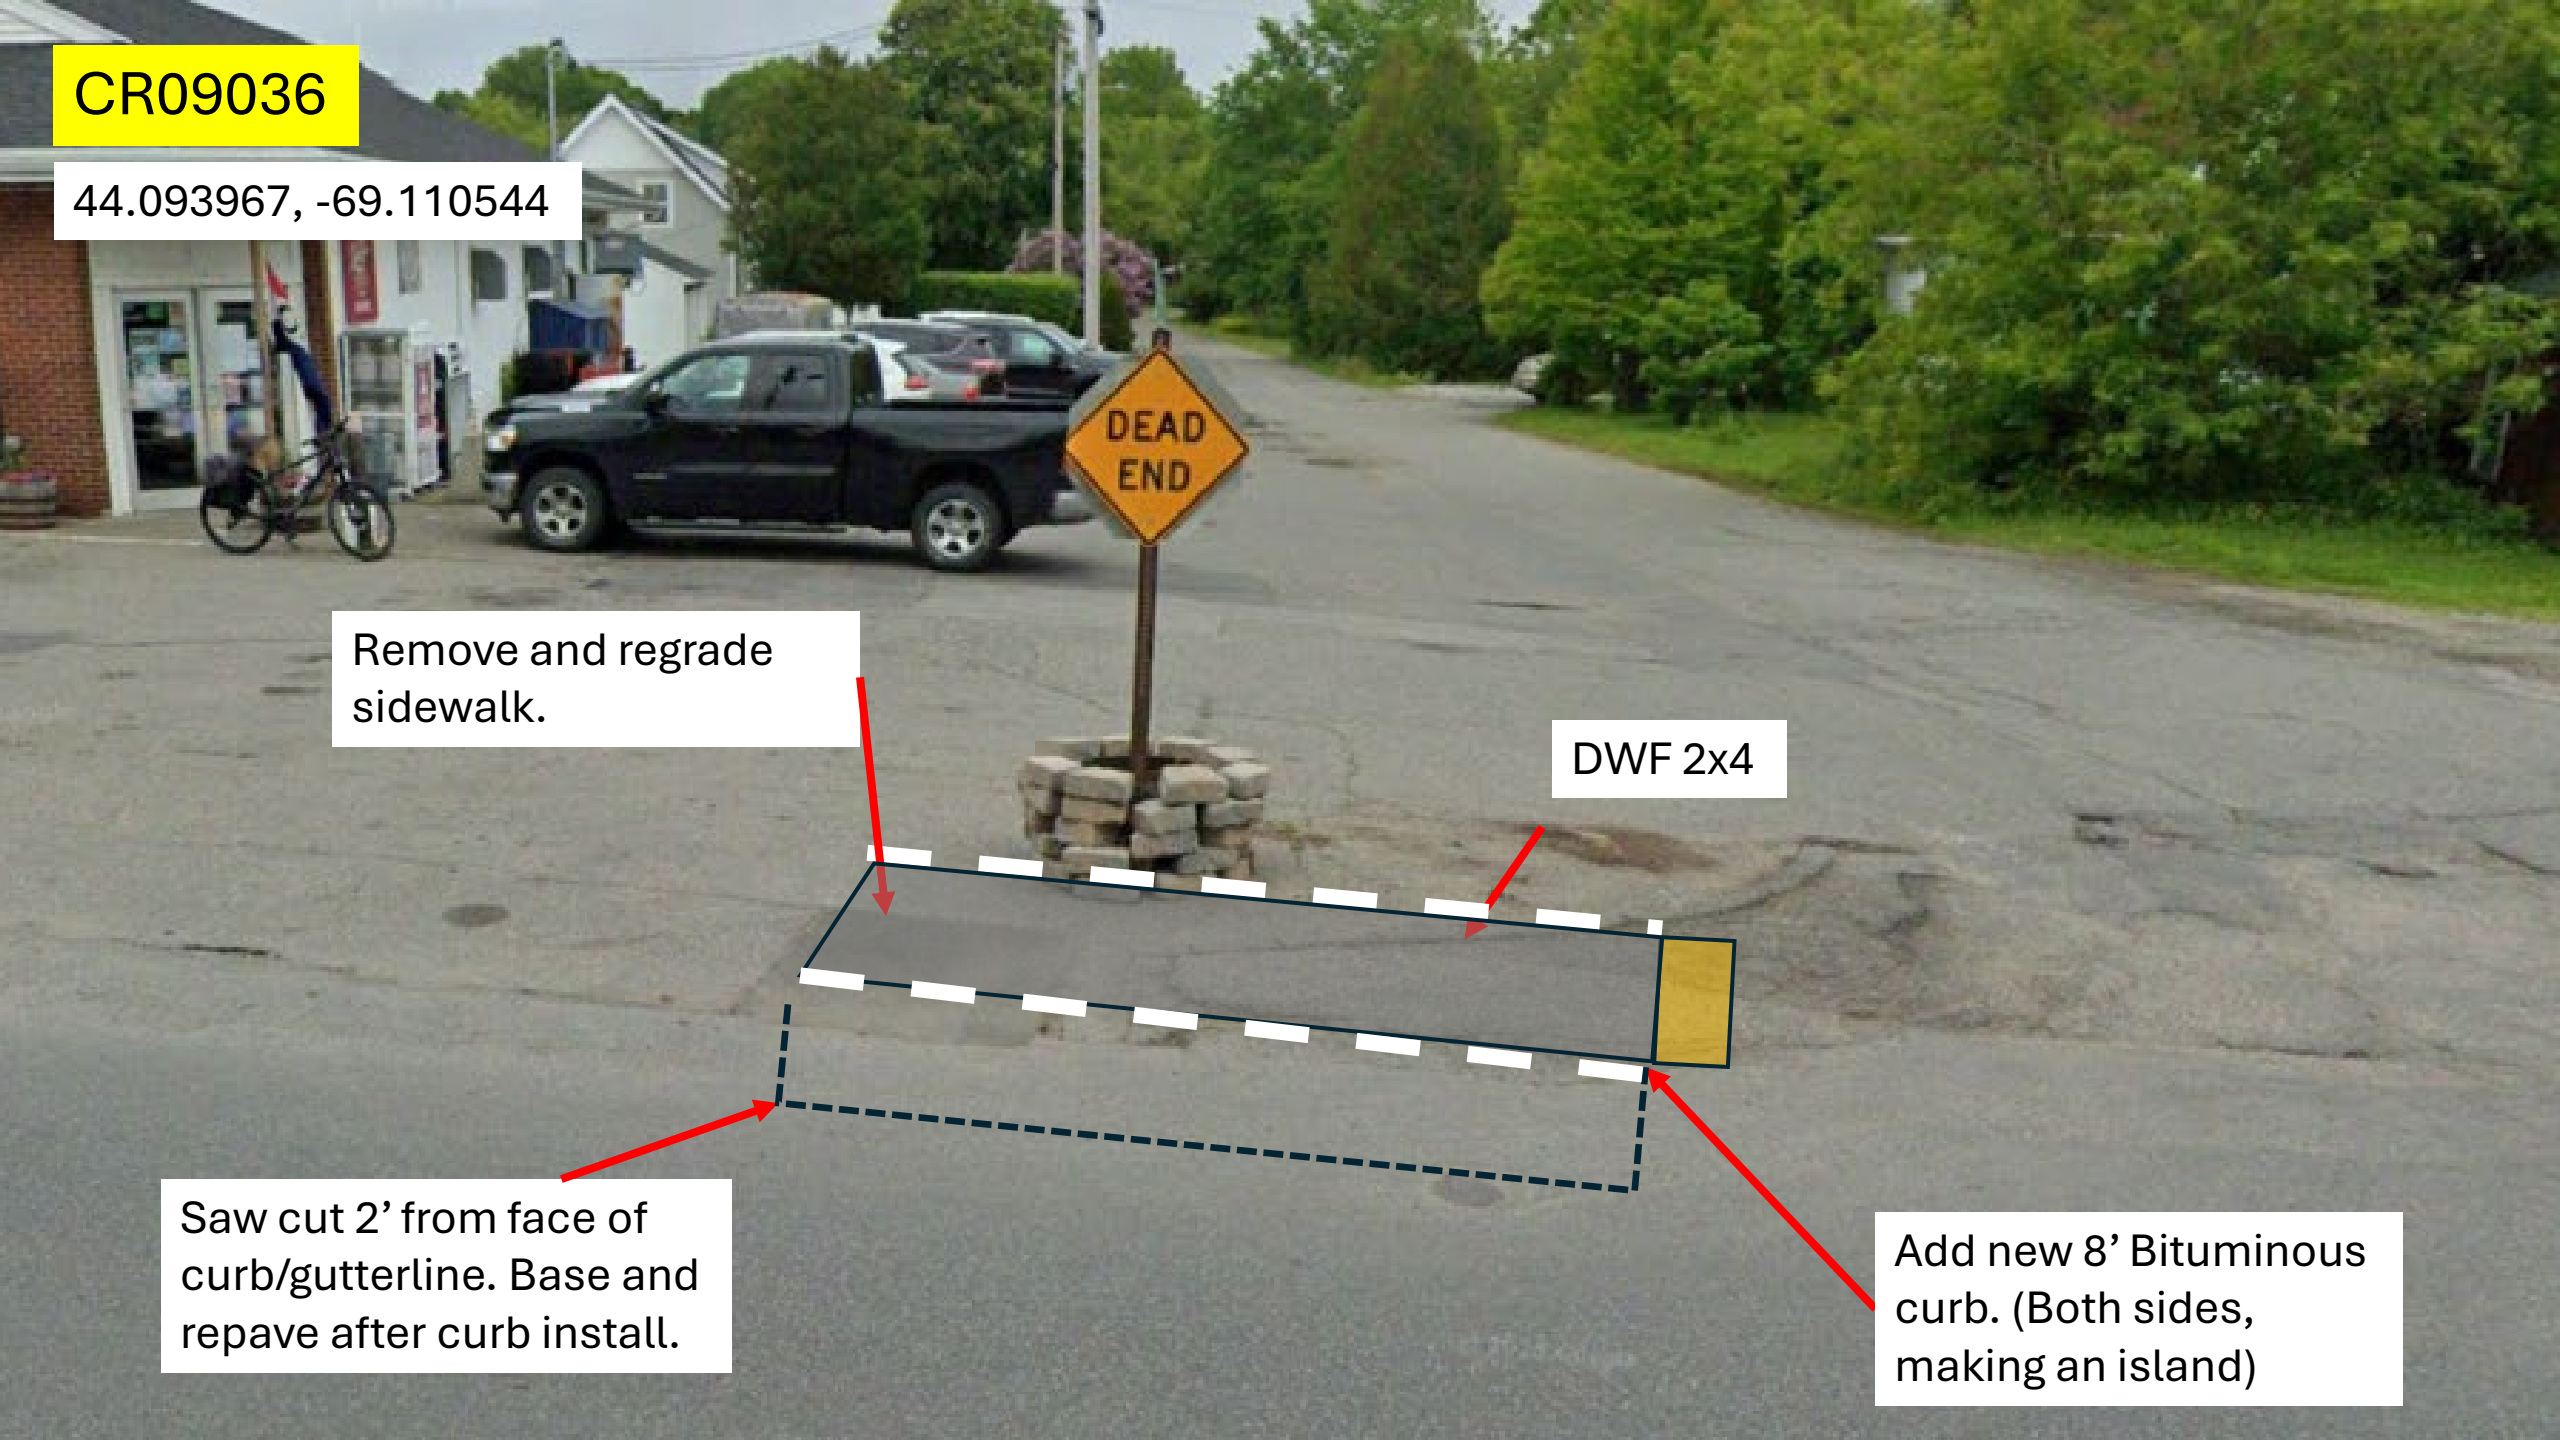

CR09037

44.093919, -69.110547


Remove and regrade
sidewalk.


Loam
and
seed

Remove 8' bituminous
curb then place new tip
down.

DWF 2x4

Saw cut 2' from face of
curb/gutterline. Base and
repave after curb install.

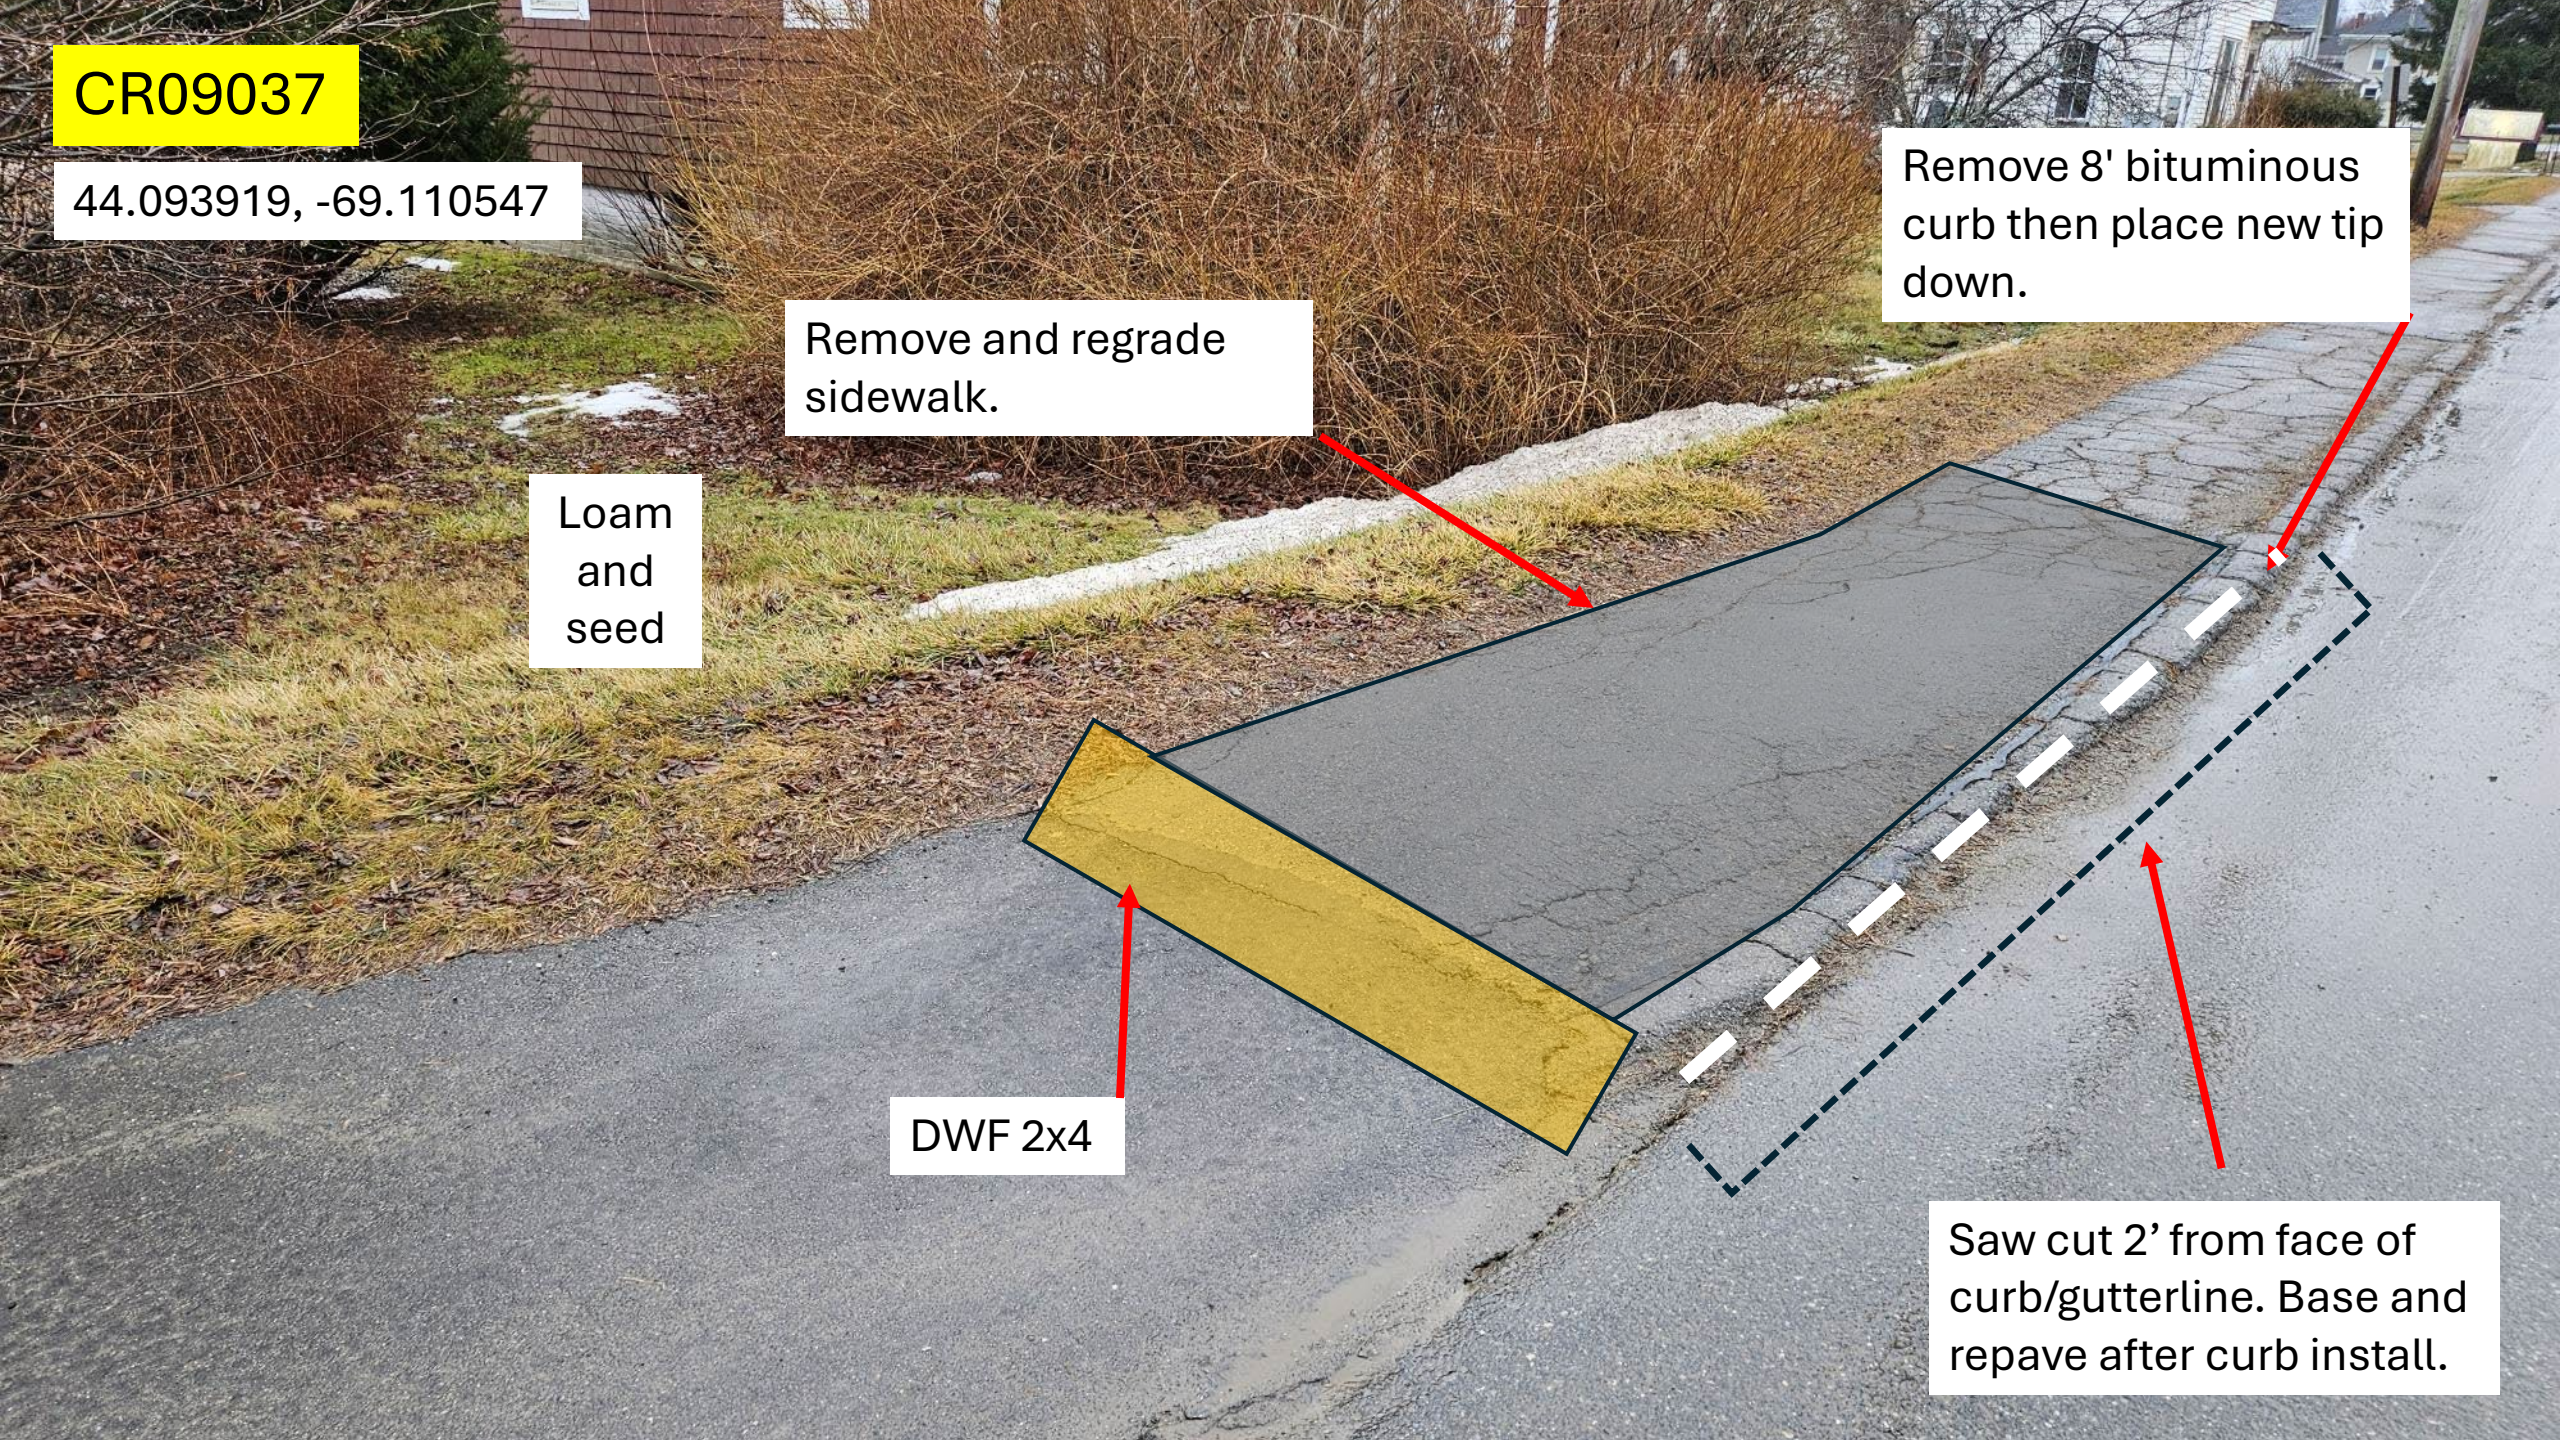

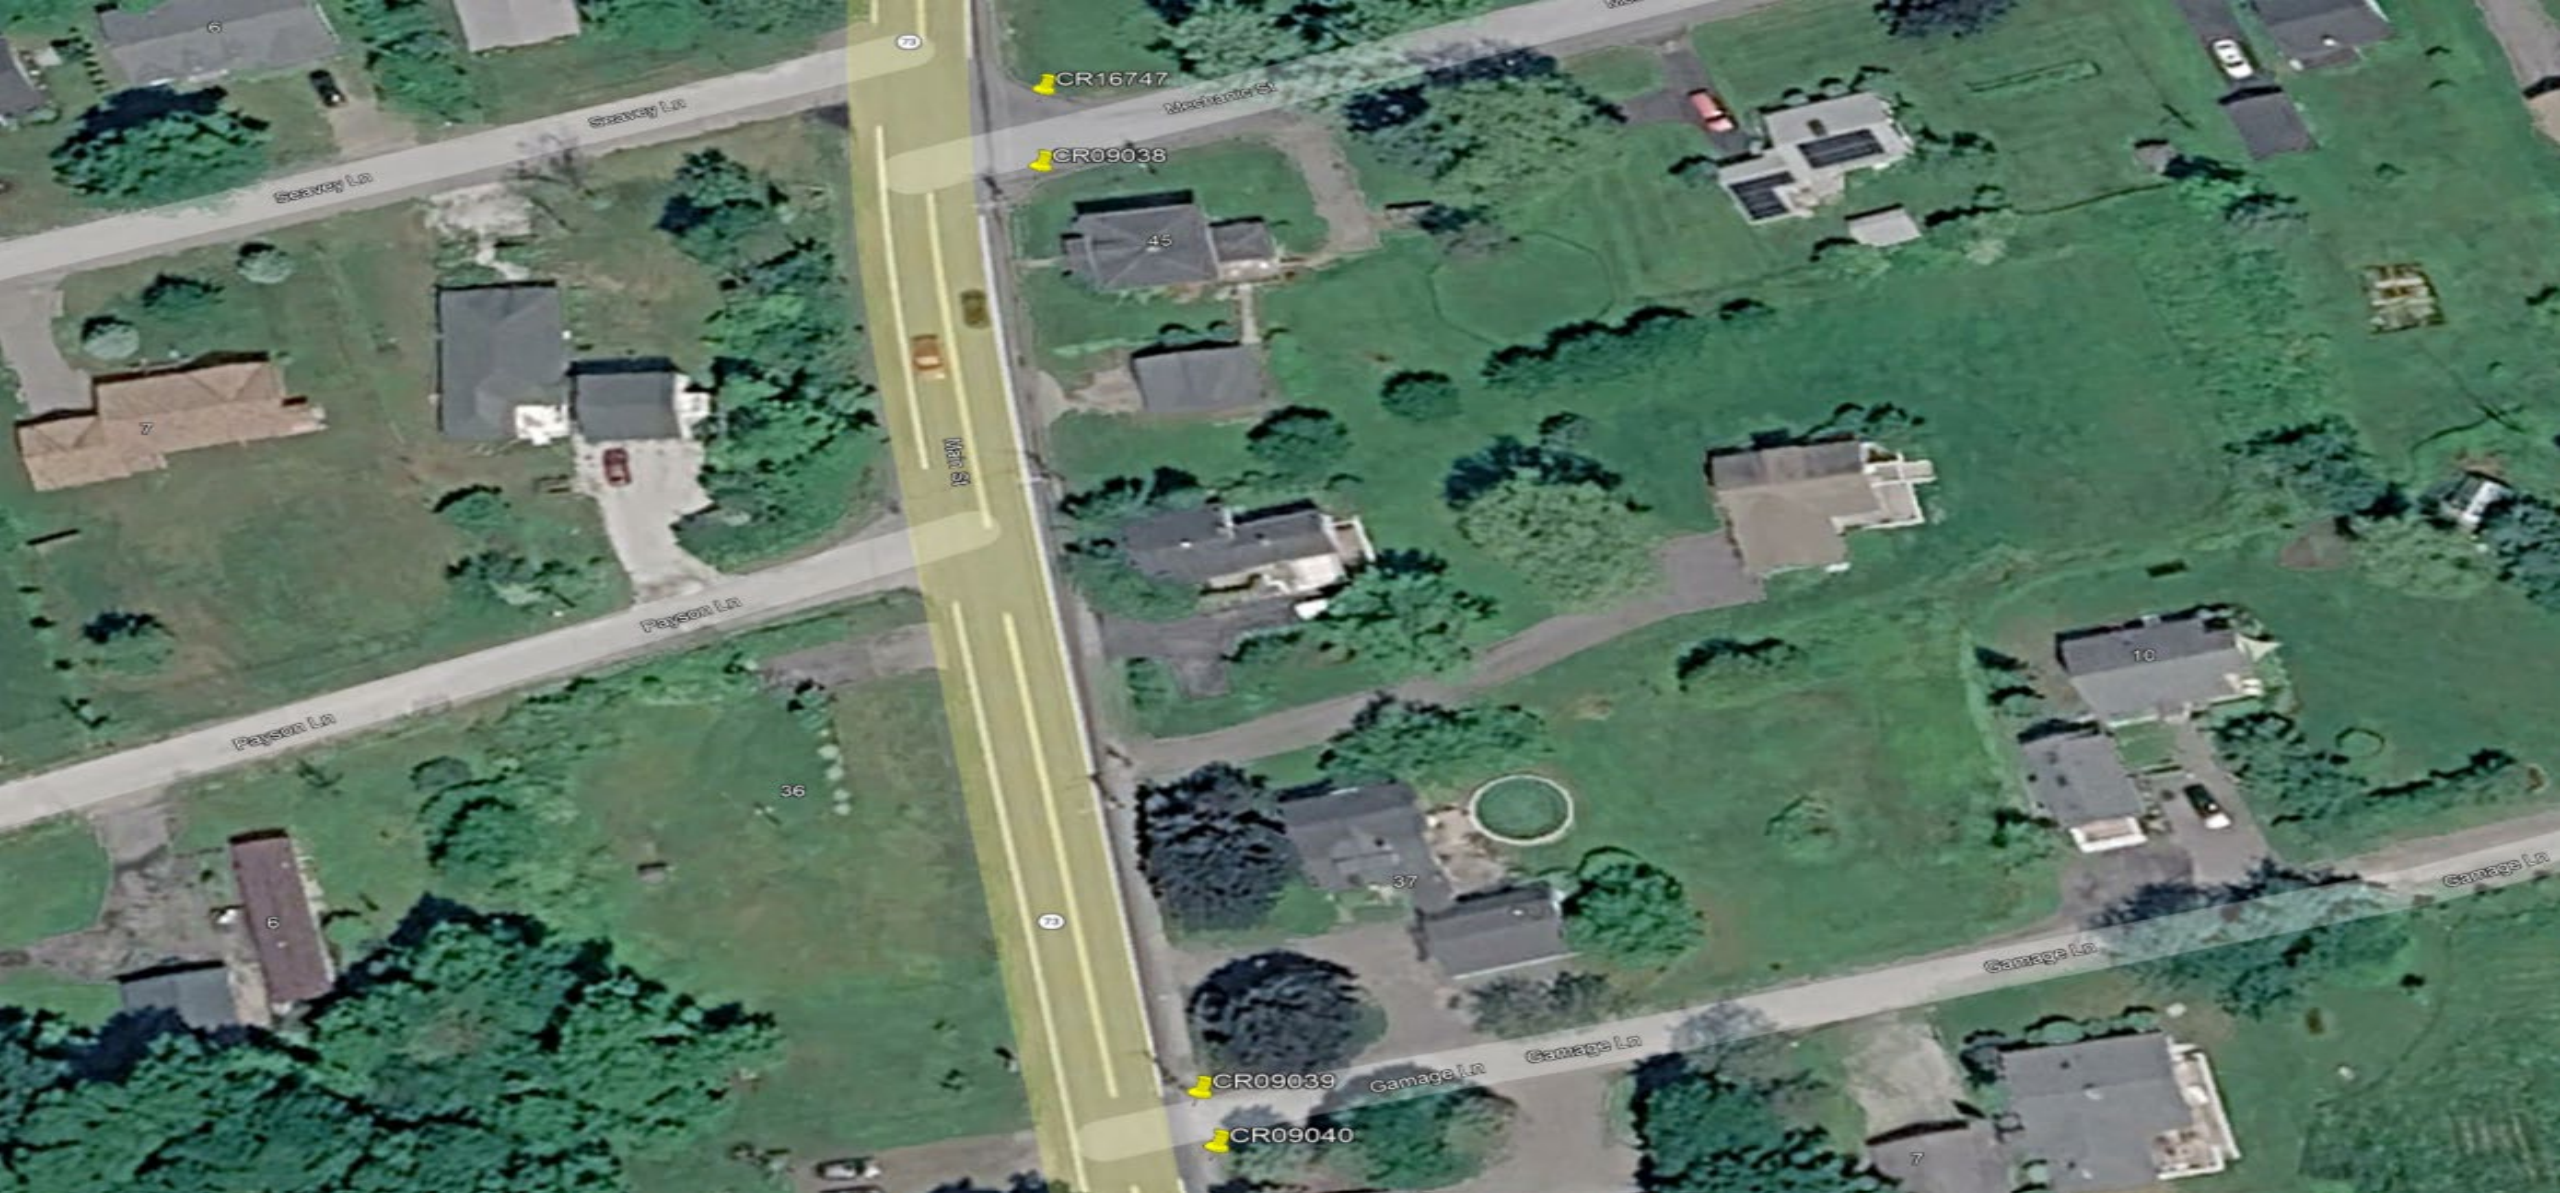

RAMP REPORT REGION 2 ADA 2026

Mechanic St., and Gamage Lane,
Rockland

CR16747

44.093096, -69.110276


Loam
and
seed.

Remove and regrade
sidewalk.

Saw cut 2' from face of
curb/gutterline. Base and
repave after curb install.

Remove 8' bituminous
curb then place new tip
down.

DWF 2x4

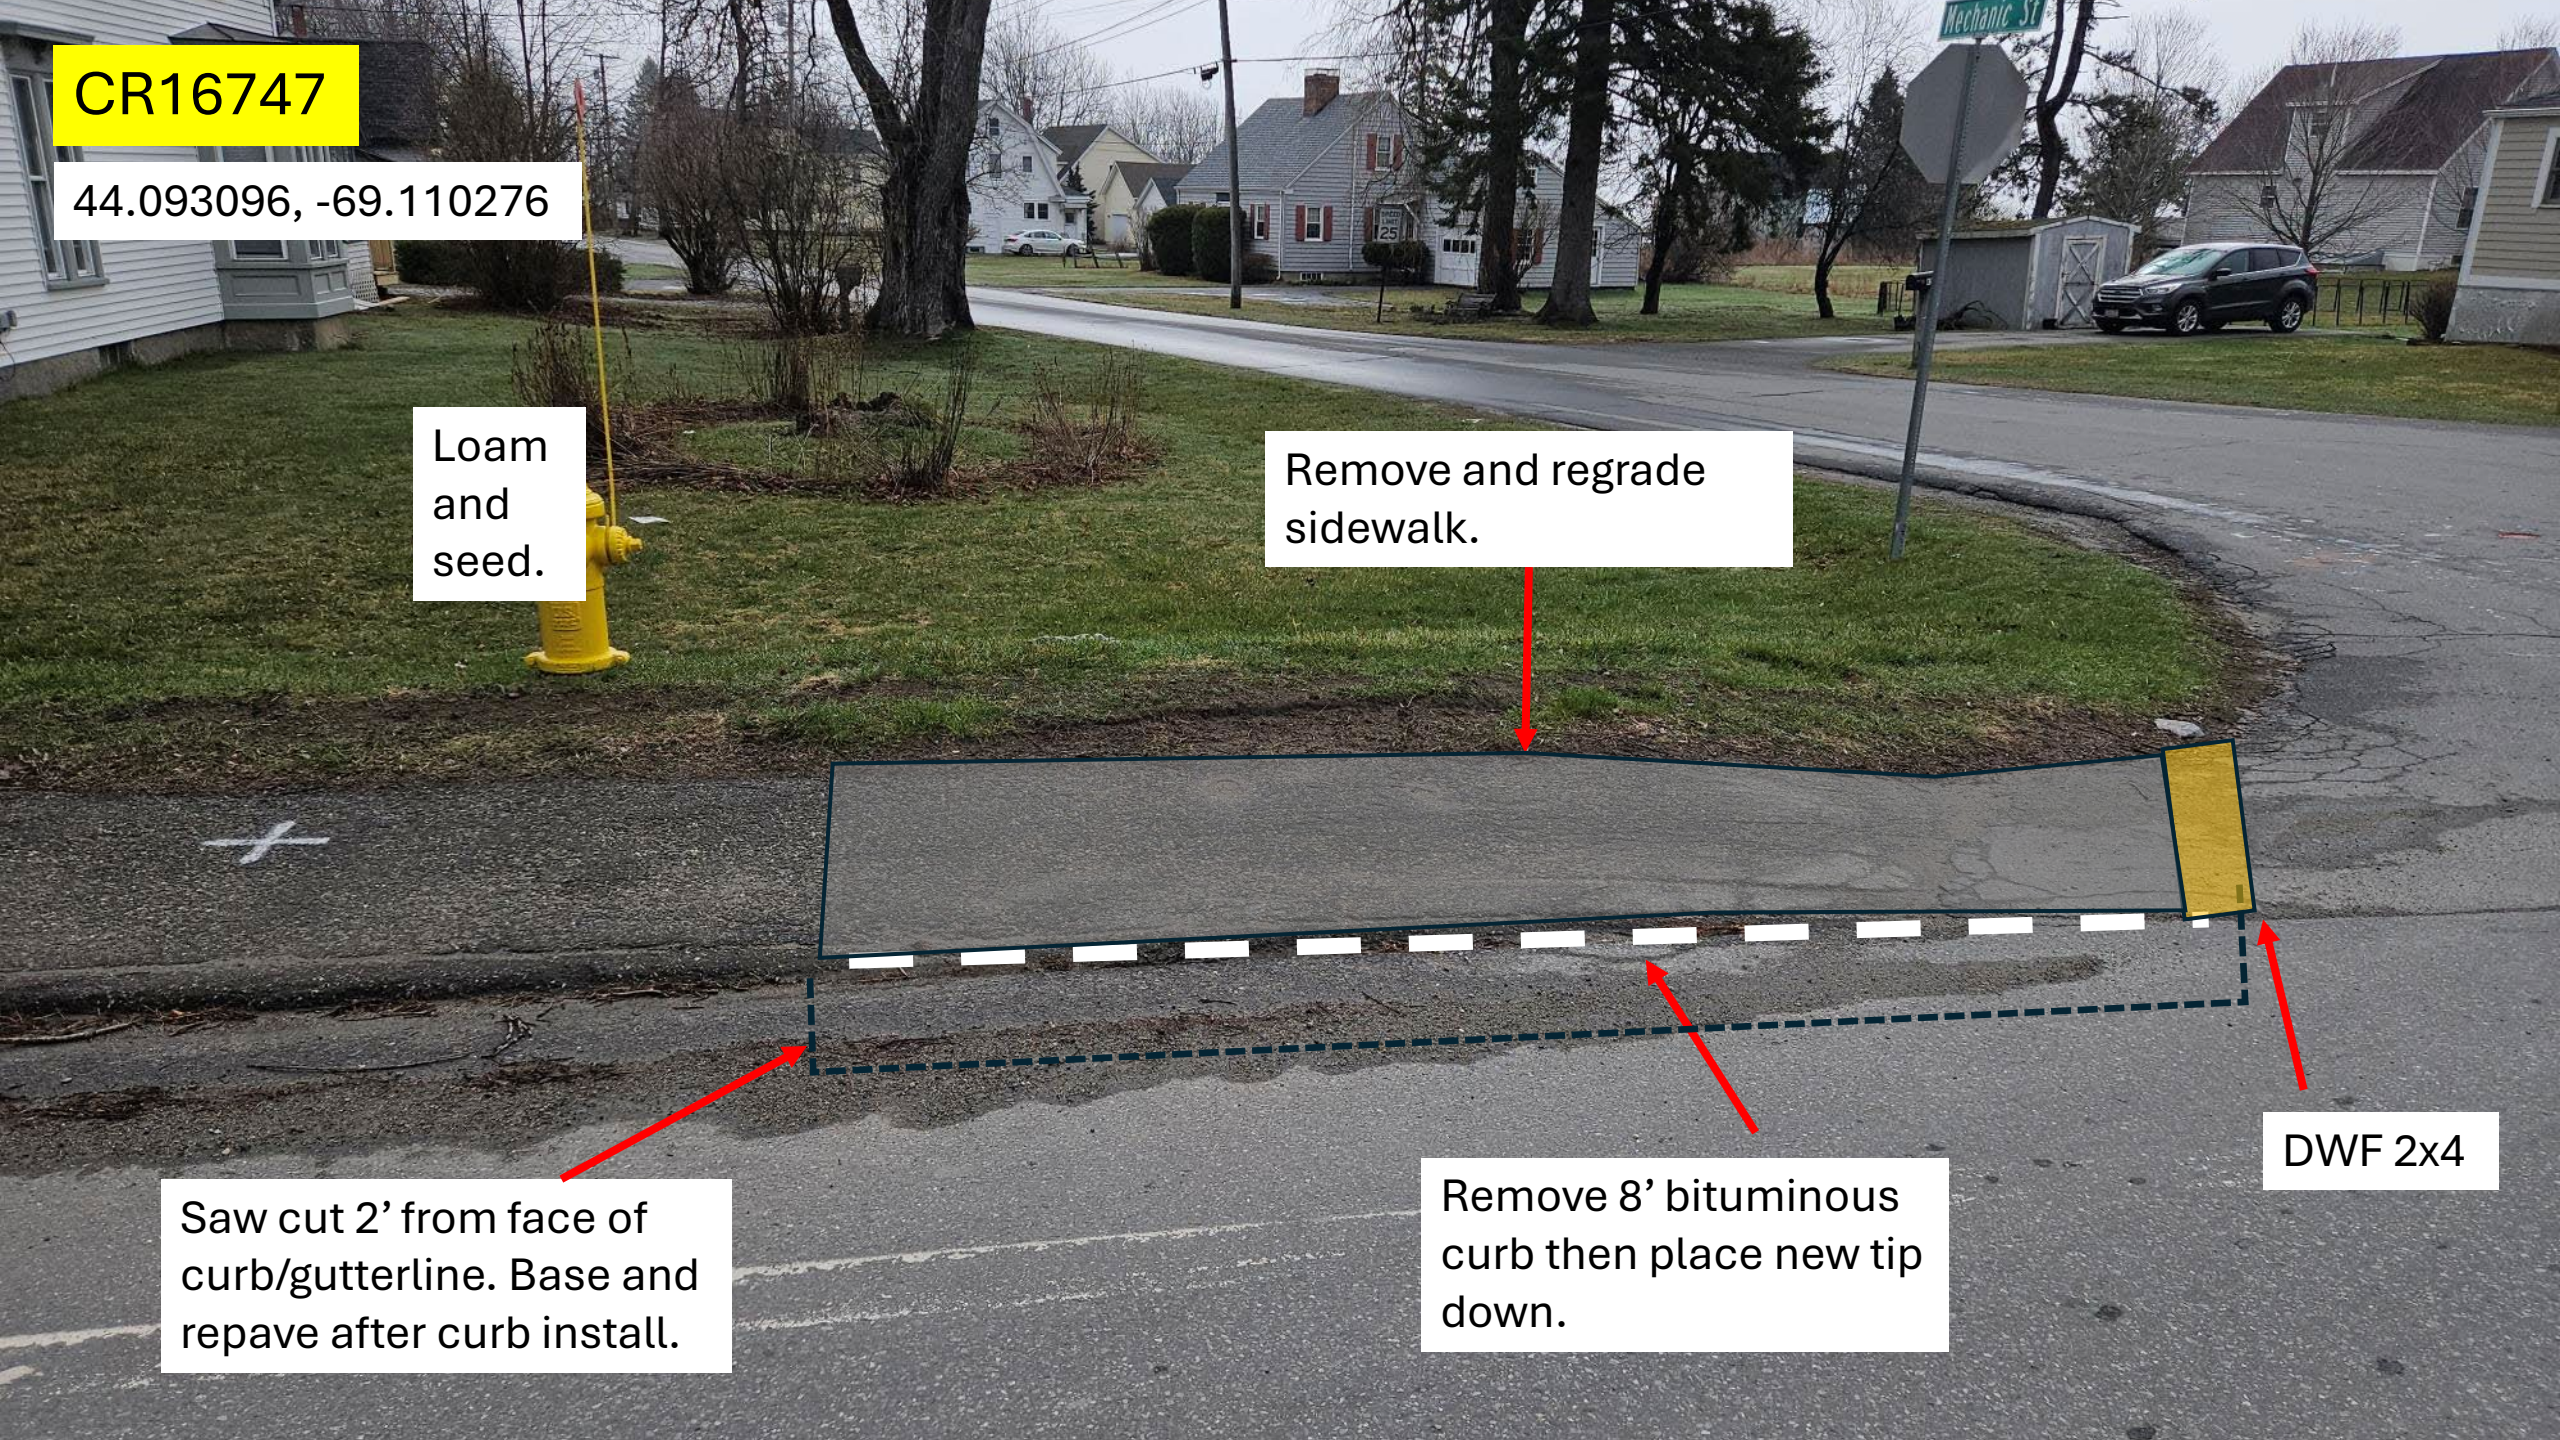

CR09038

44.092734, -69.110571


Loam
and
seed

Remove and regrade
sidewalk.

DWF 2x4

Remove 8' bituminous
curb then place new tip
down.

Saw cut 2' from face of
curb/gutterline. Base and
repave after curb install.

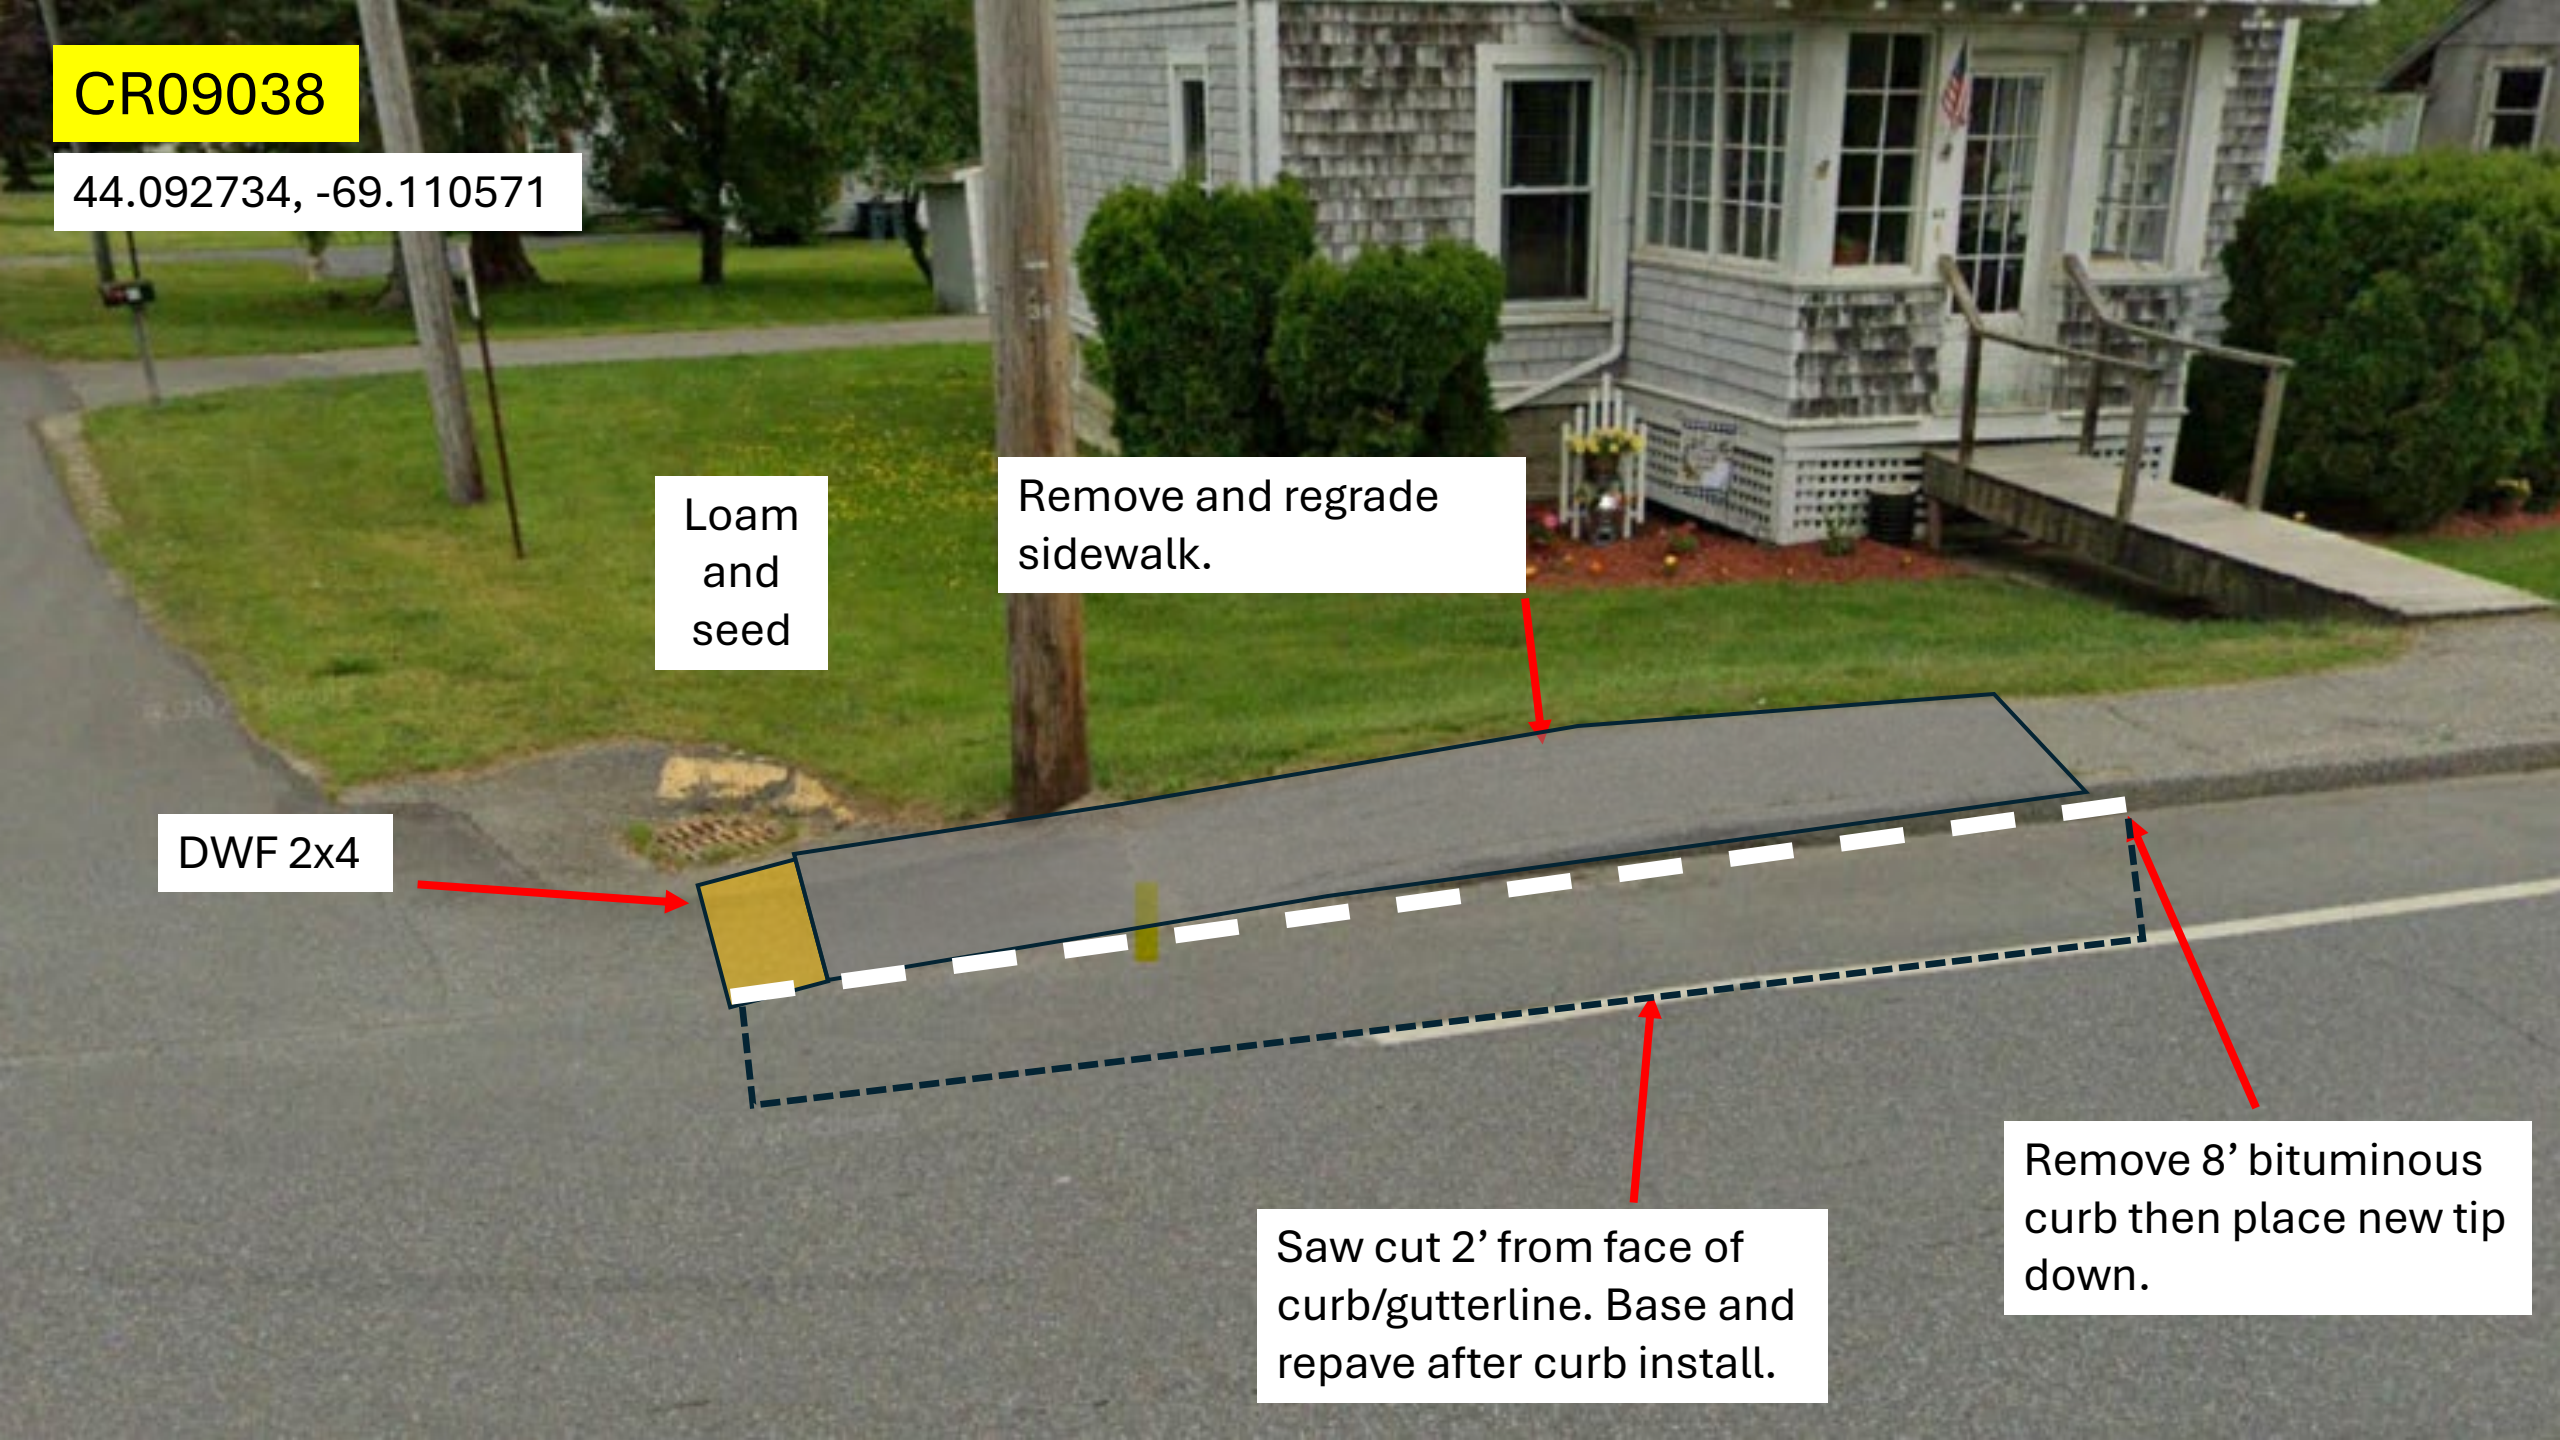

CR09039

44.091774, -69.110333


Saw cut 2' from face of curb/gutterline. Base and repave after curb install.

Remove 8' bituminous curb then place new tip down.

Remove and regrade sidewalk.

Loam and seed

DWF 2x4

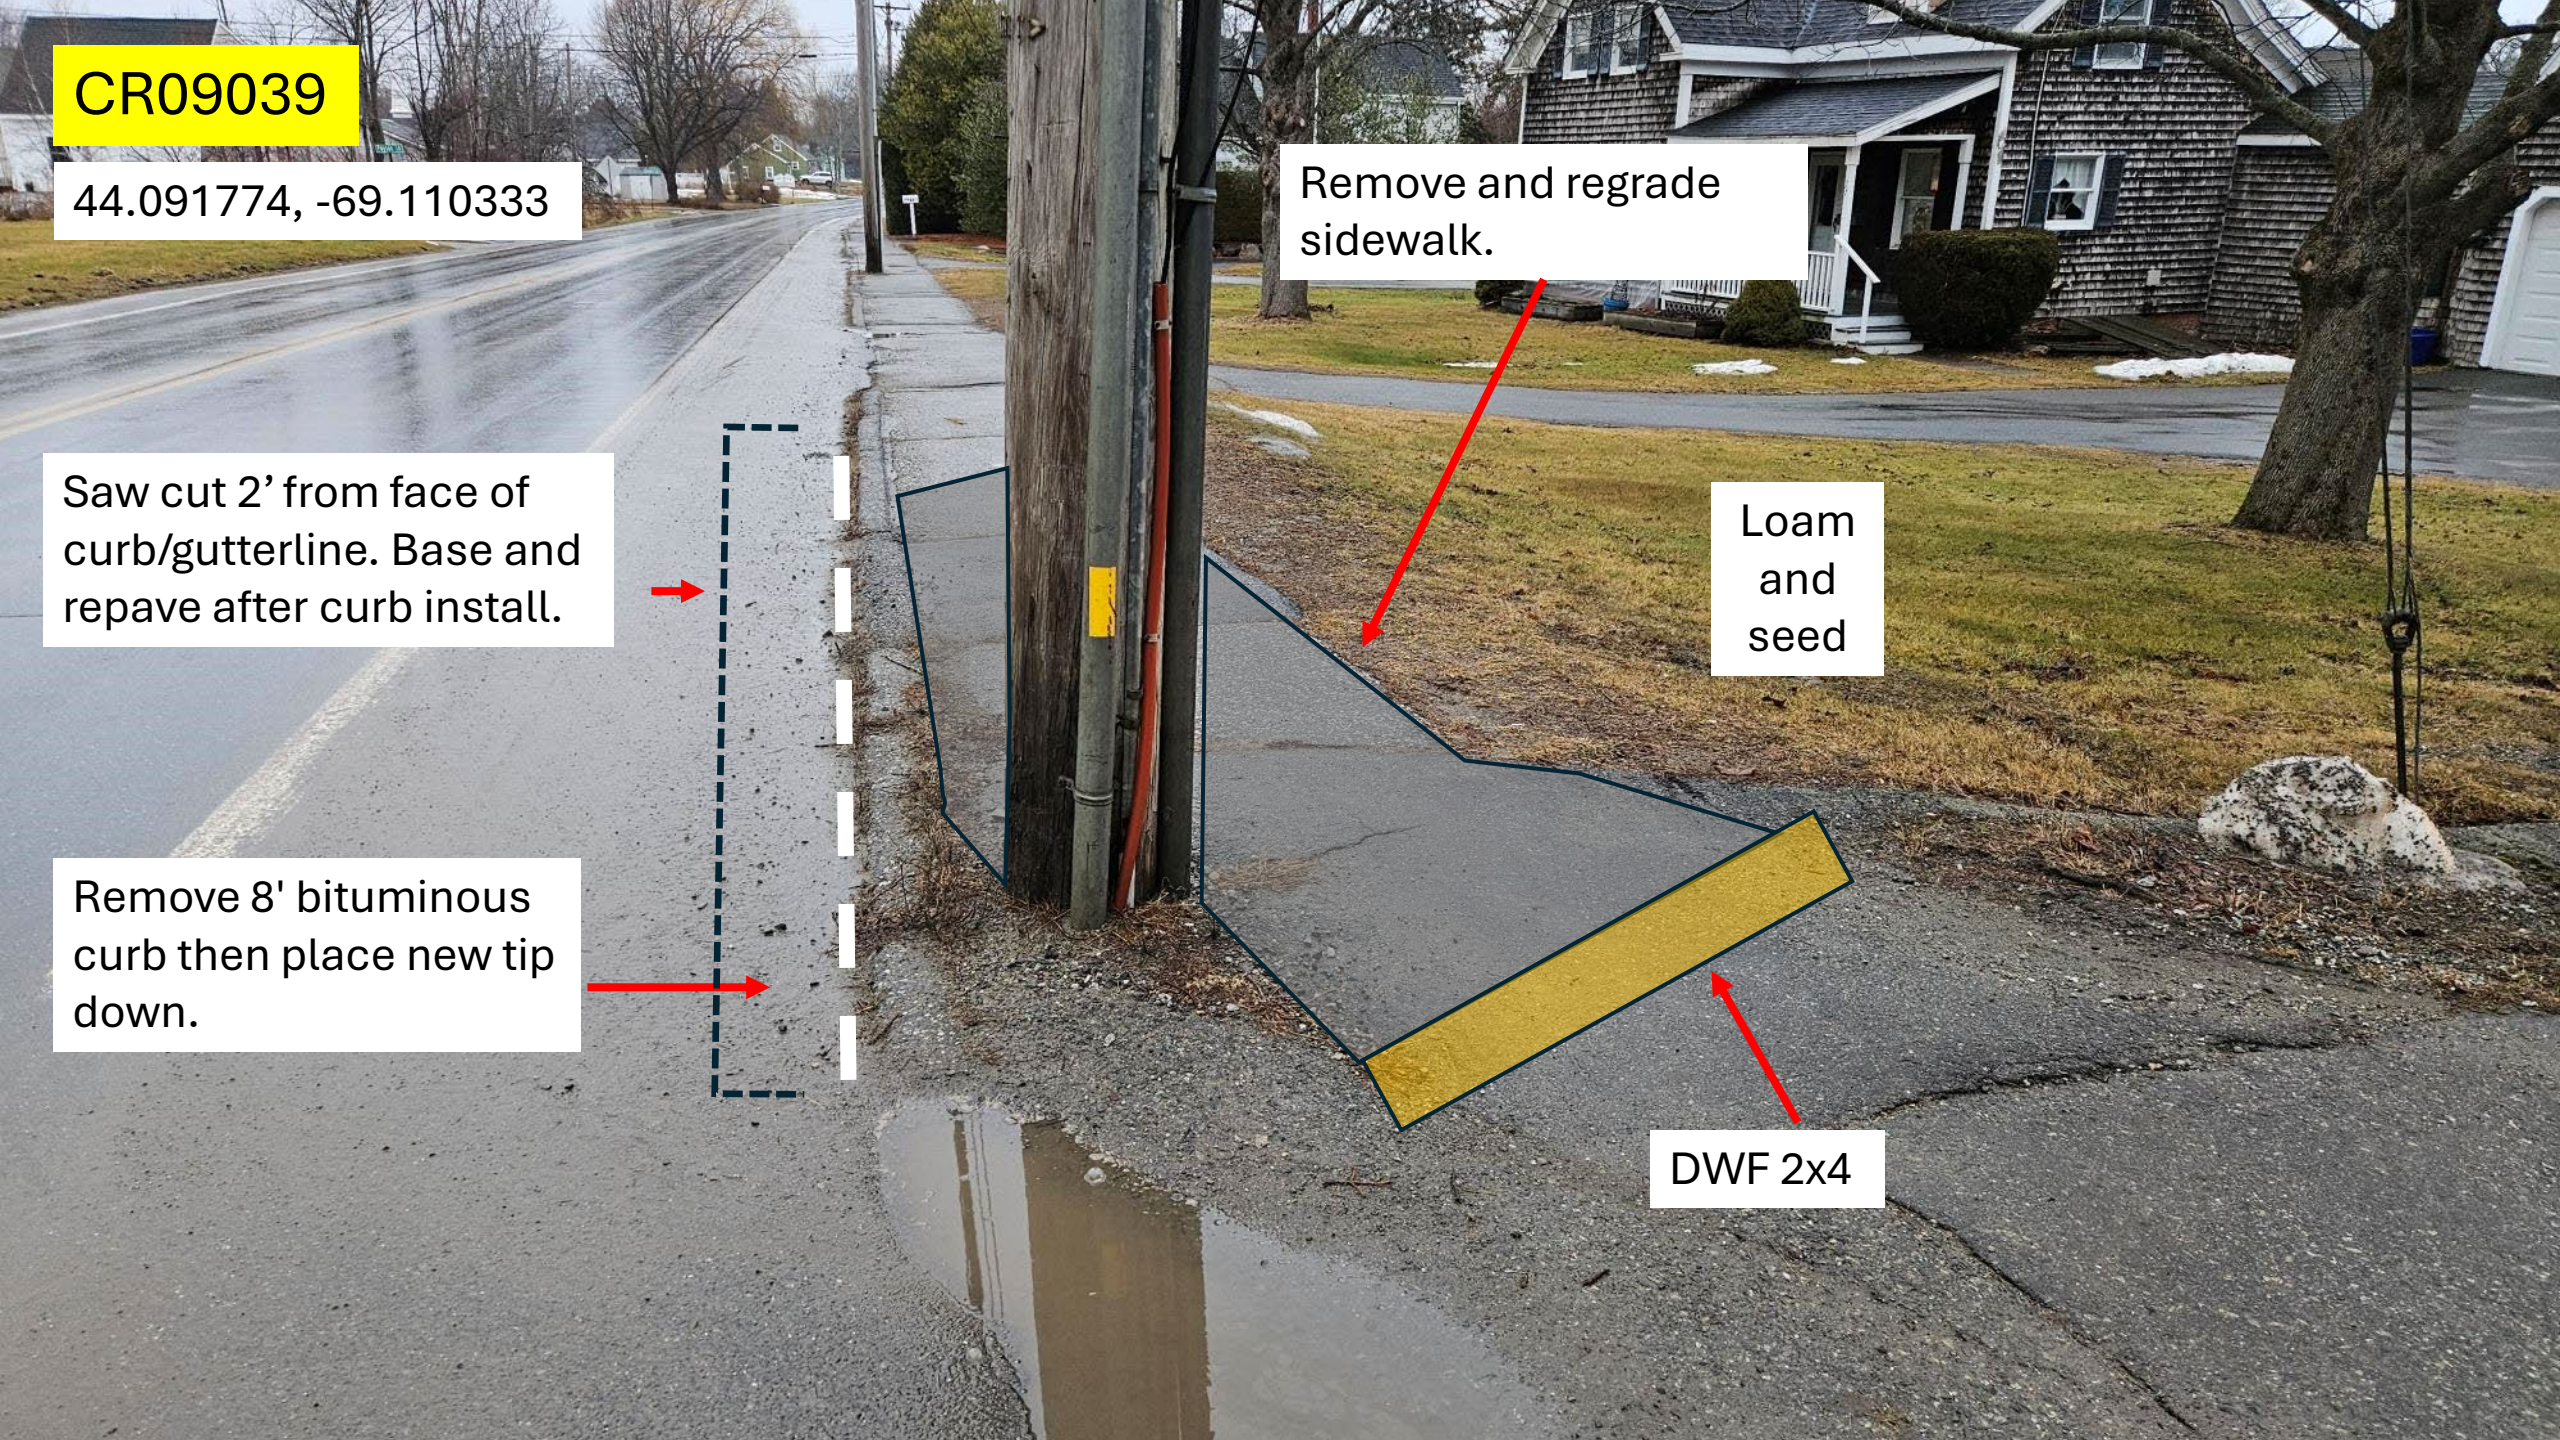

CR09040

44.091722, -69.110272


Remove and regrade sidewalk.

Loam
and
seed

DWF 2x4

Saw cut 2' from face of
curb/gutterline. Base and
repave after curb install.

Remove 8' bituminous
curb then place new tip
down.

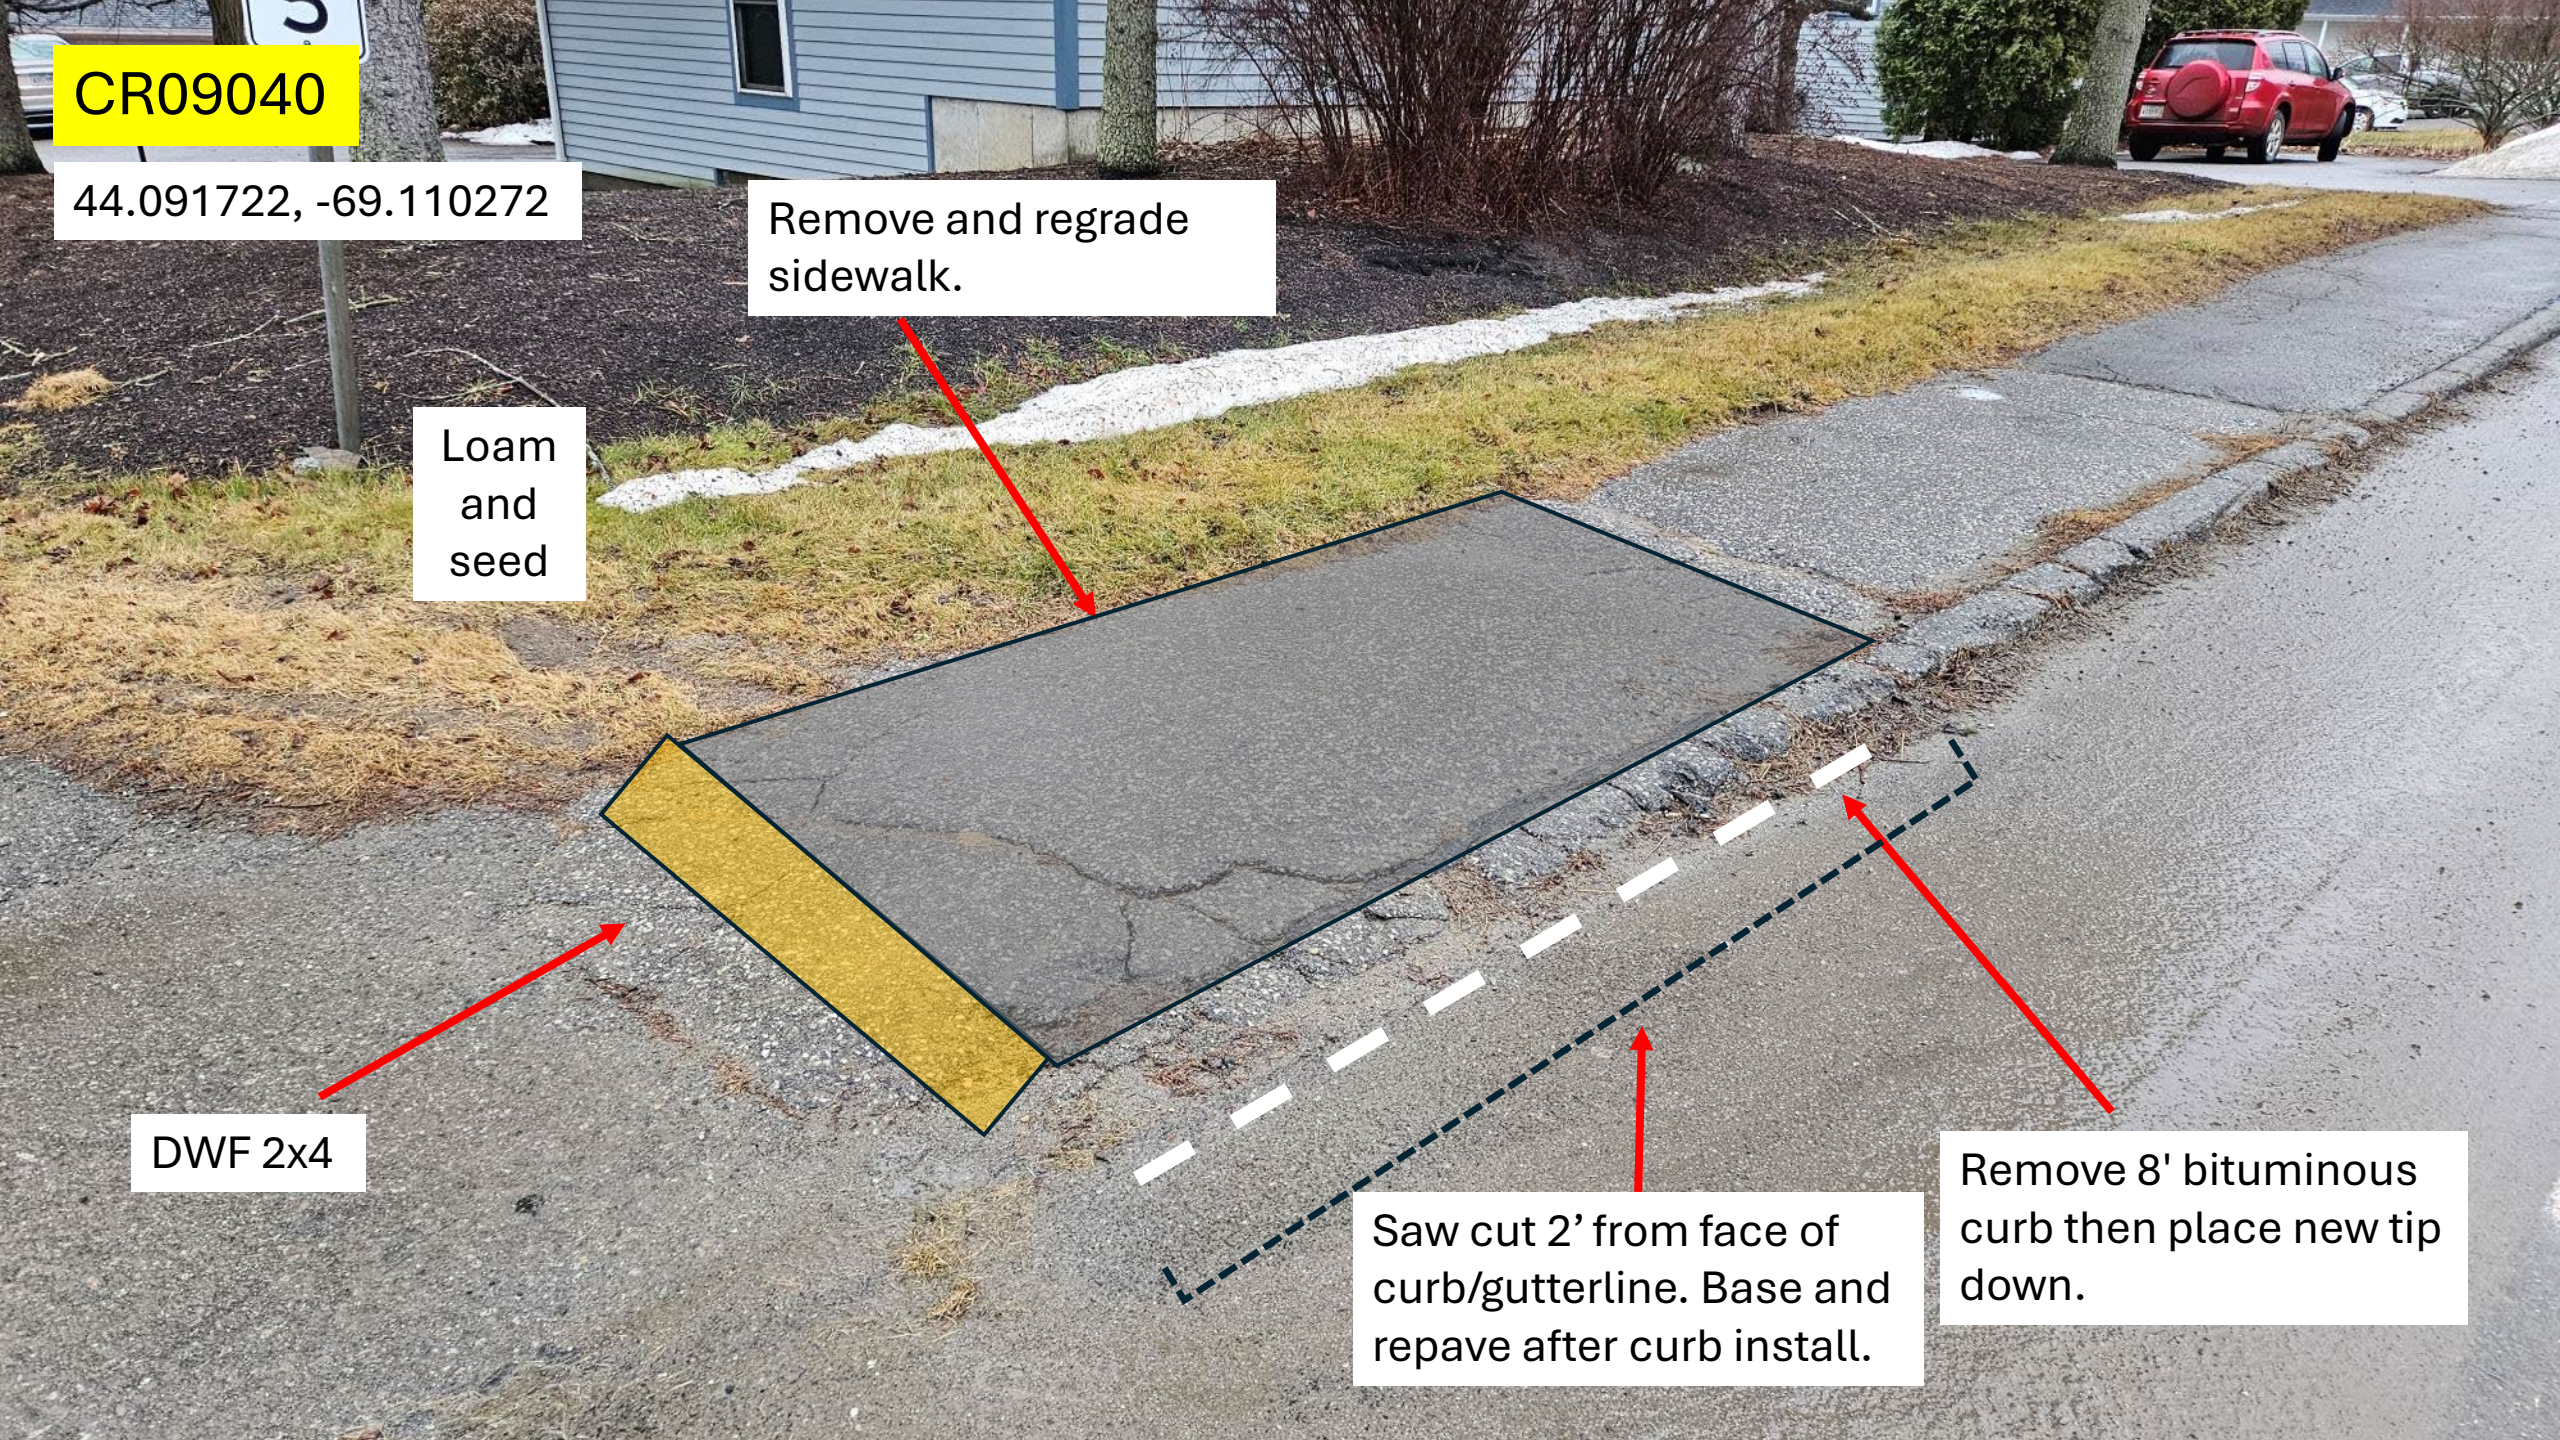



RAMP REPORT REGION 2 ADA 2026

Belyea Ave, Glen St. & Pen Bay Ave,
Rockland

CR04136

44.123625, -69.099397


Remove and regrade
sidewalk.

Loam
and
seed.

Remove 15' bituminous
curb then place new tip
down.

DWF 2x4

Saw cut 2' from face of
curb/gutterline. Base and
repave after curb install.

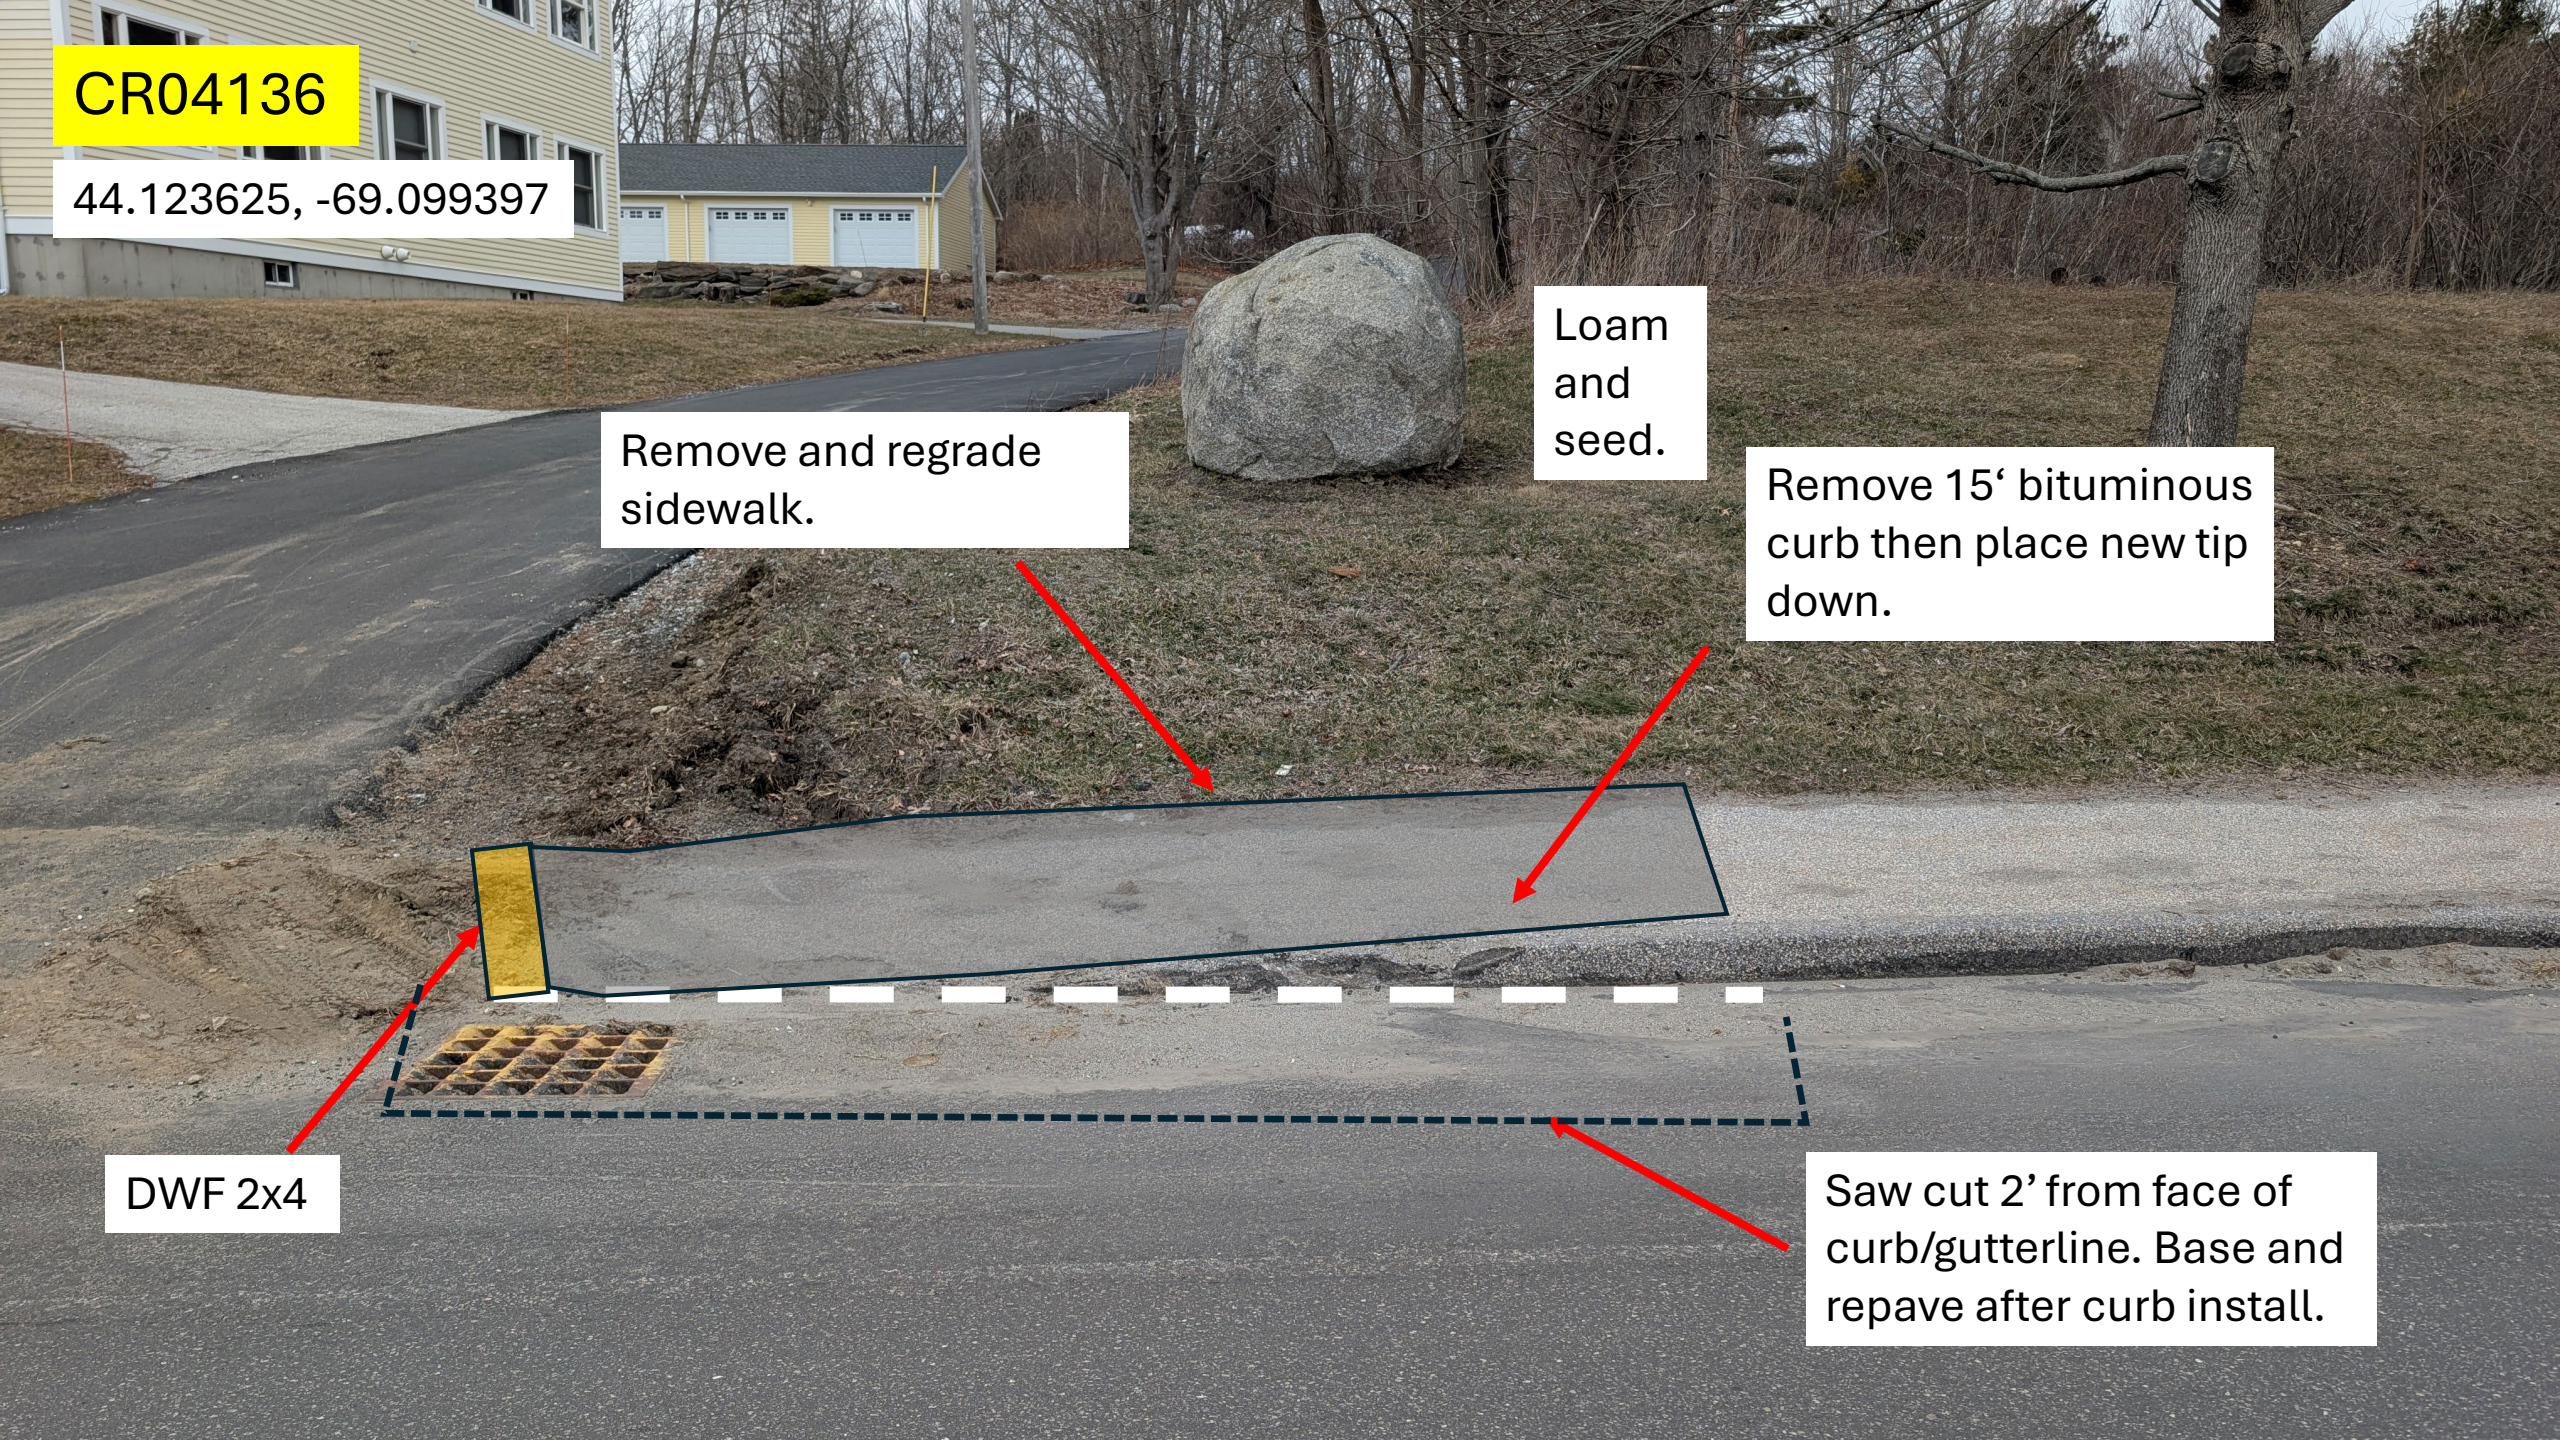

CR16757

44.123567, -69.099433


Remove and regrade sidewalk.

Loam and seed.

Remove 12' bituminous curb then place new tip down.


Saw cut 2' from face of curb/gutterline. Base and repave after curb install.

DWF 2x4

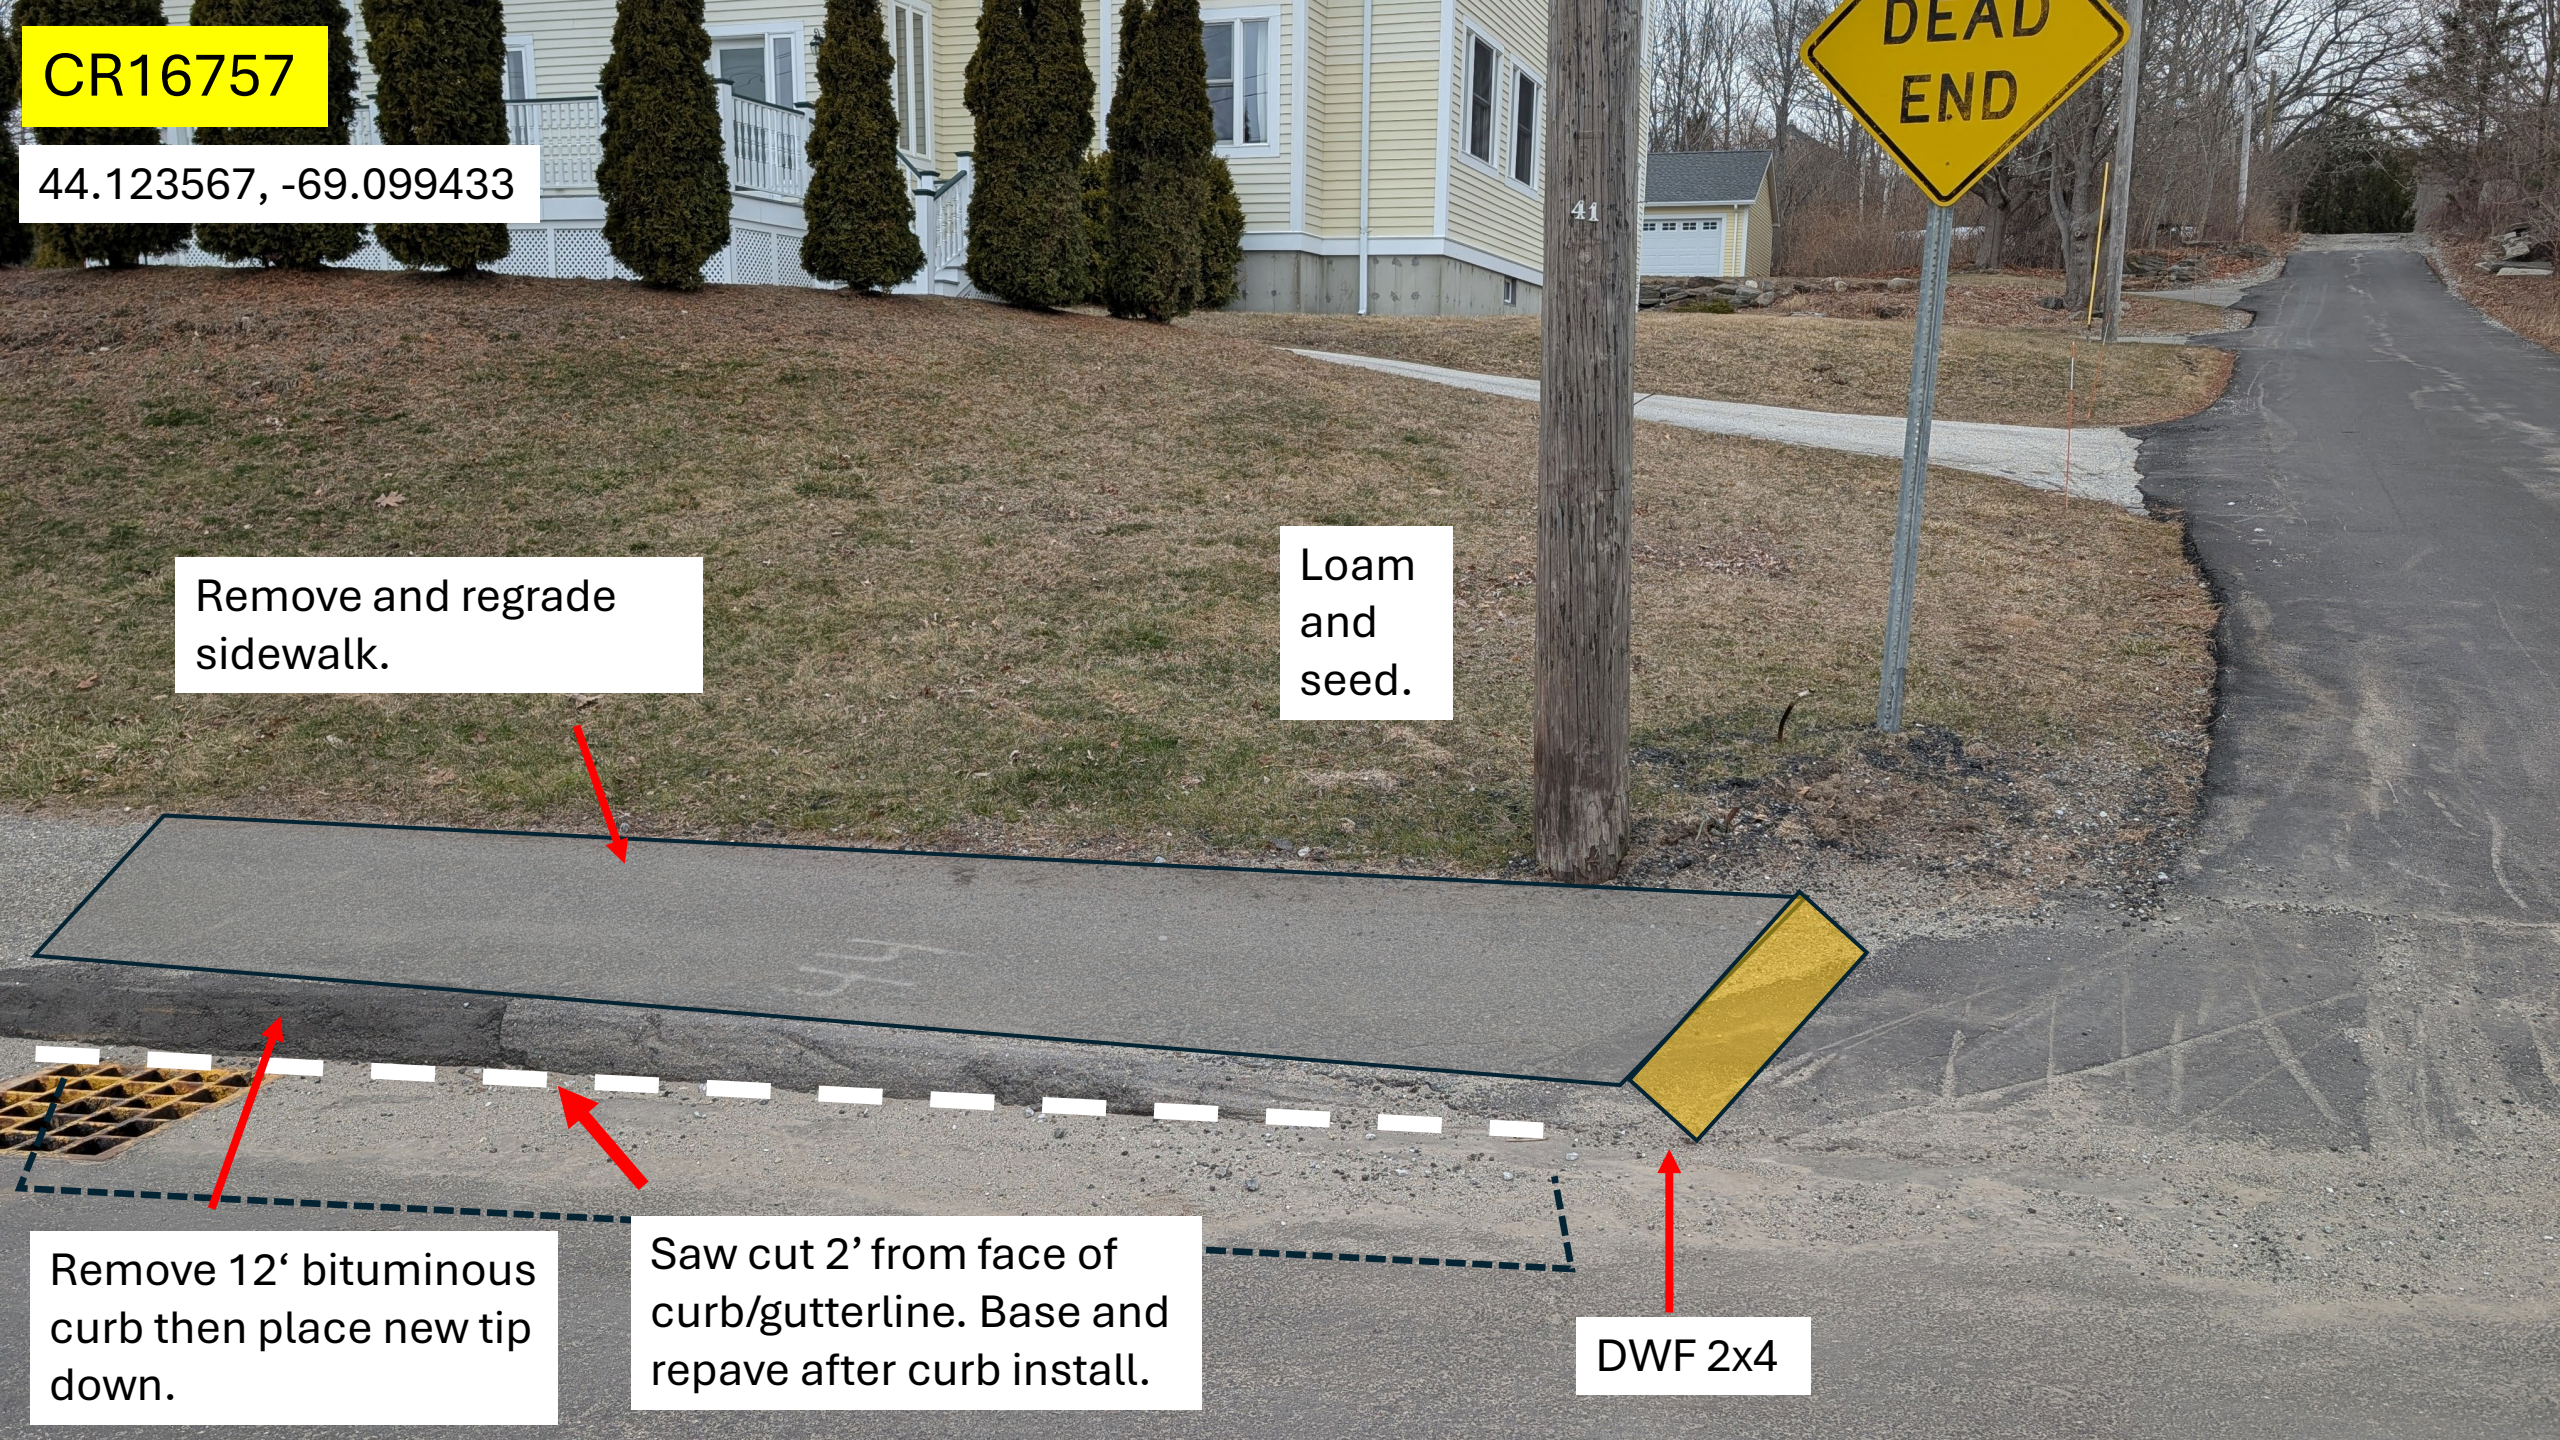

CR16761

44.123466, -69.099164

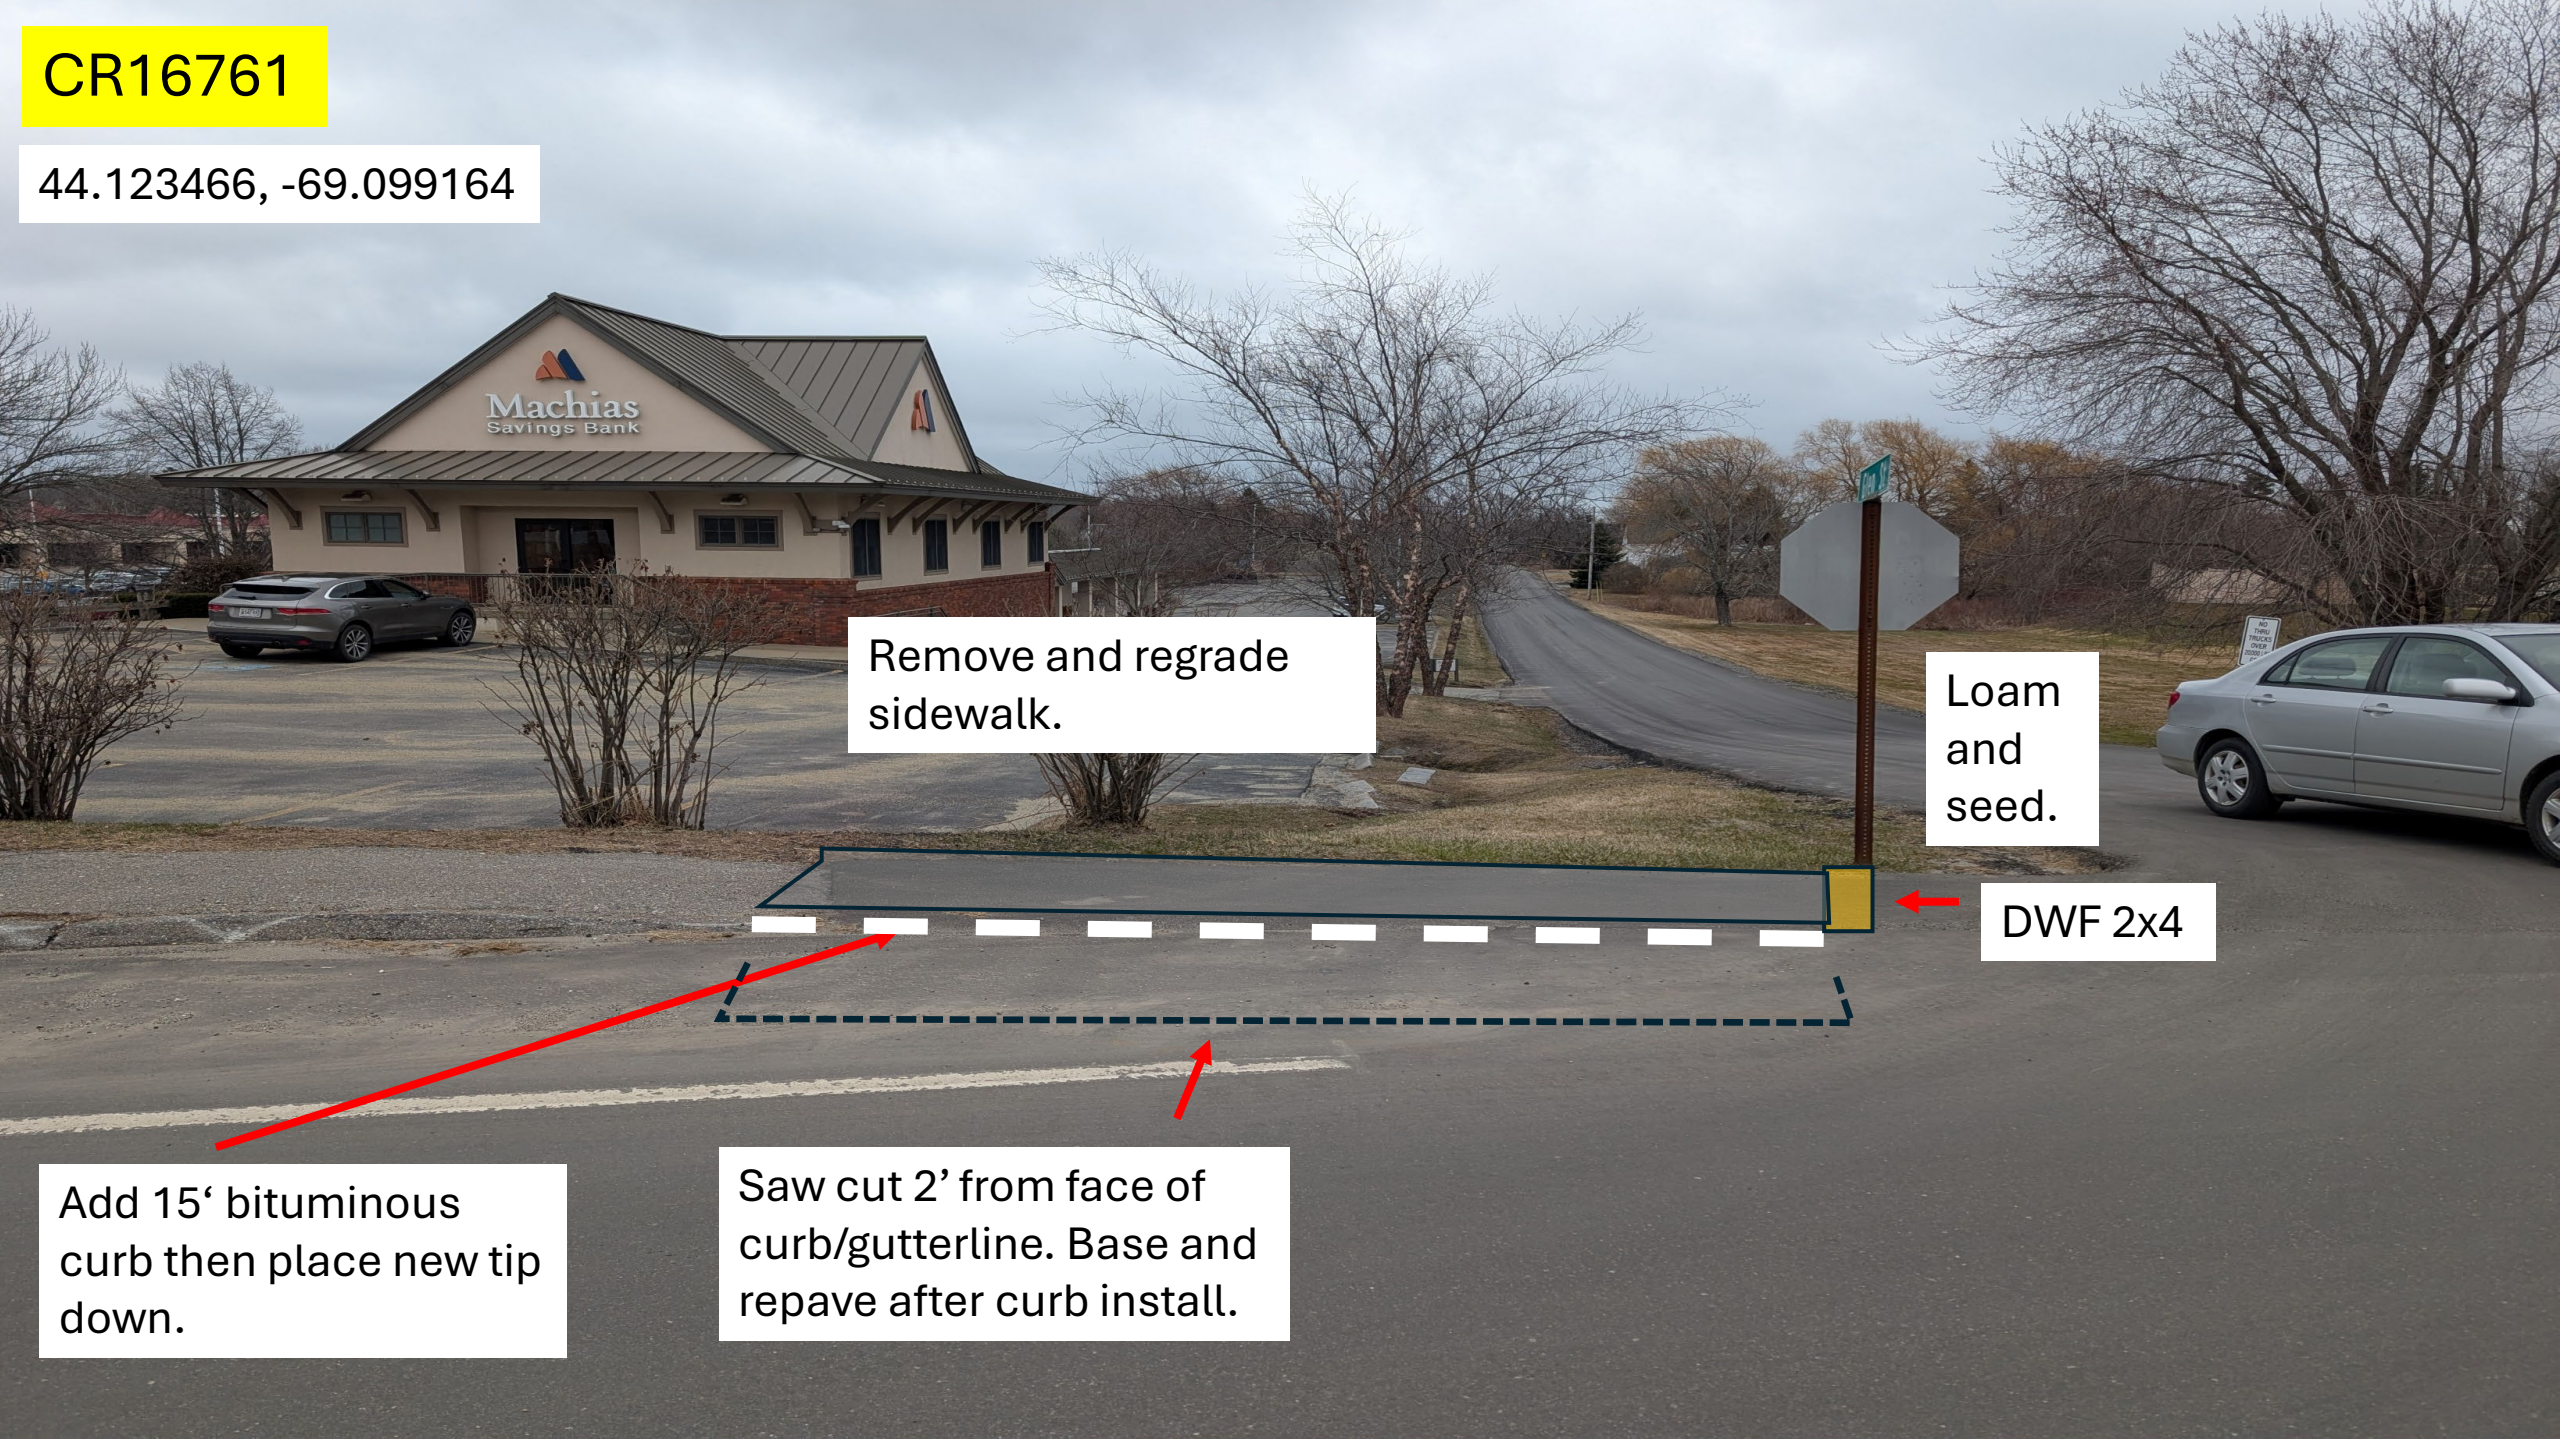

Remove and regrade sidewalk.

Loam and seed.


DWF 2x4

Add 15' bituminous curb then place new tip down.

Saw cut 2' from face of curb/gutterline. Base and repave after curb install.

CR16760

44.123342, -69.099207

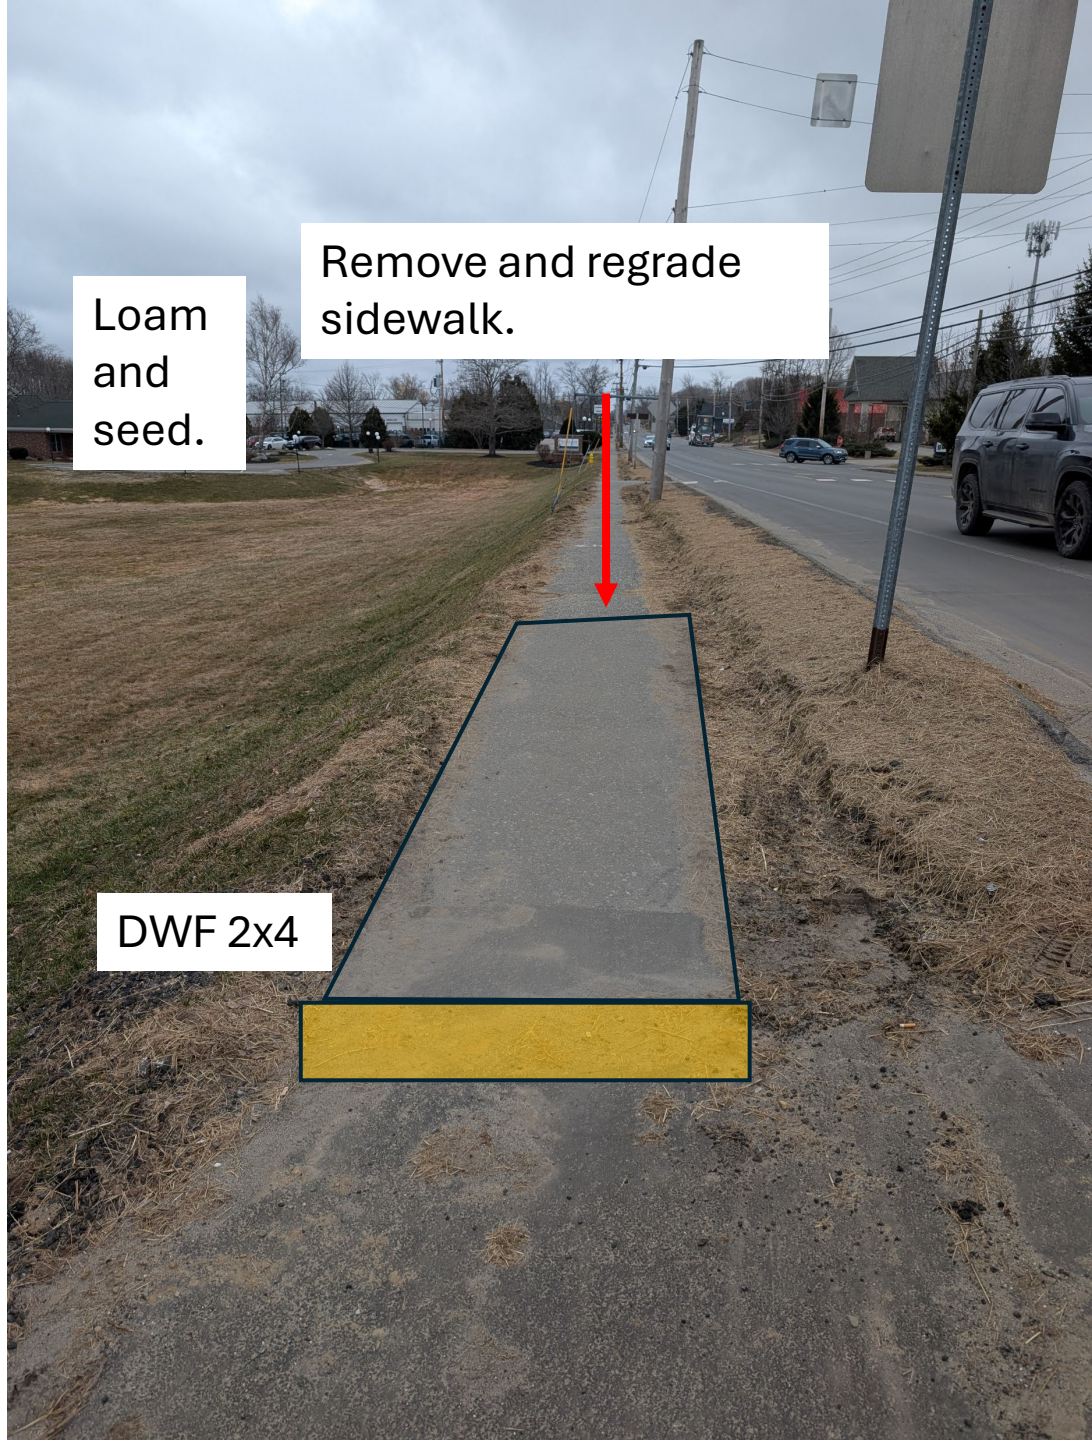

Loam
and
seed.

Remove and regrade
sidewalk.

DWF 2x4

CR04134

44.123214, -69.099694


Loam
and
seed.

Remove and regrade
sidewalk.

DWF 2x4


Remove 15' bituminous
curb then place new tip
down.

Saw cut 2' from face of
curb/gutterline. Base and
repave after curb install.

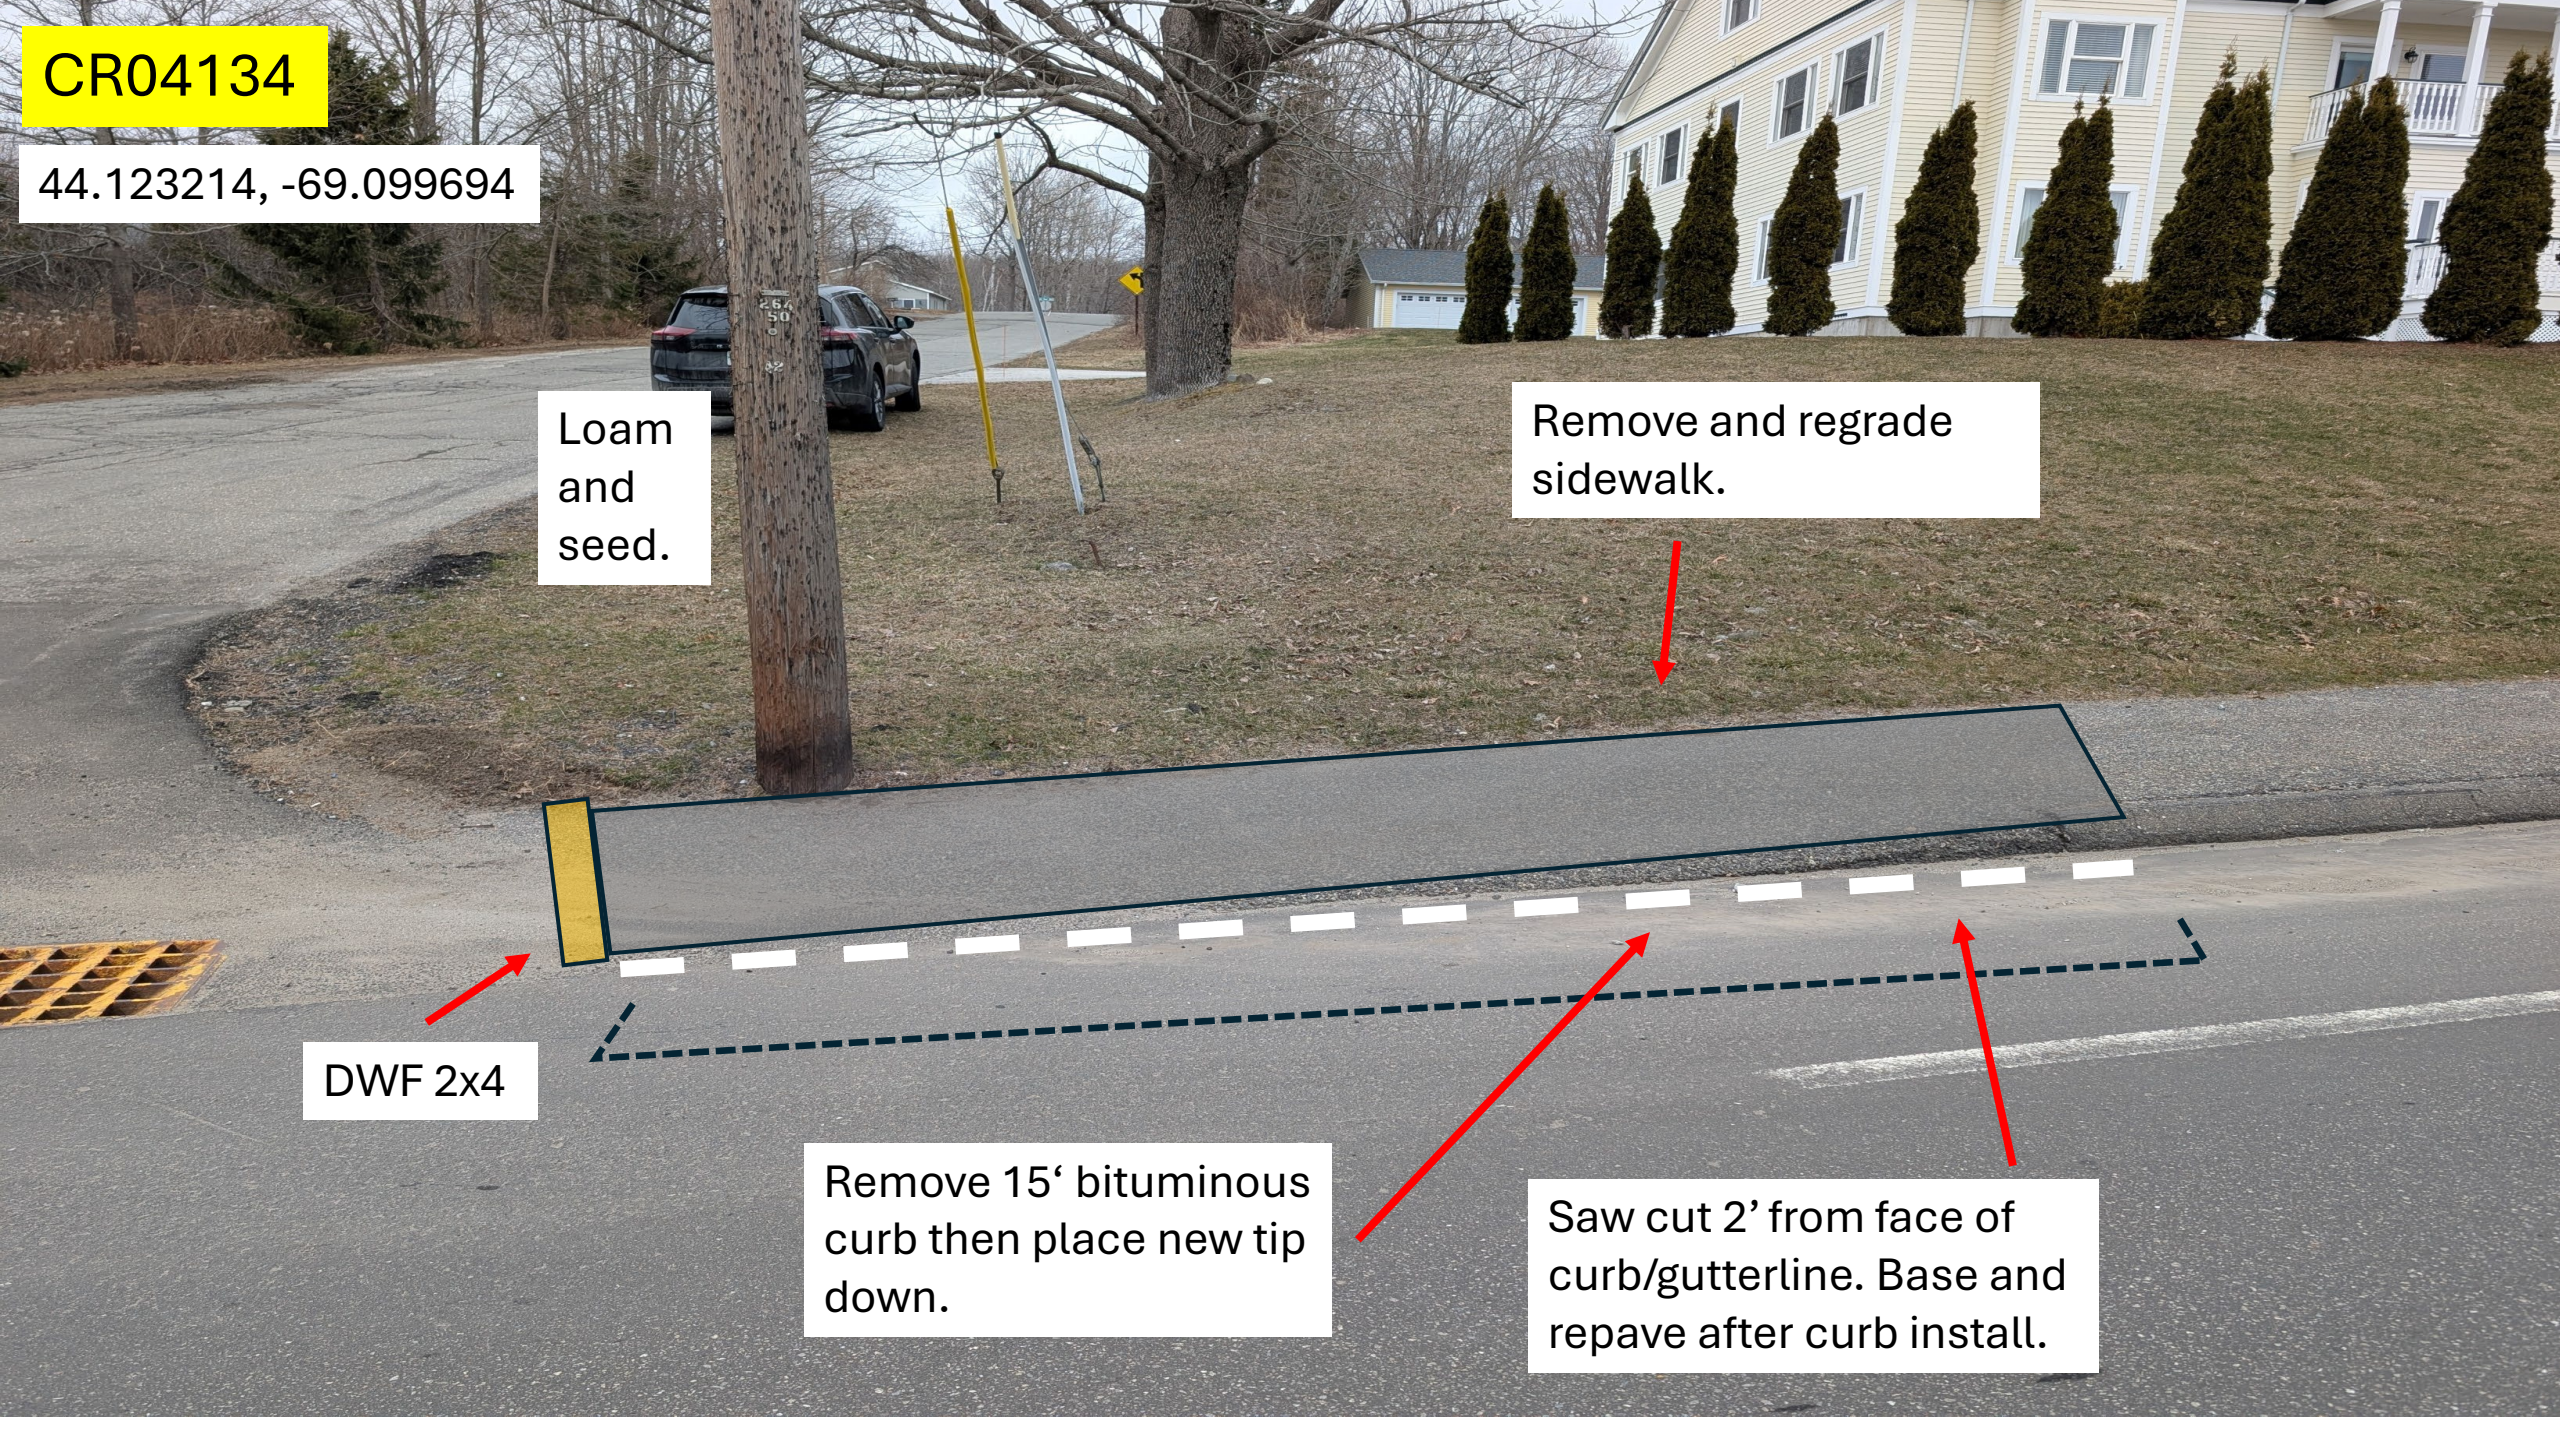

CR04135

44.123122, -69.099775

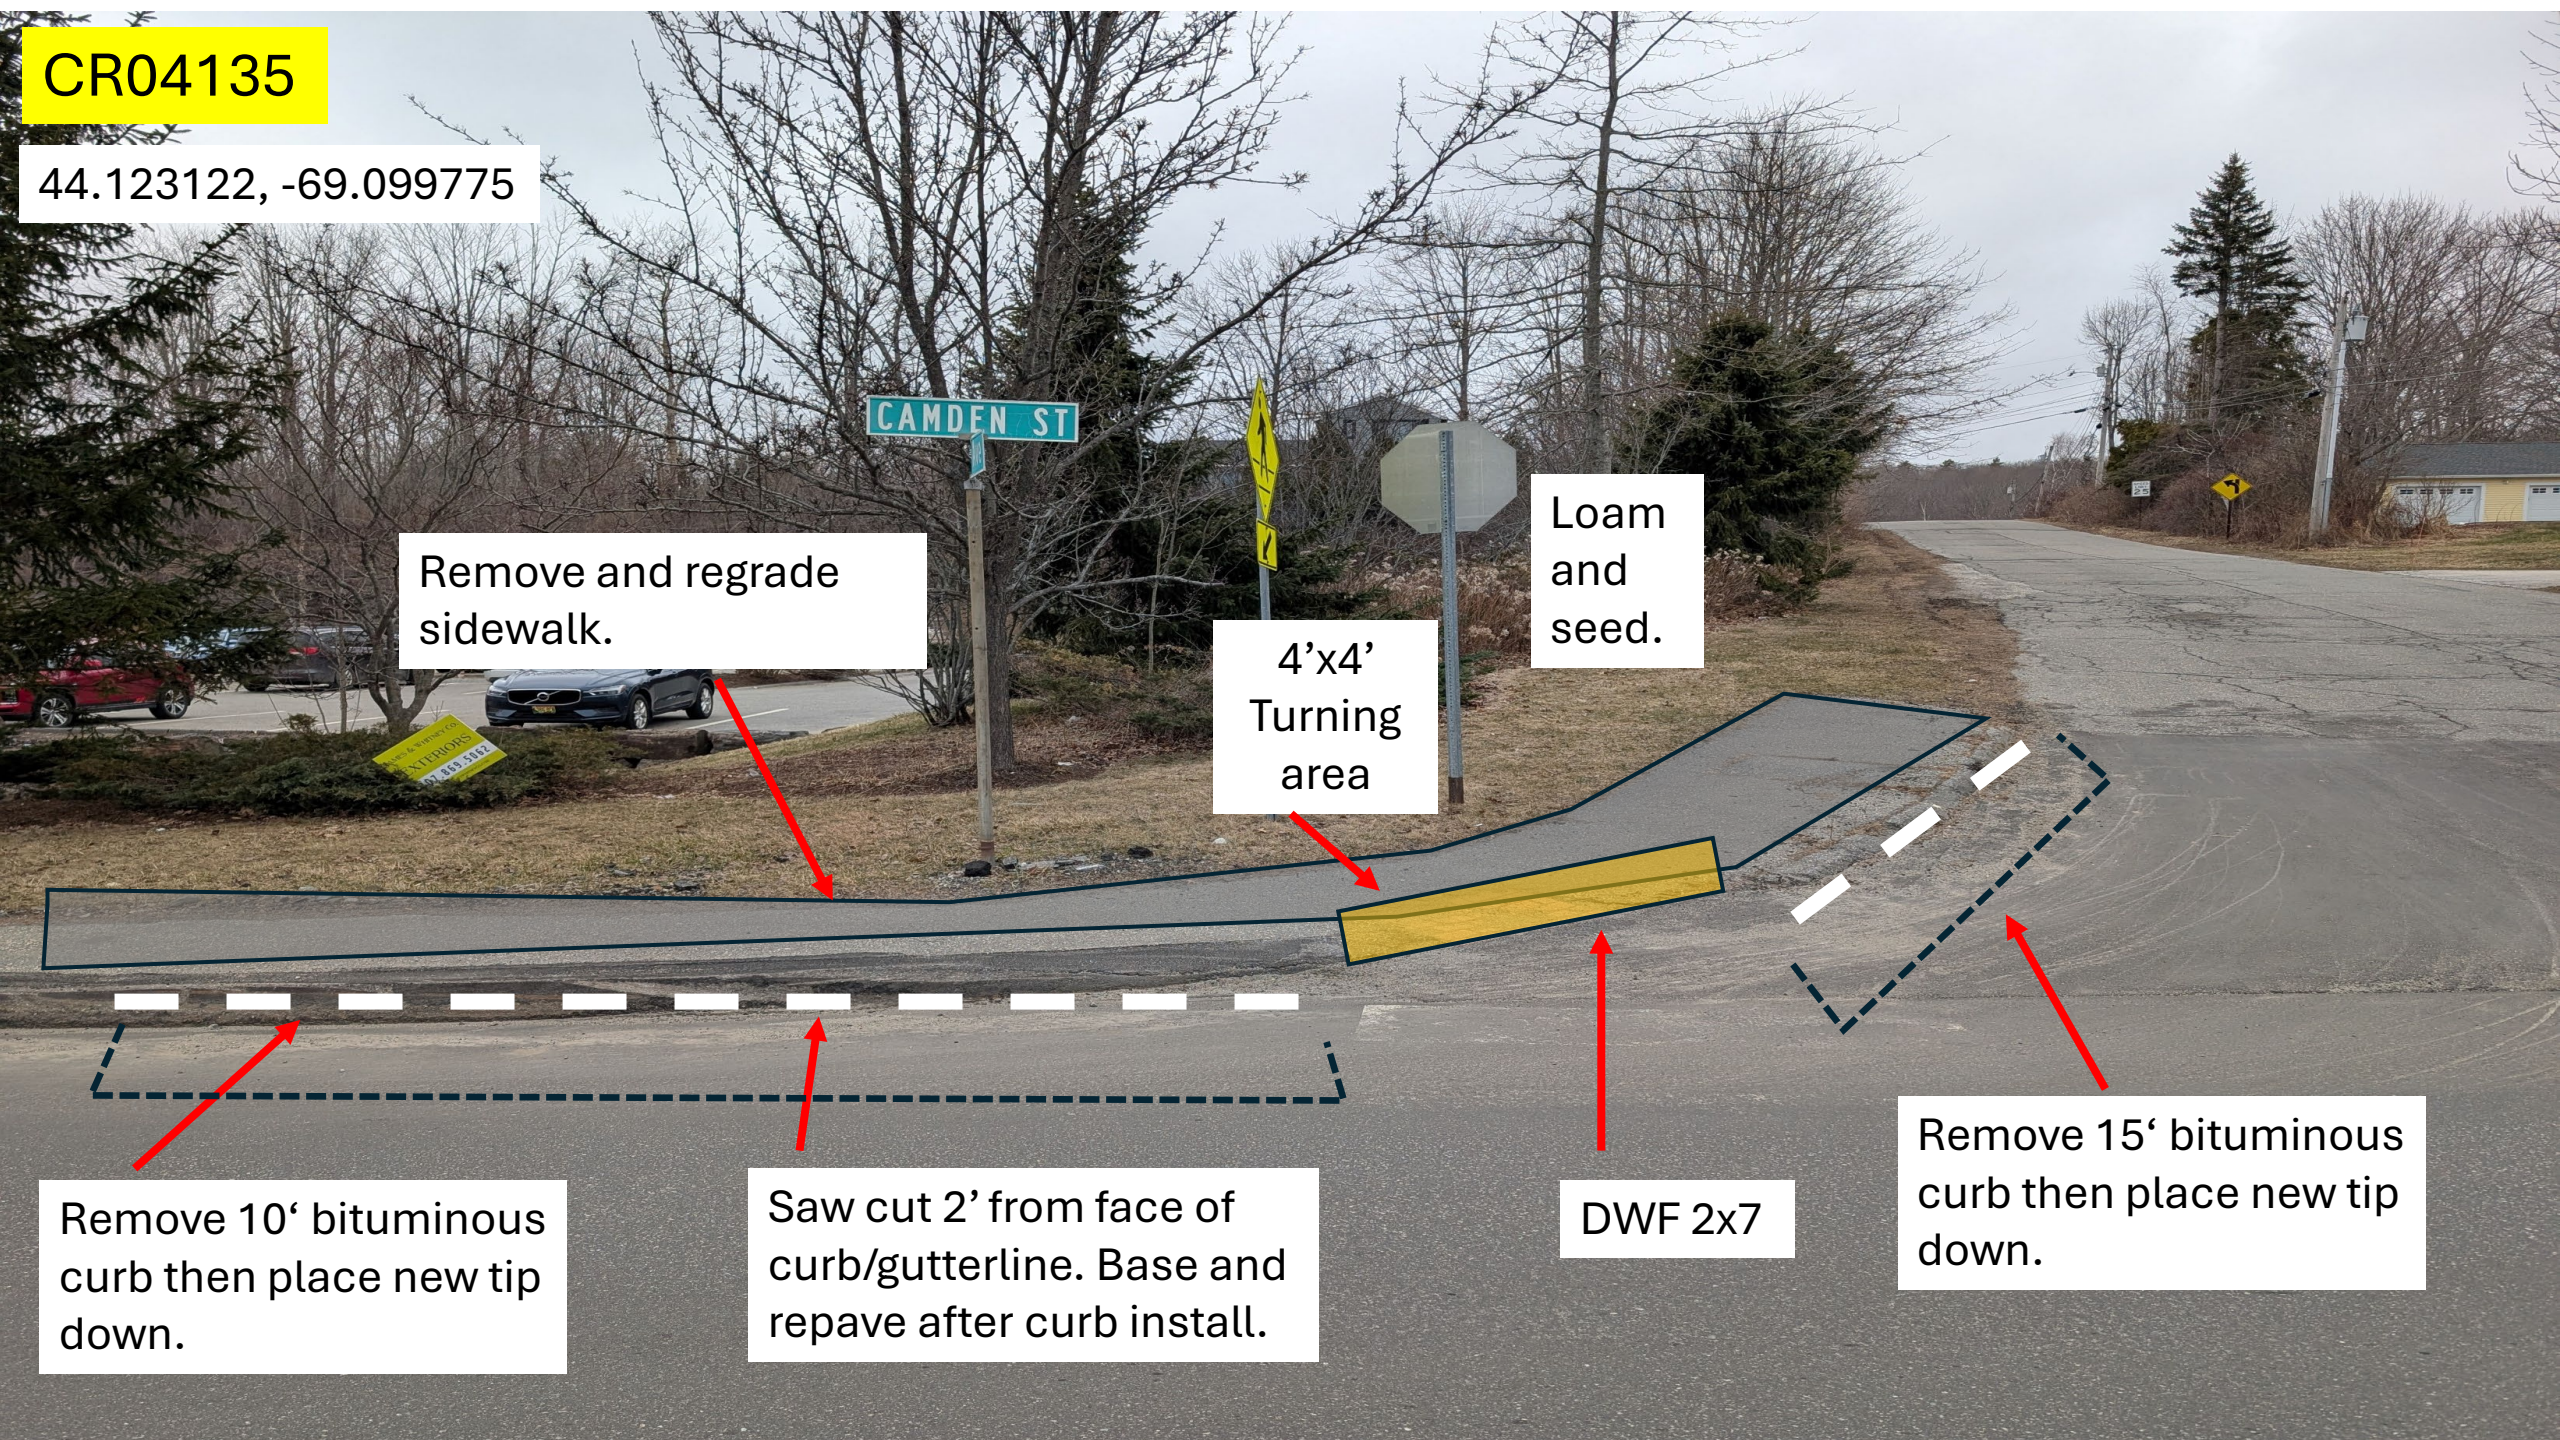

Remove and regrade sidewalk.

4'x4'
Turning
area

Loam
and
seed.

Remove 10' bituminous
curb then place new tip
down.

Saw cut 2' from face of
curb/gutterline. Base and
repave after curb install.

DWF 2x7

Remove 15' bituminous
curb then place new tip
down.

CR16770

44.123036, -69.099567



Loam
and
seed.

4'x4'
Turning
area

Remove and regrade
sidewalk.



DWF 2x10





*We are moving the crosswalk from CR16764-CR16763 to
CR16765-CR16762*

RAMP REPORT REGION 2 ADA 2026

Leavitt Coffin Drive and Waldo Ave,
Rockland

CR16764

44.120227, -69.101848

Remove and regrade
sidewalk.


DWF 2x6

4'x4'
Turning
Area

Replace 15' of
bituminous curb.

Saw cut 2' from face of
curb/gutterline. Base and
repave after curb install.

Replace/add new 25' of
bituminous curb.

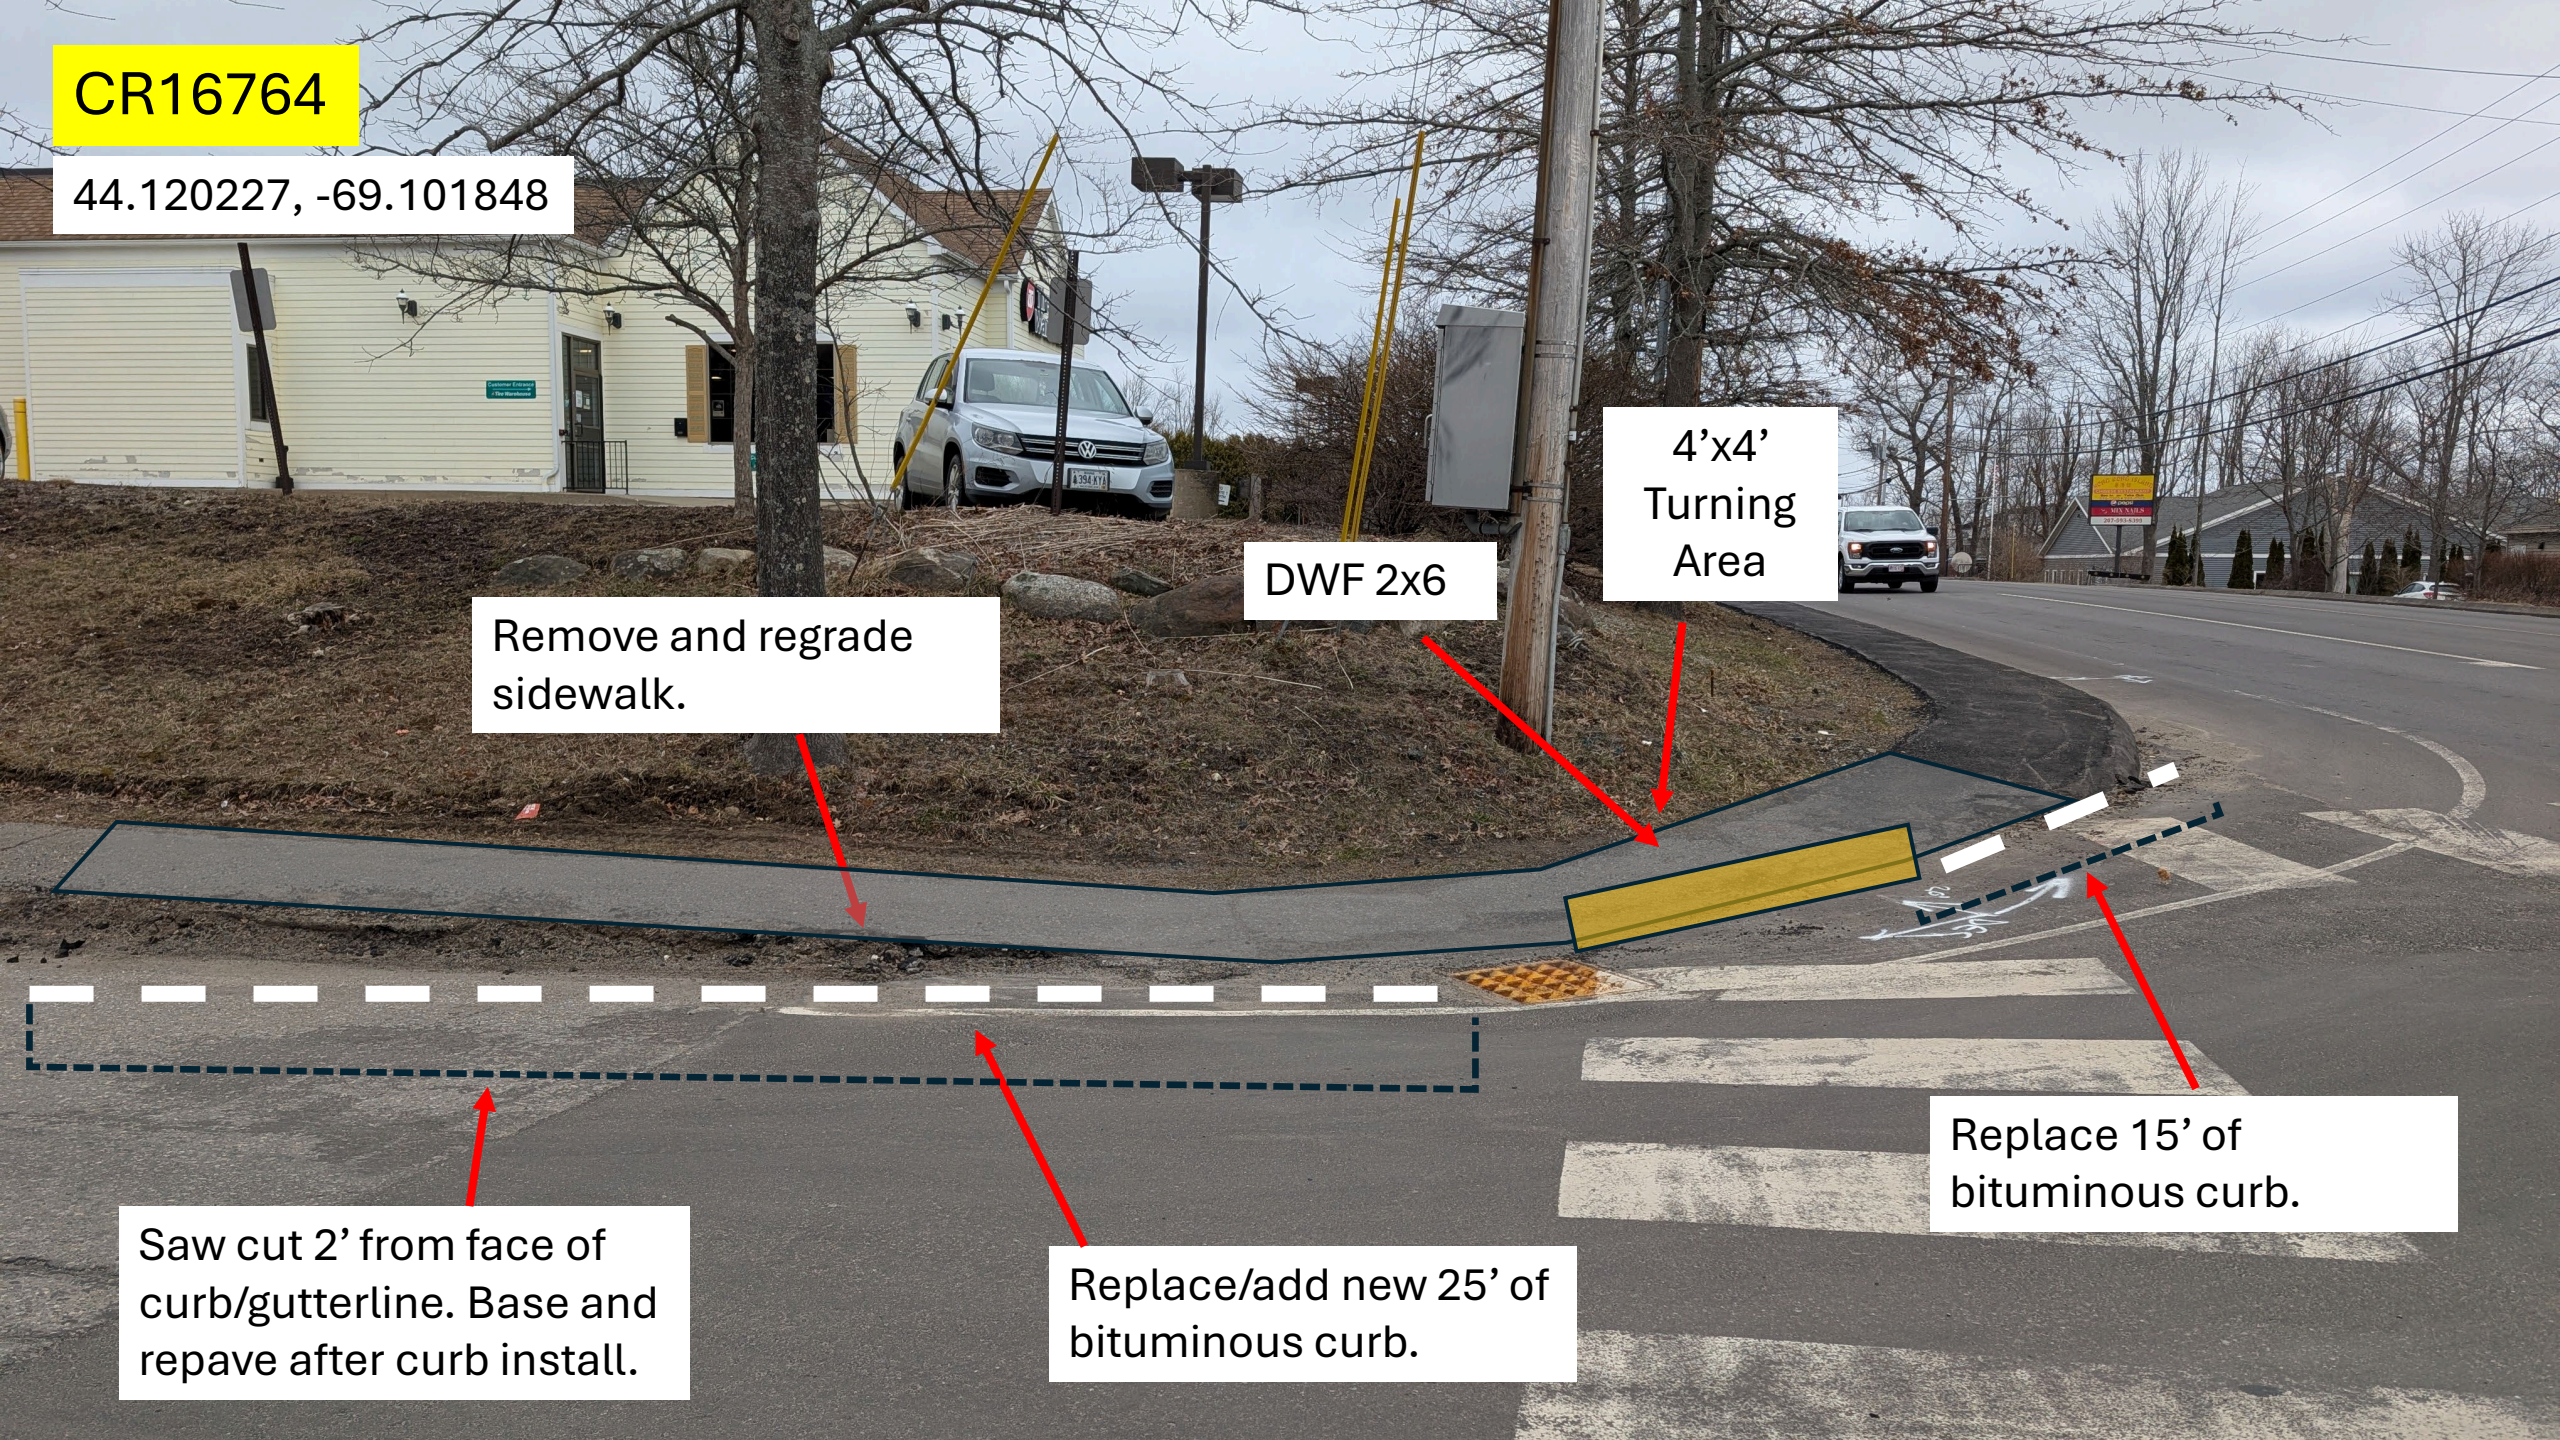

CR16765

44.11995, -69.101967

Add 15' bituminous curb.

Remove and regrade sidewalk.


Loam and seed.

4'x4' Turning Area

Saw cut 2' from face of curb/gutterline. Base and repave after curb install.

DWF 2x5

There A water issue here and we may need to adjust CB. Field Review.

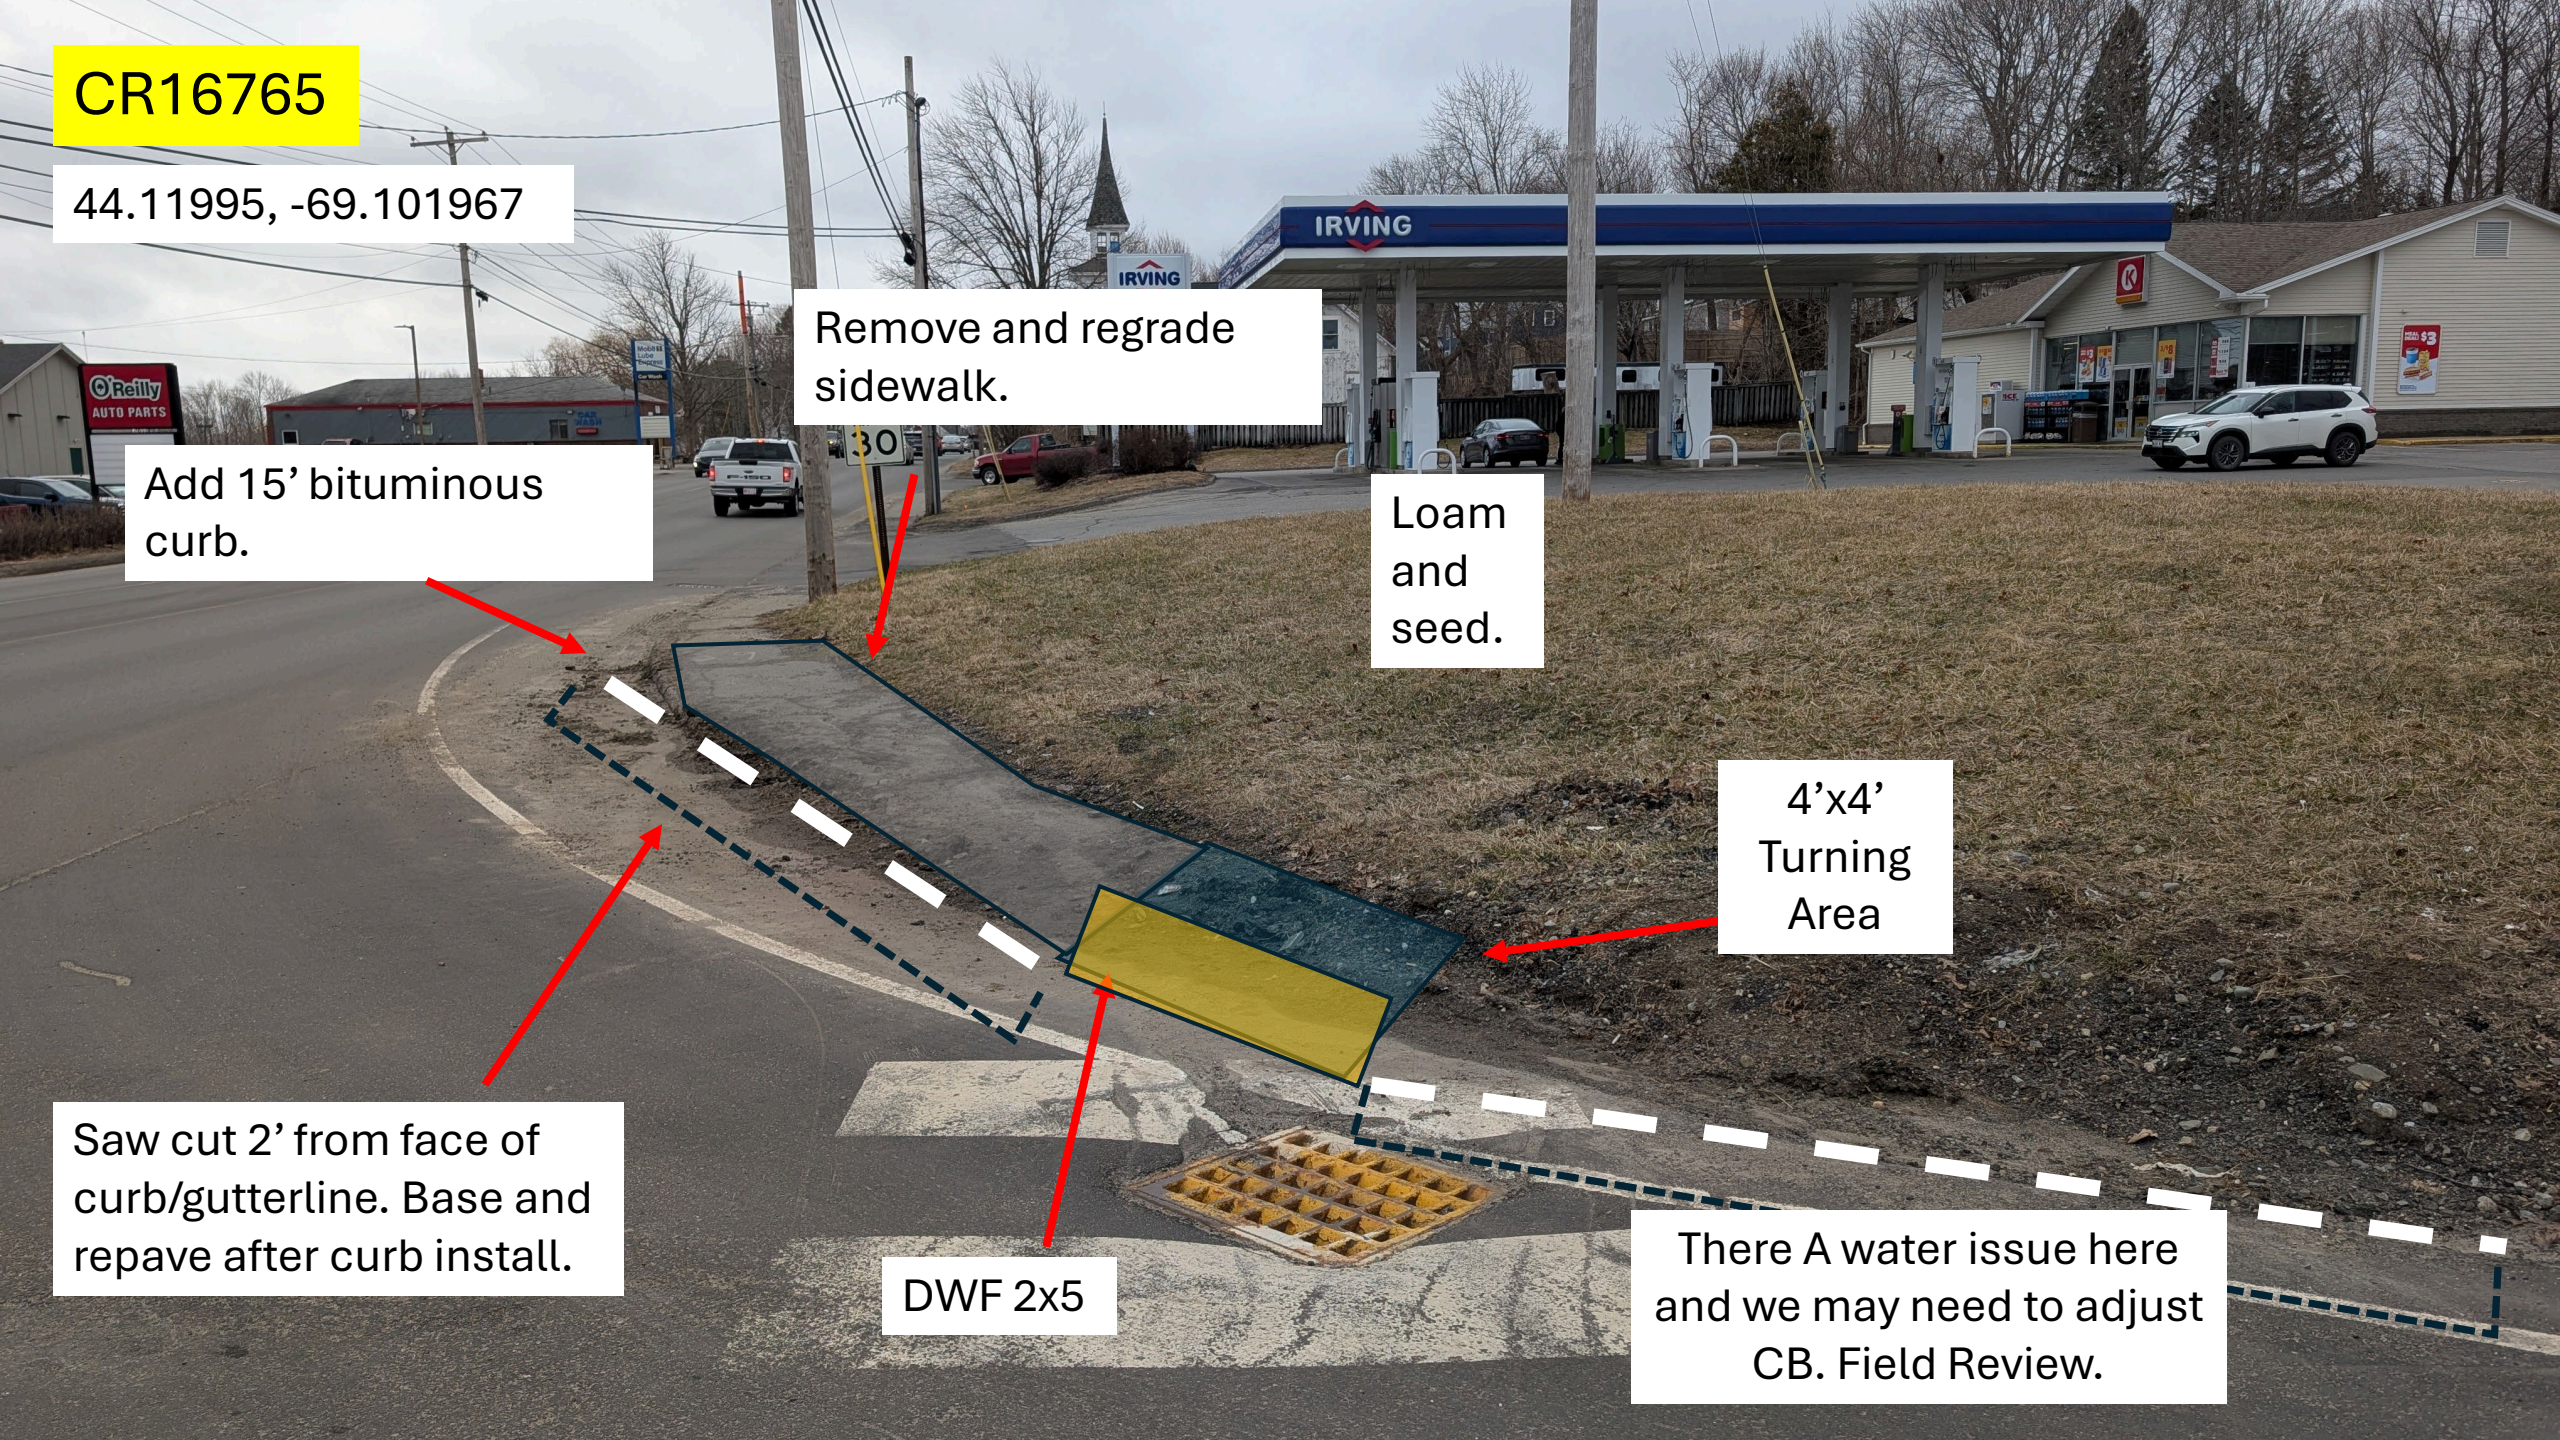

CR16763

44.120065, -69.10129

Remove and regrade
sidewalk.

Loam
and
seed.

DWF 2x4



CR16762


44.119849, -69.101444

Loam
and
seed.

Remove and regrade
sidewalk.

4'x4'
Turning
Area

DWF 2x4

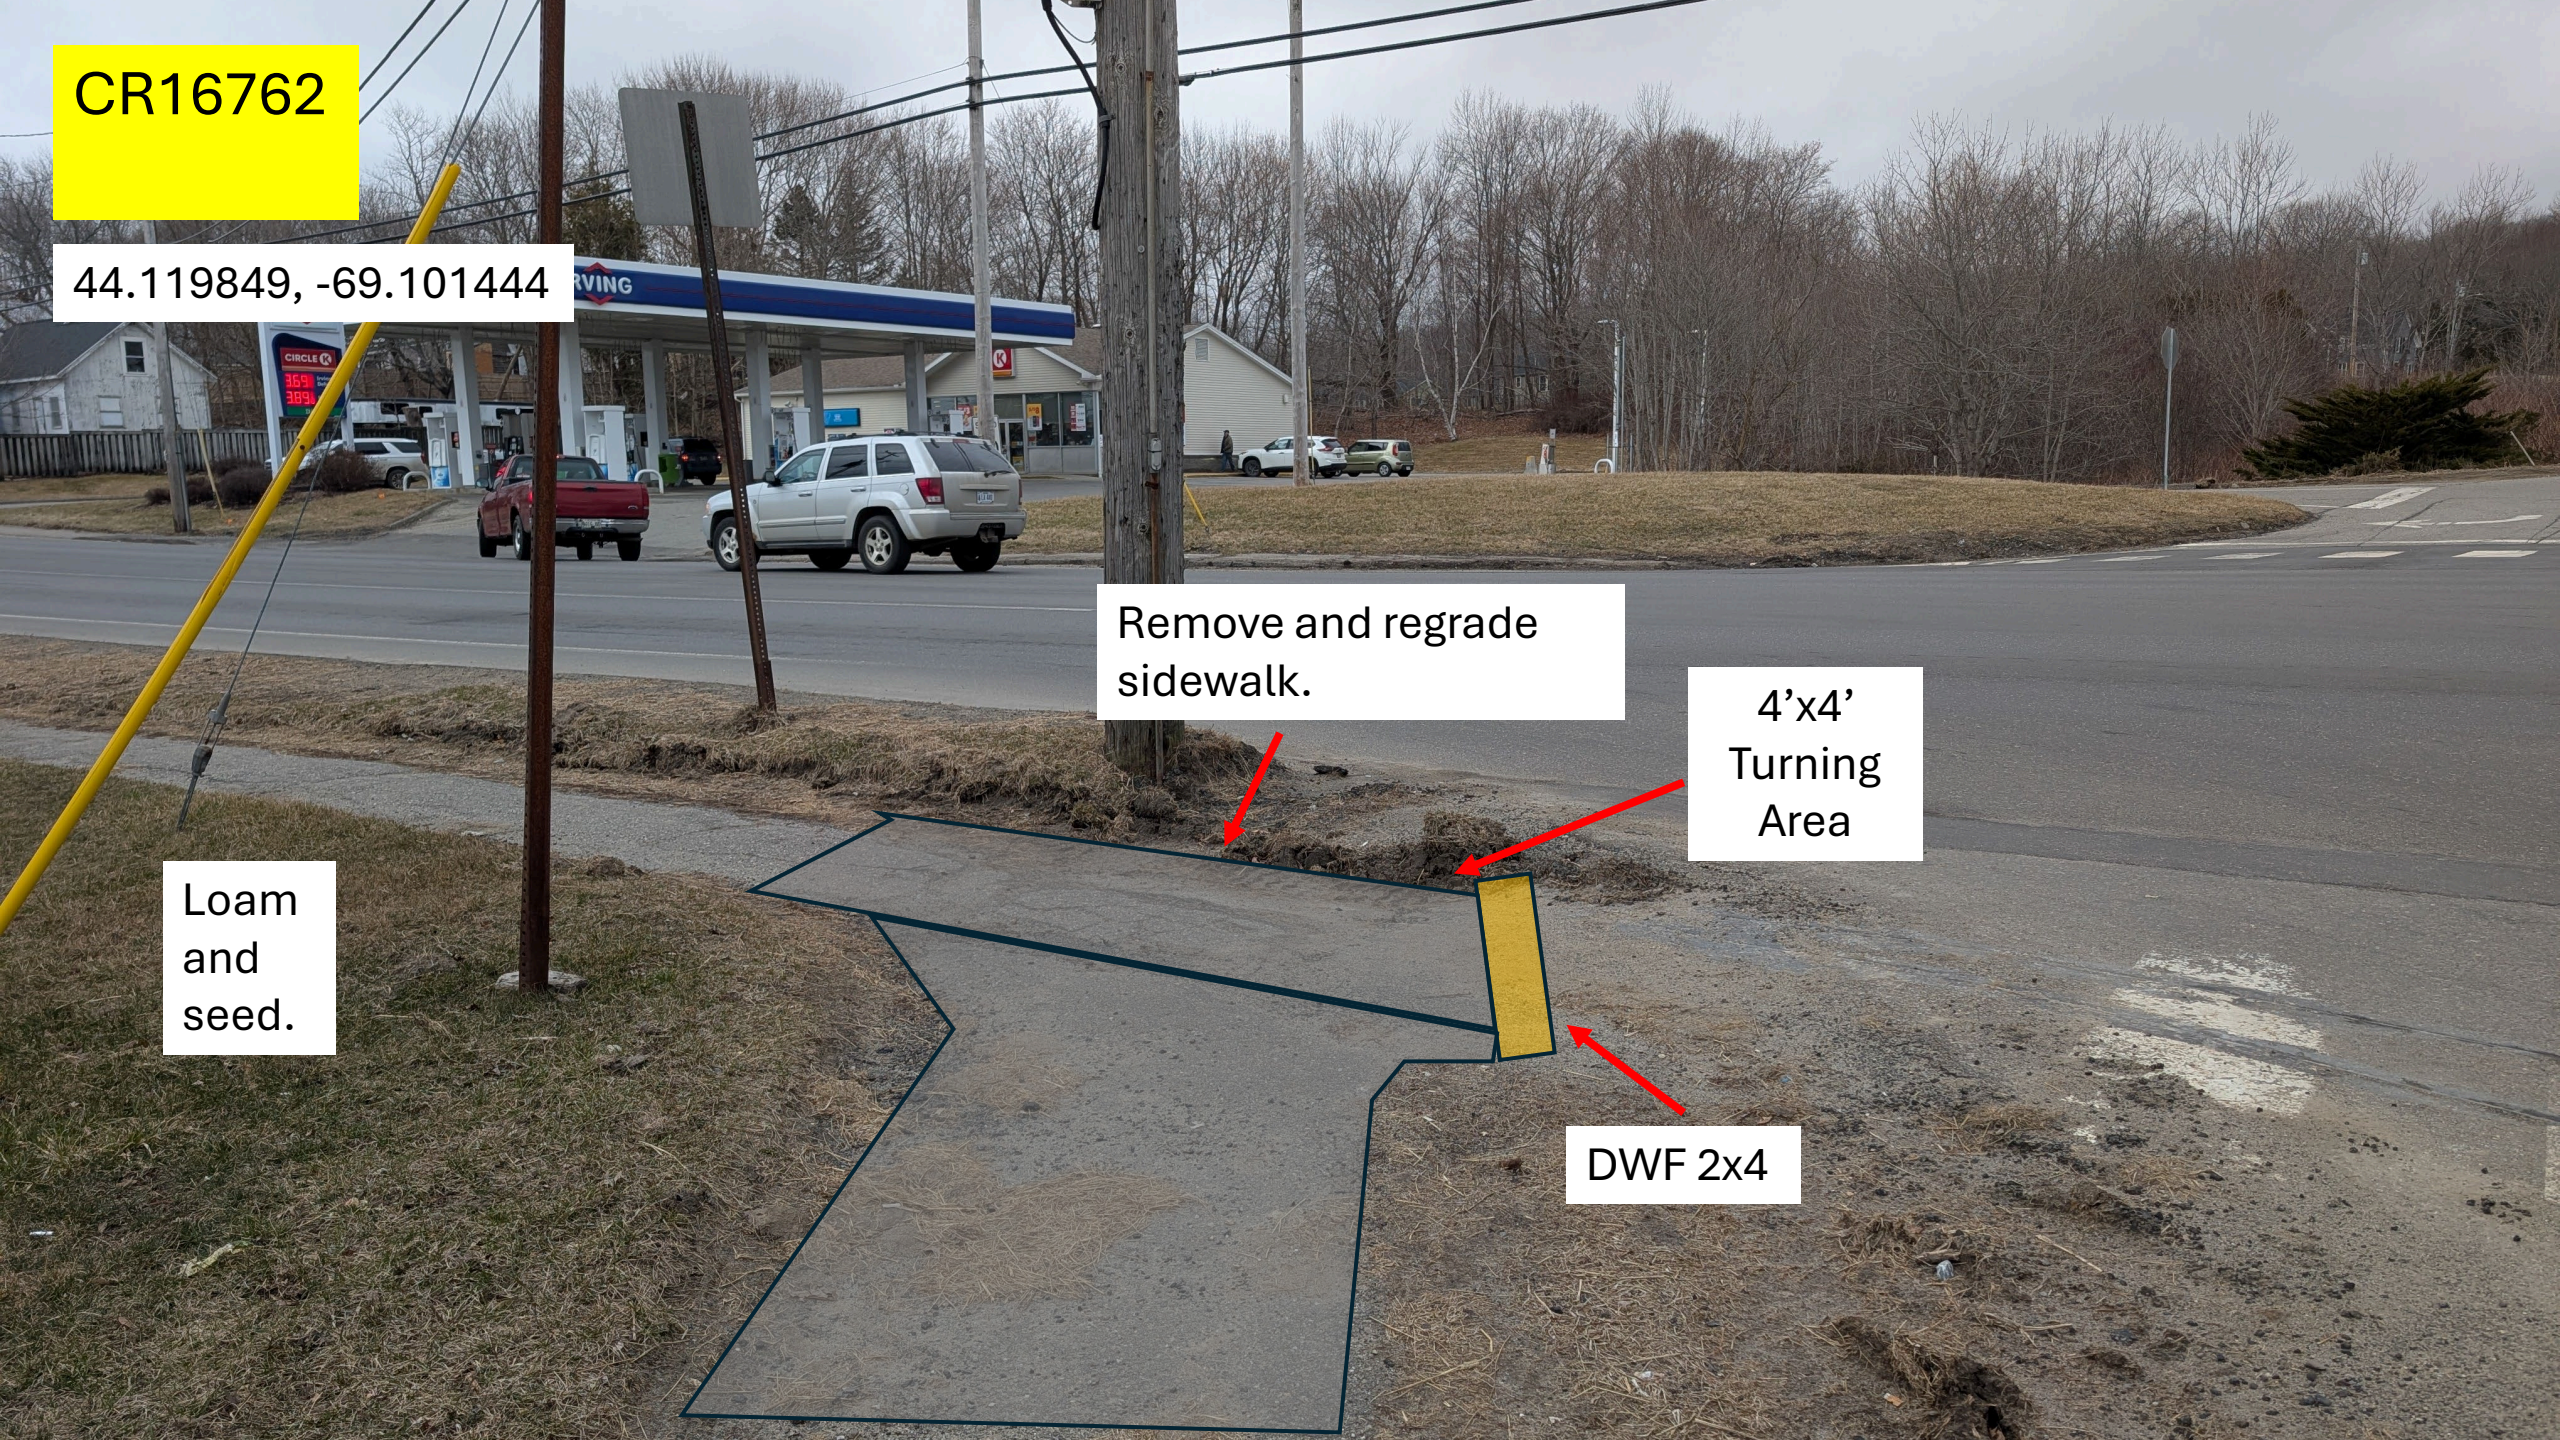



RAMP REPORT REGION 2 ADA 2026

Fales St,
Rockland


CR04132

44.11759, -69.103071

Remove and regrade sidewalk.

Loam
&
Seed

DWF 2x4

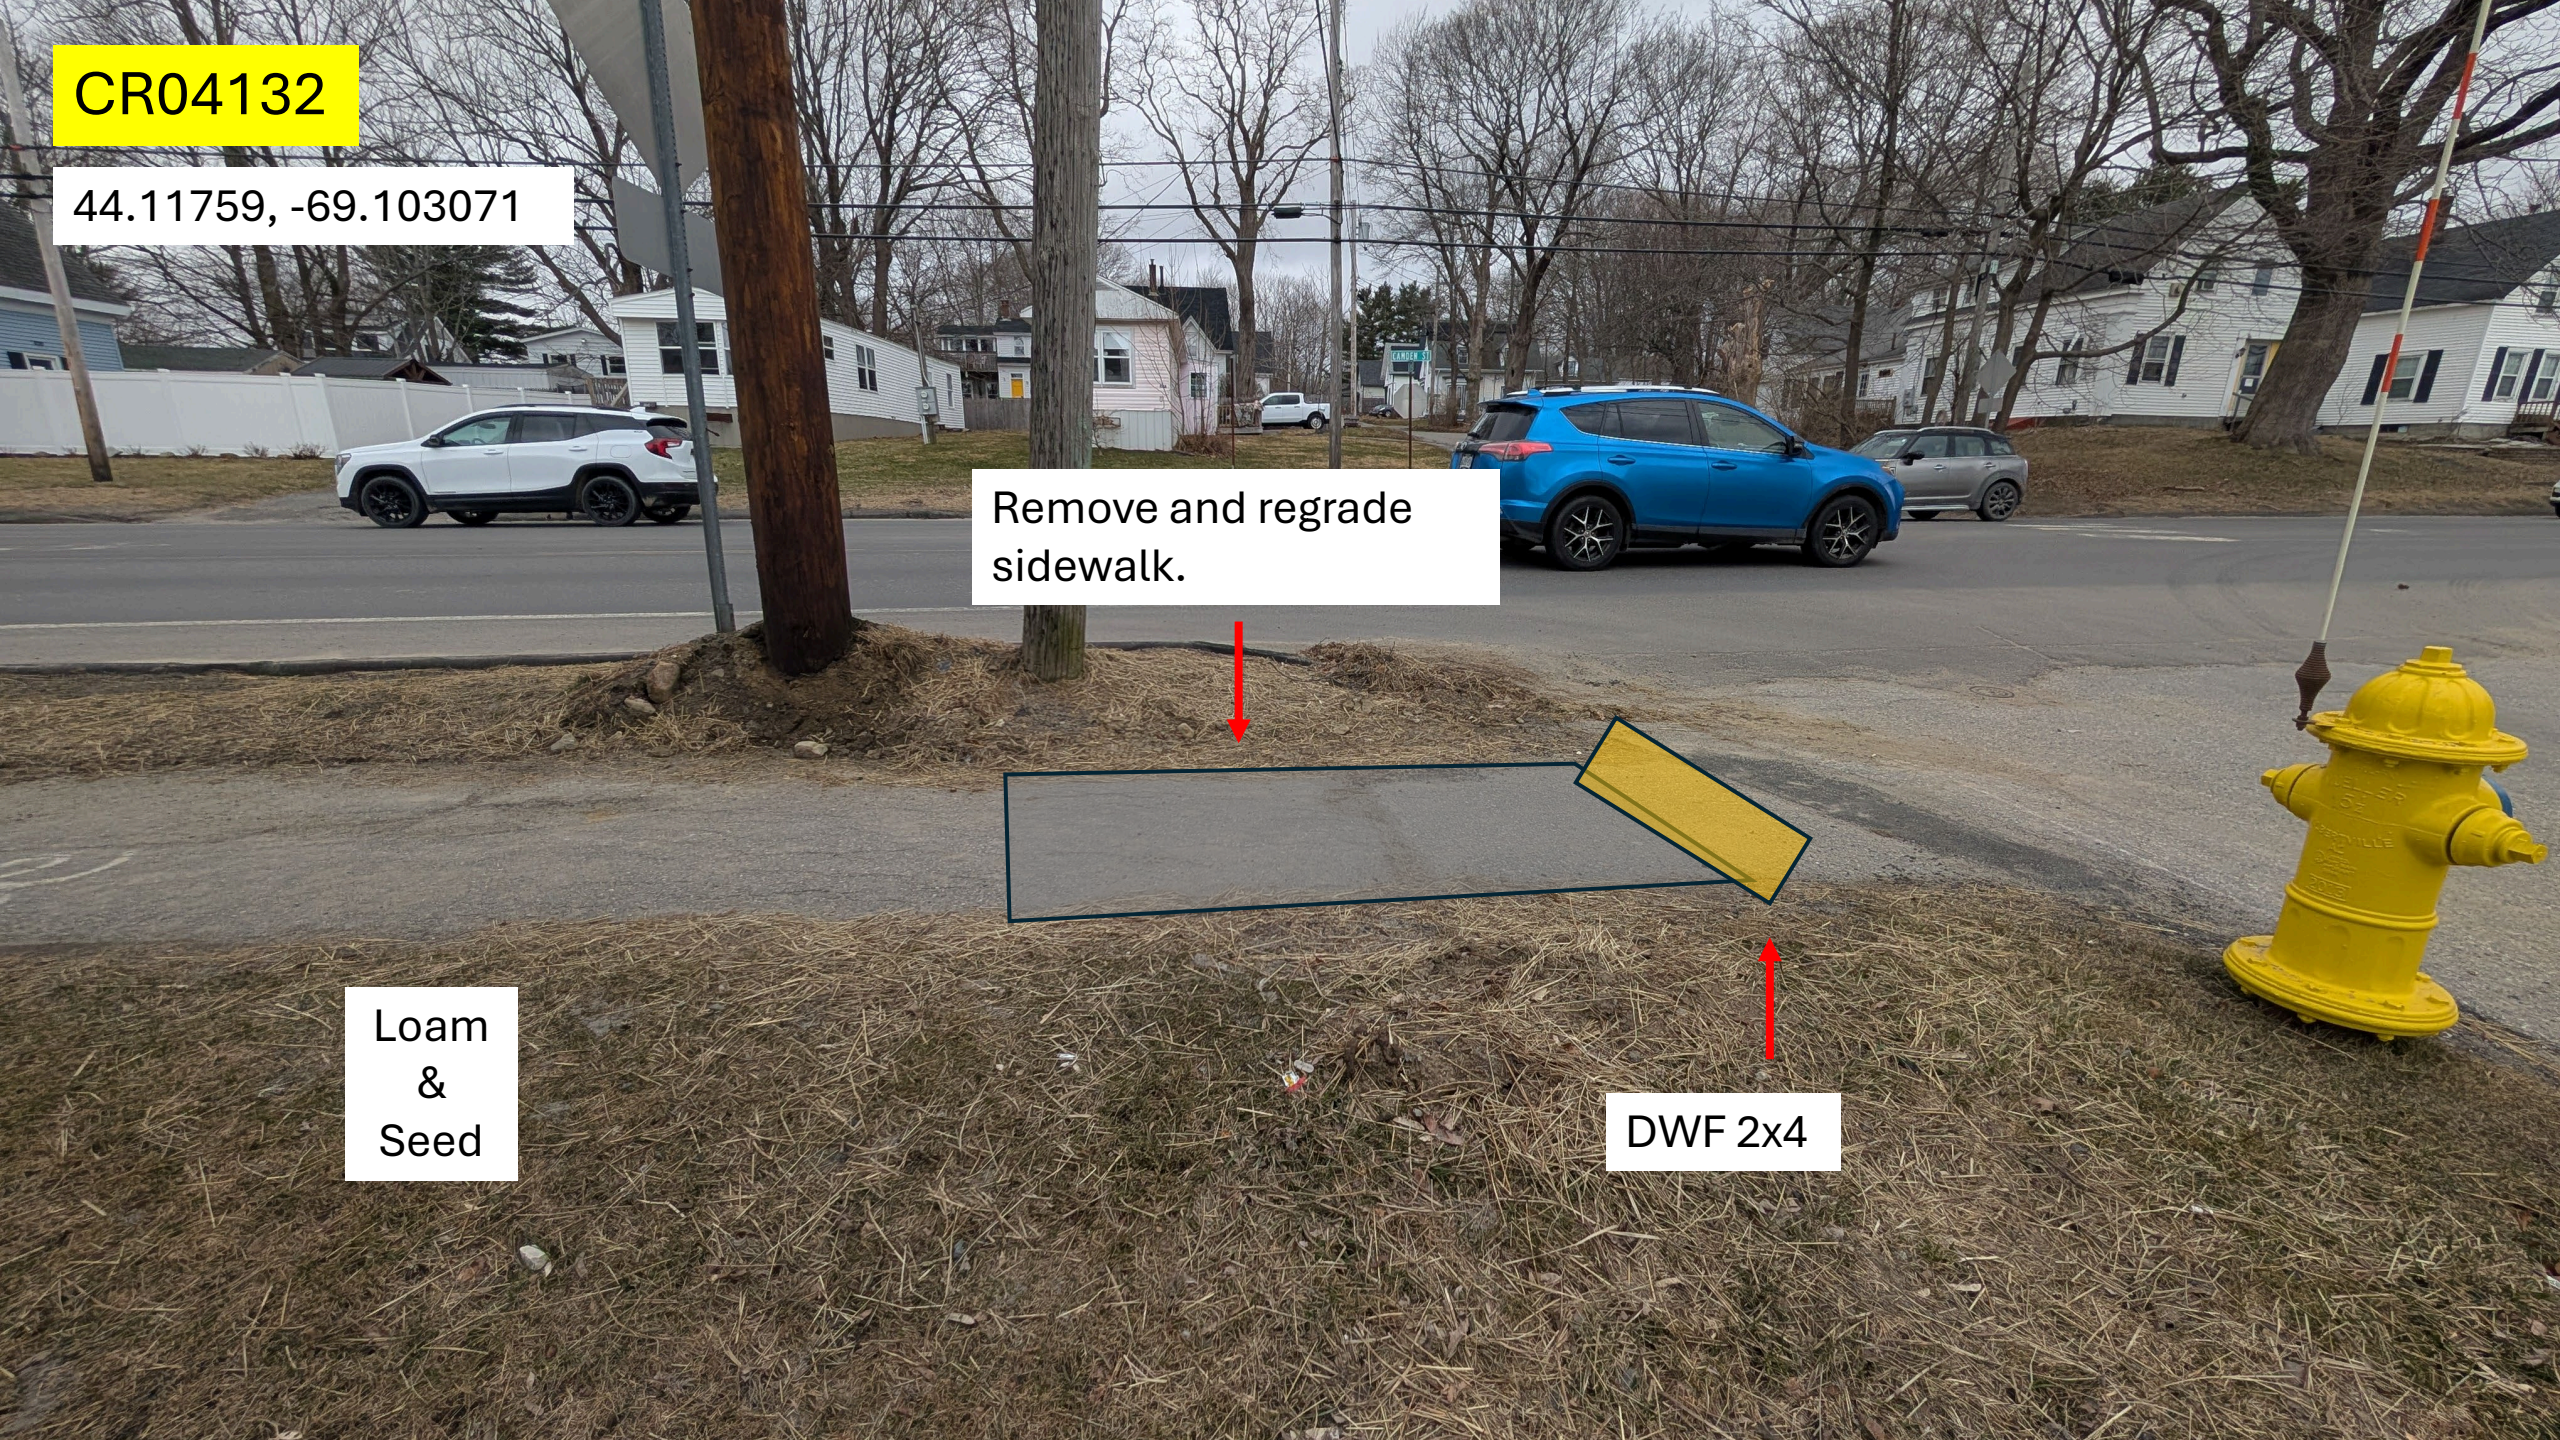

CR04130


44.117654, -69.103031

Remove and regrade
sidewalk.

Saw cut 2' from face of
curb/gutterline. Base and
repave after curb install.
Both sides of island.

Remove 15' bituminous
curb then place new tip
down. Both sides of
island.

DWF 2x4

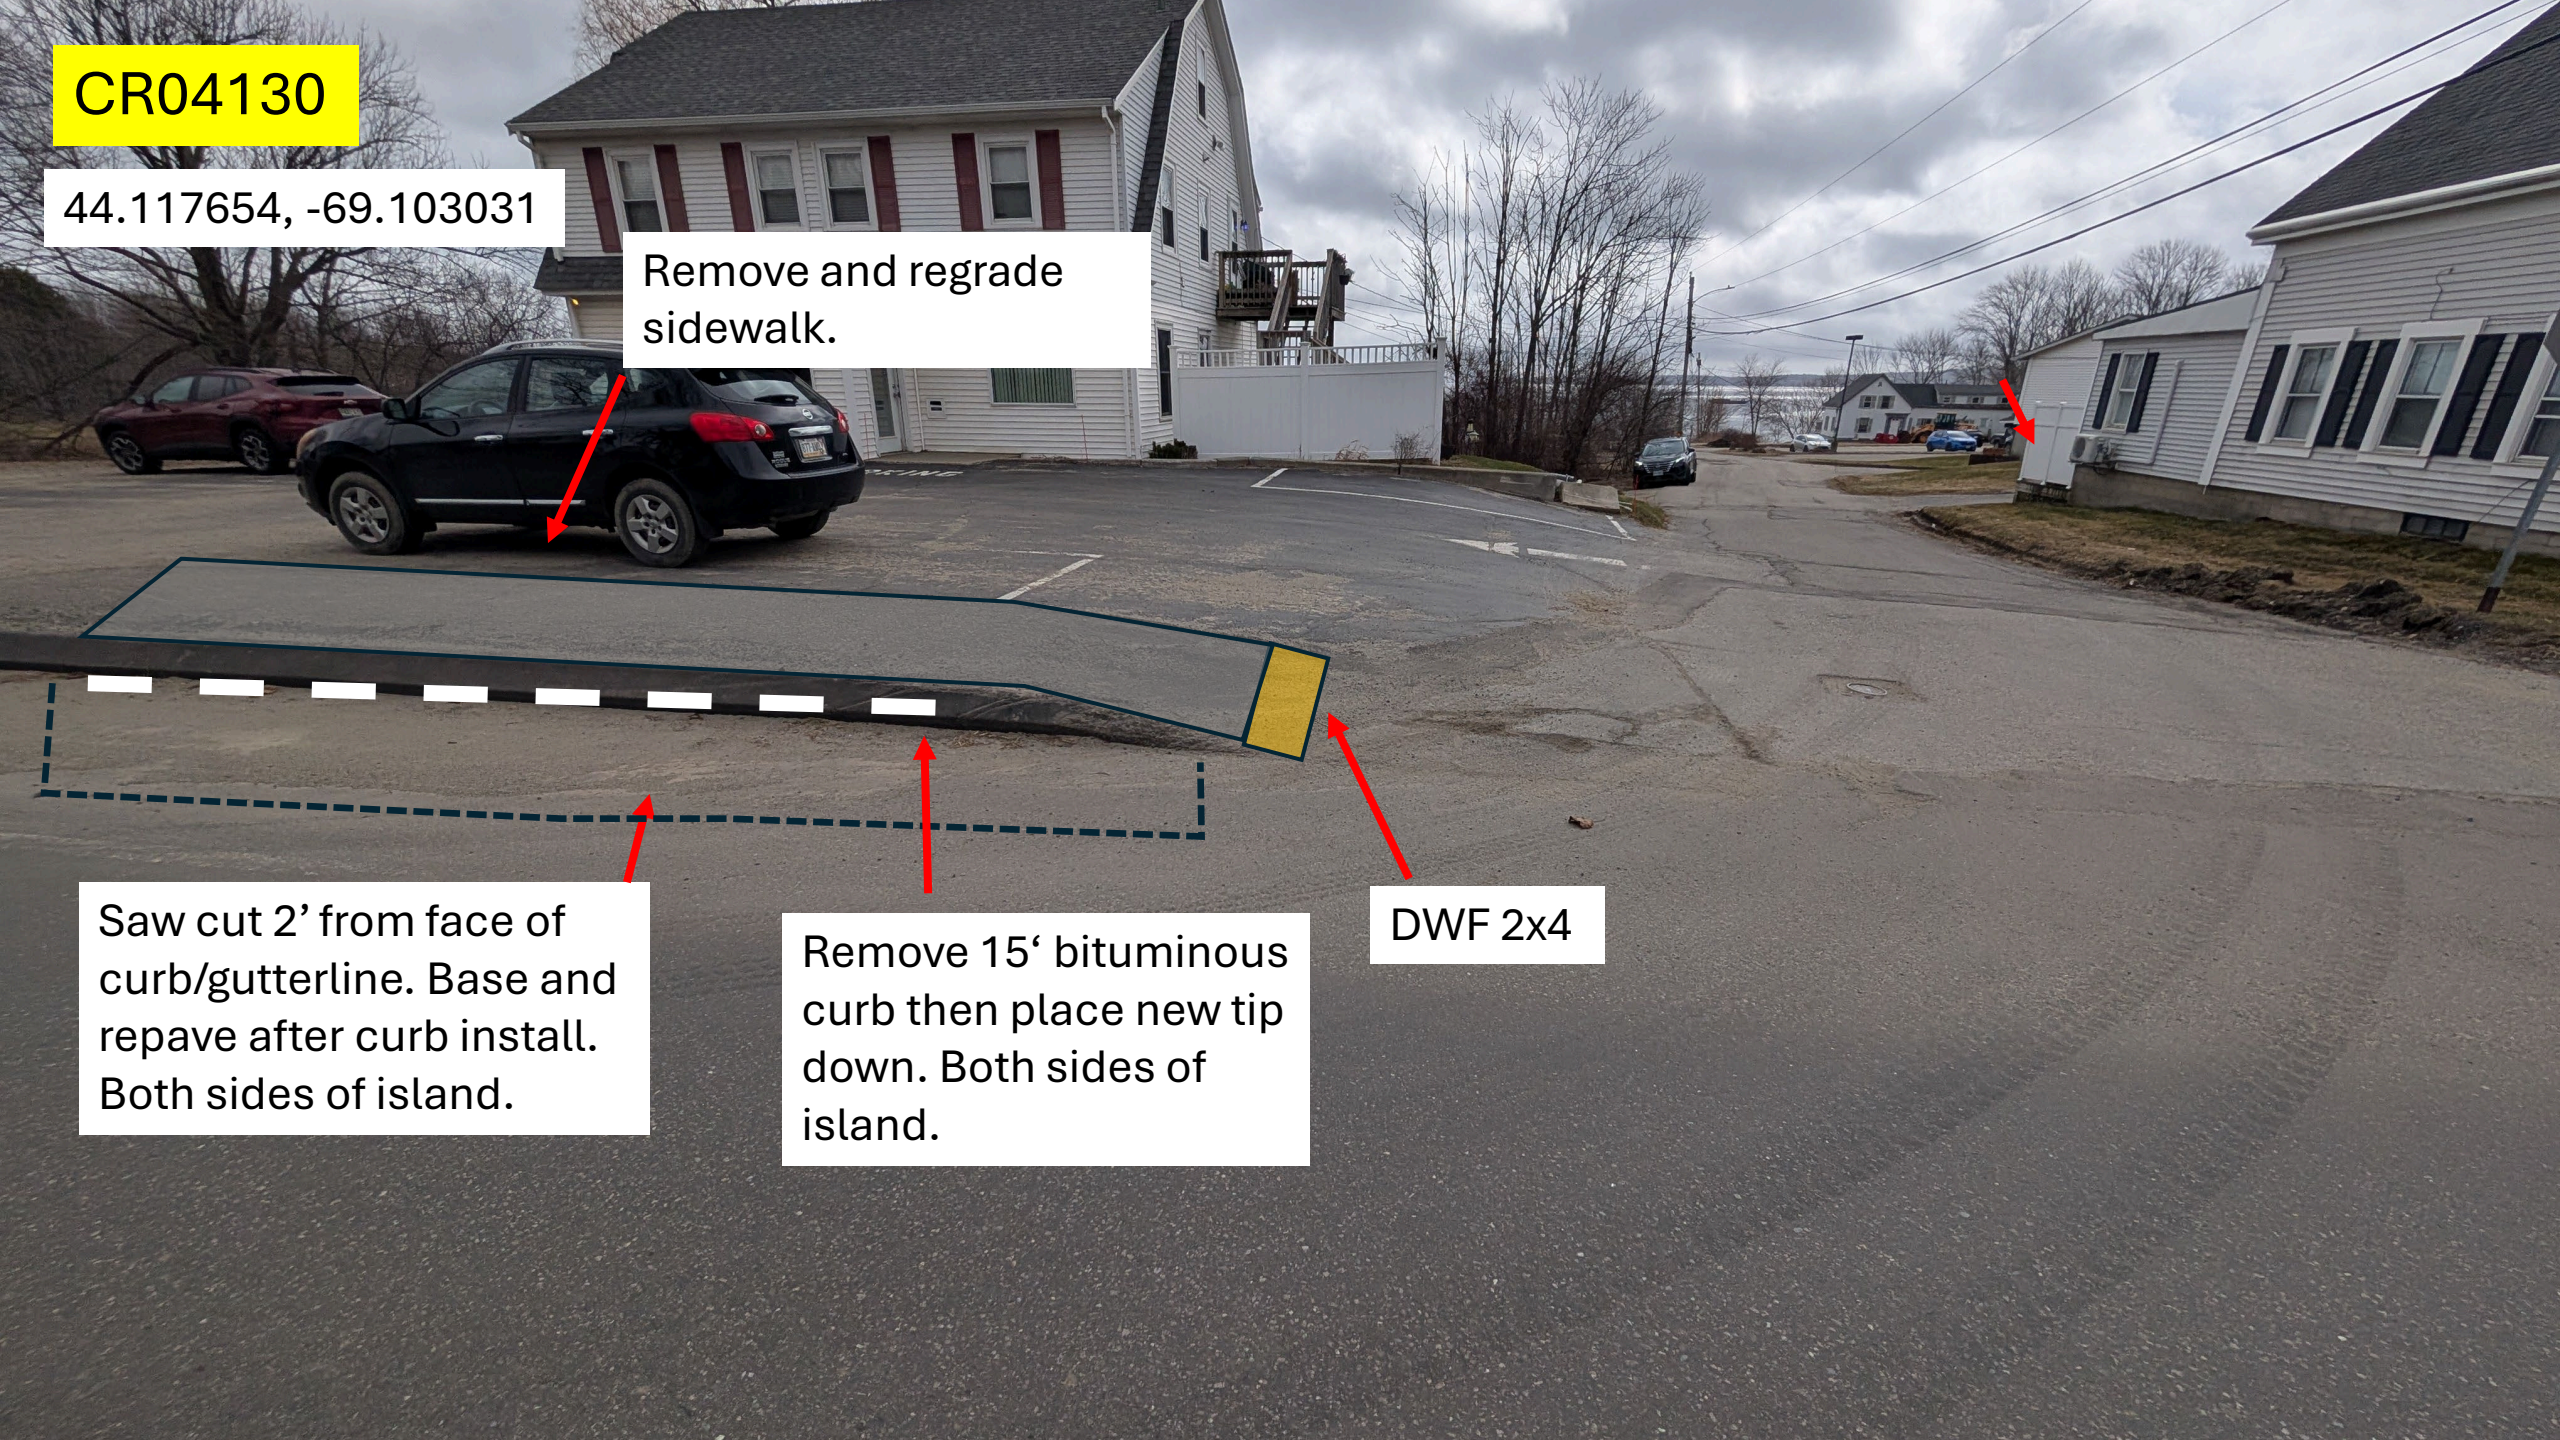

CR04131


44.117774, -69.103182

4'x4'
Turning
Area

Loam
and
seed.

Install A
tip up
and Tip
down Bit.
Curb

DWF 2x4

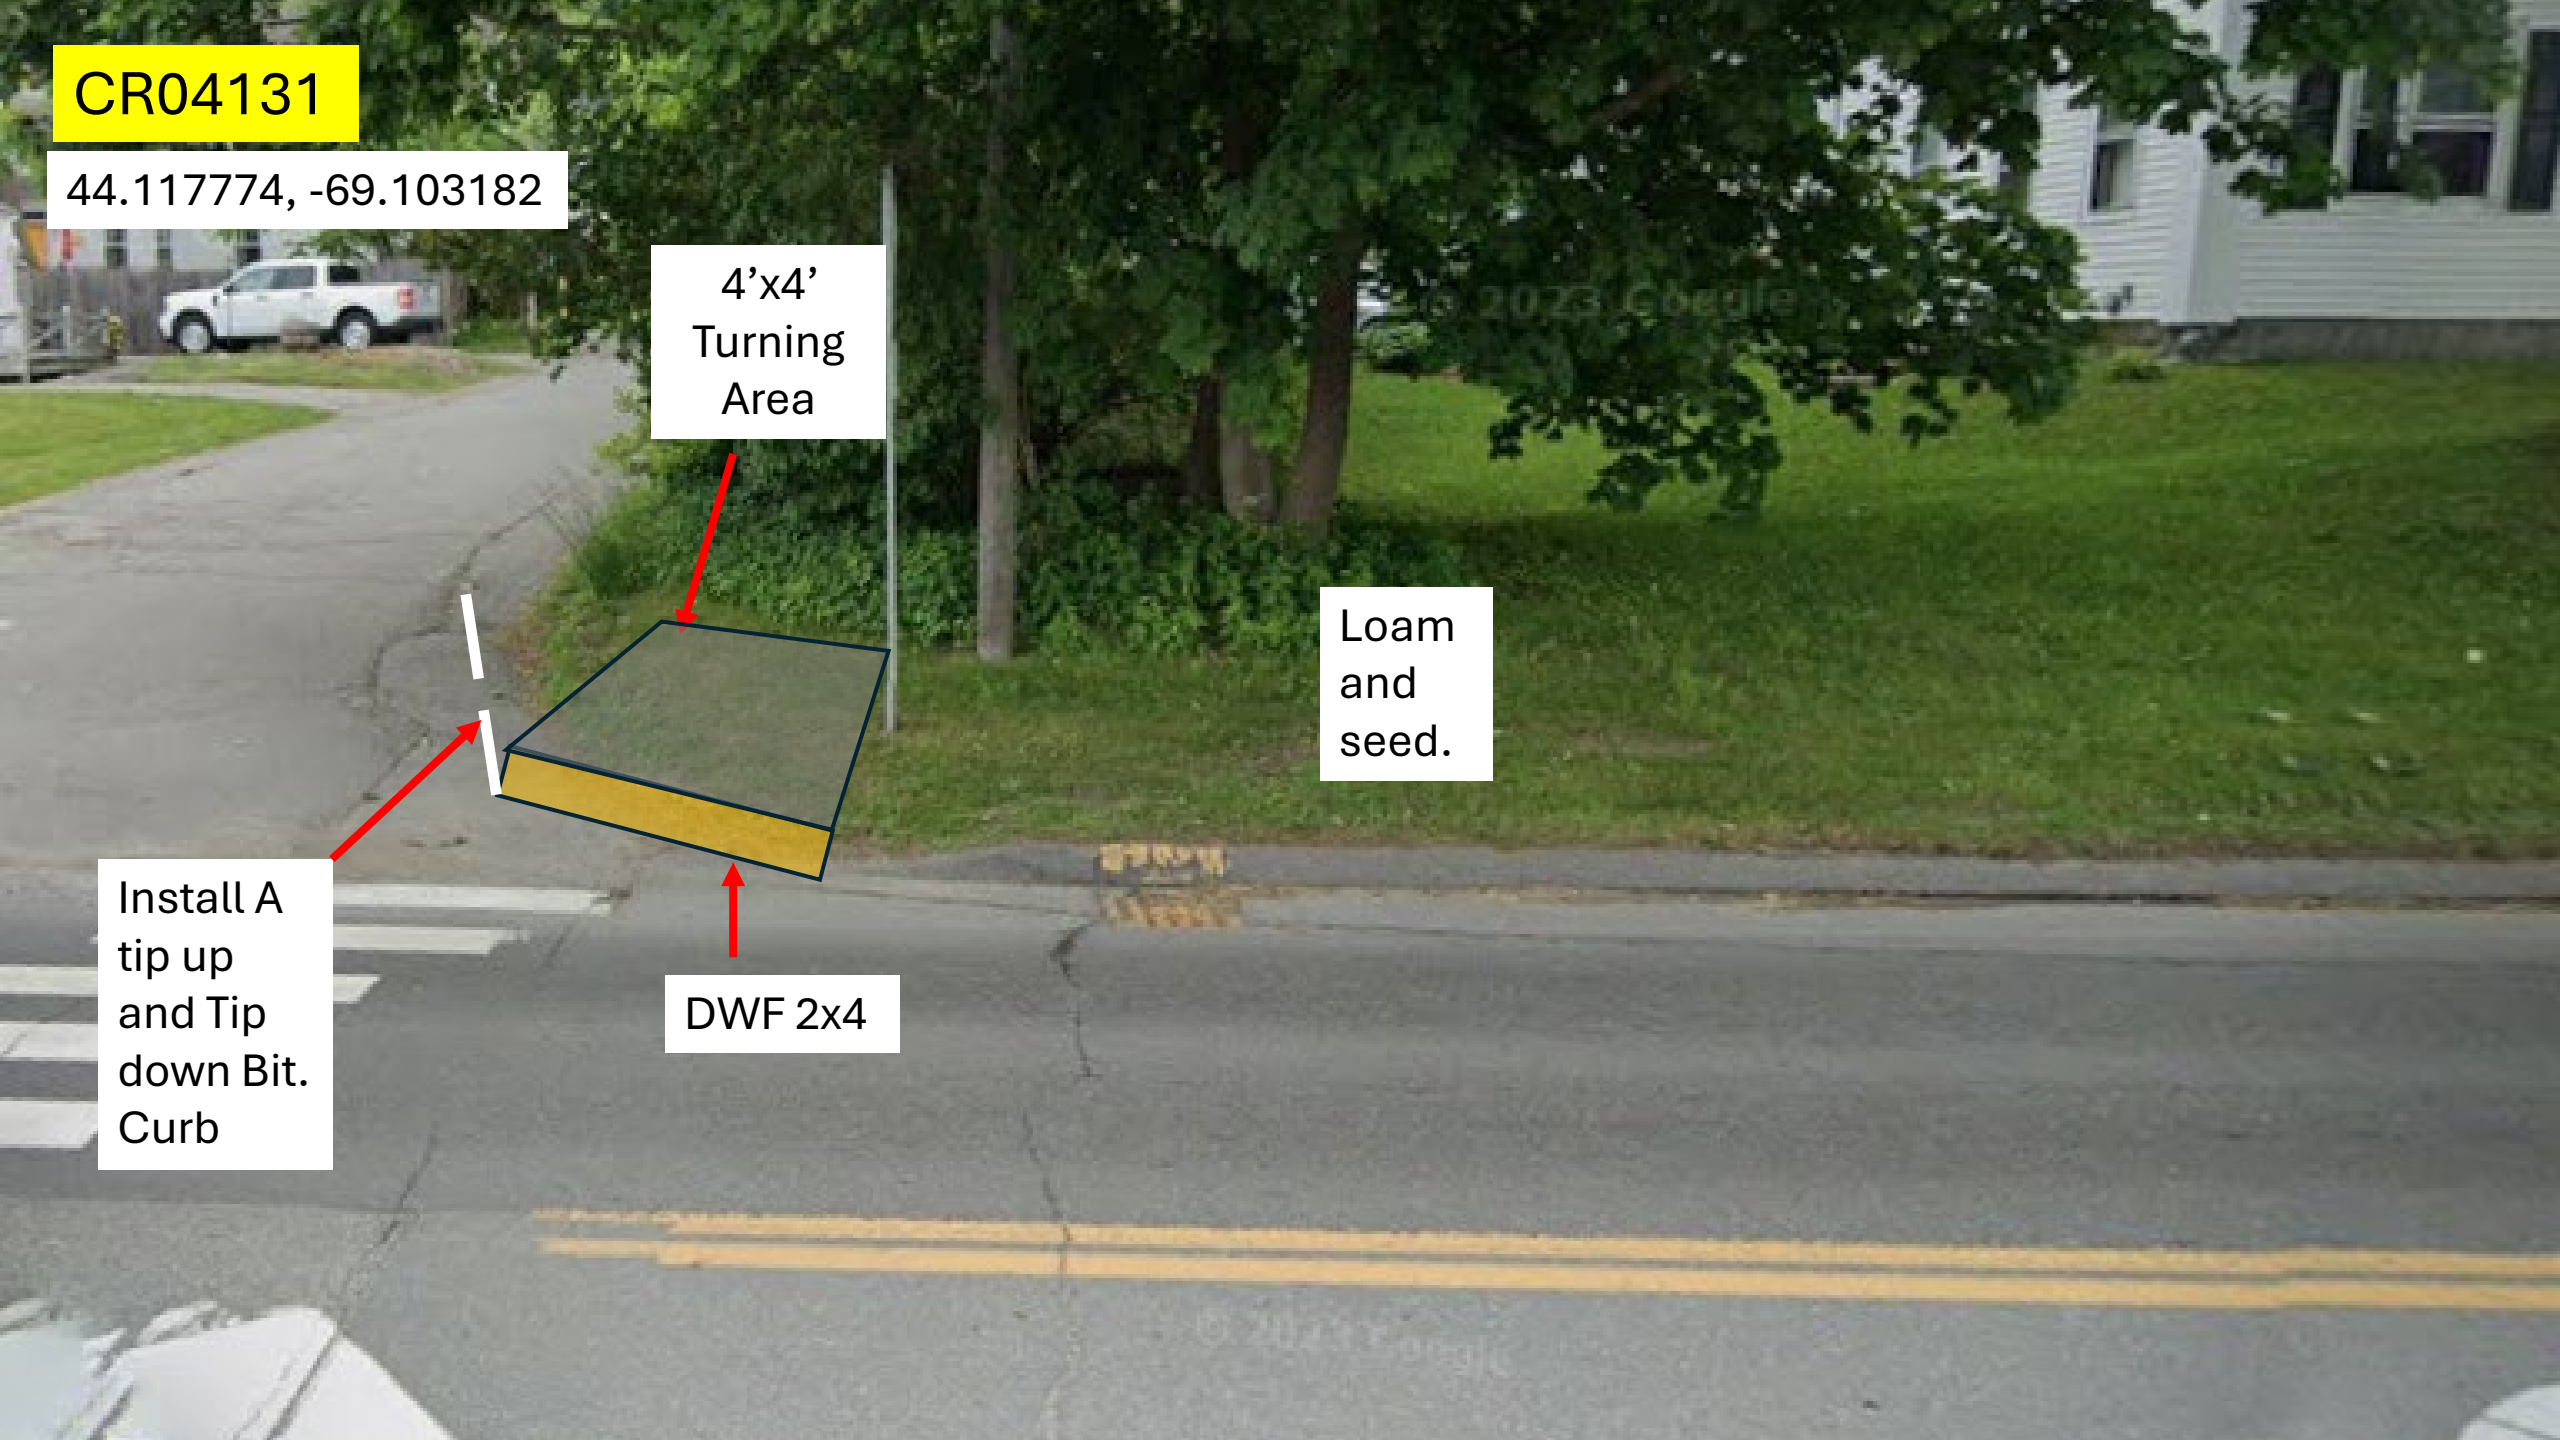



RAMP REPORT REGION 2 ADA 2026

Harbor Plaza & Crosswalk,
Rockland

CR16759

44.124403, -69.098925

The design may need to be revised to ensure the pedestrian push button is located on a level landing that meets ADA/PROWAG accessibility requirements. The landing should provide a stable, and firm, surface with appropriate cross slope and running slope to allow safe and independent use by wheelchair users.

Remove 16' bituminous curb then place new tip down.


Remove and regrade sidewalk.

4'x4'
Turning
Area

Loam
&
Seed

Saw cut 2' from face of
curb/gutterline. Base and
repave after curb install.

DWF 2x6

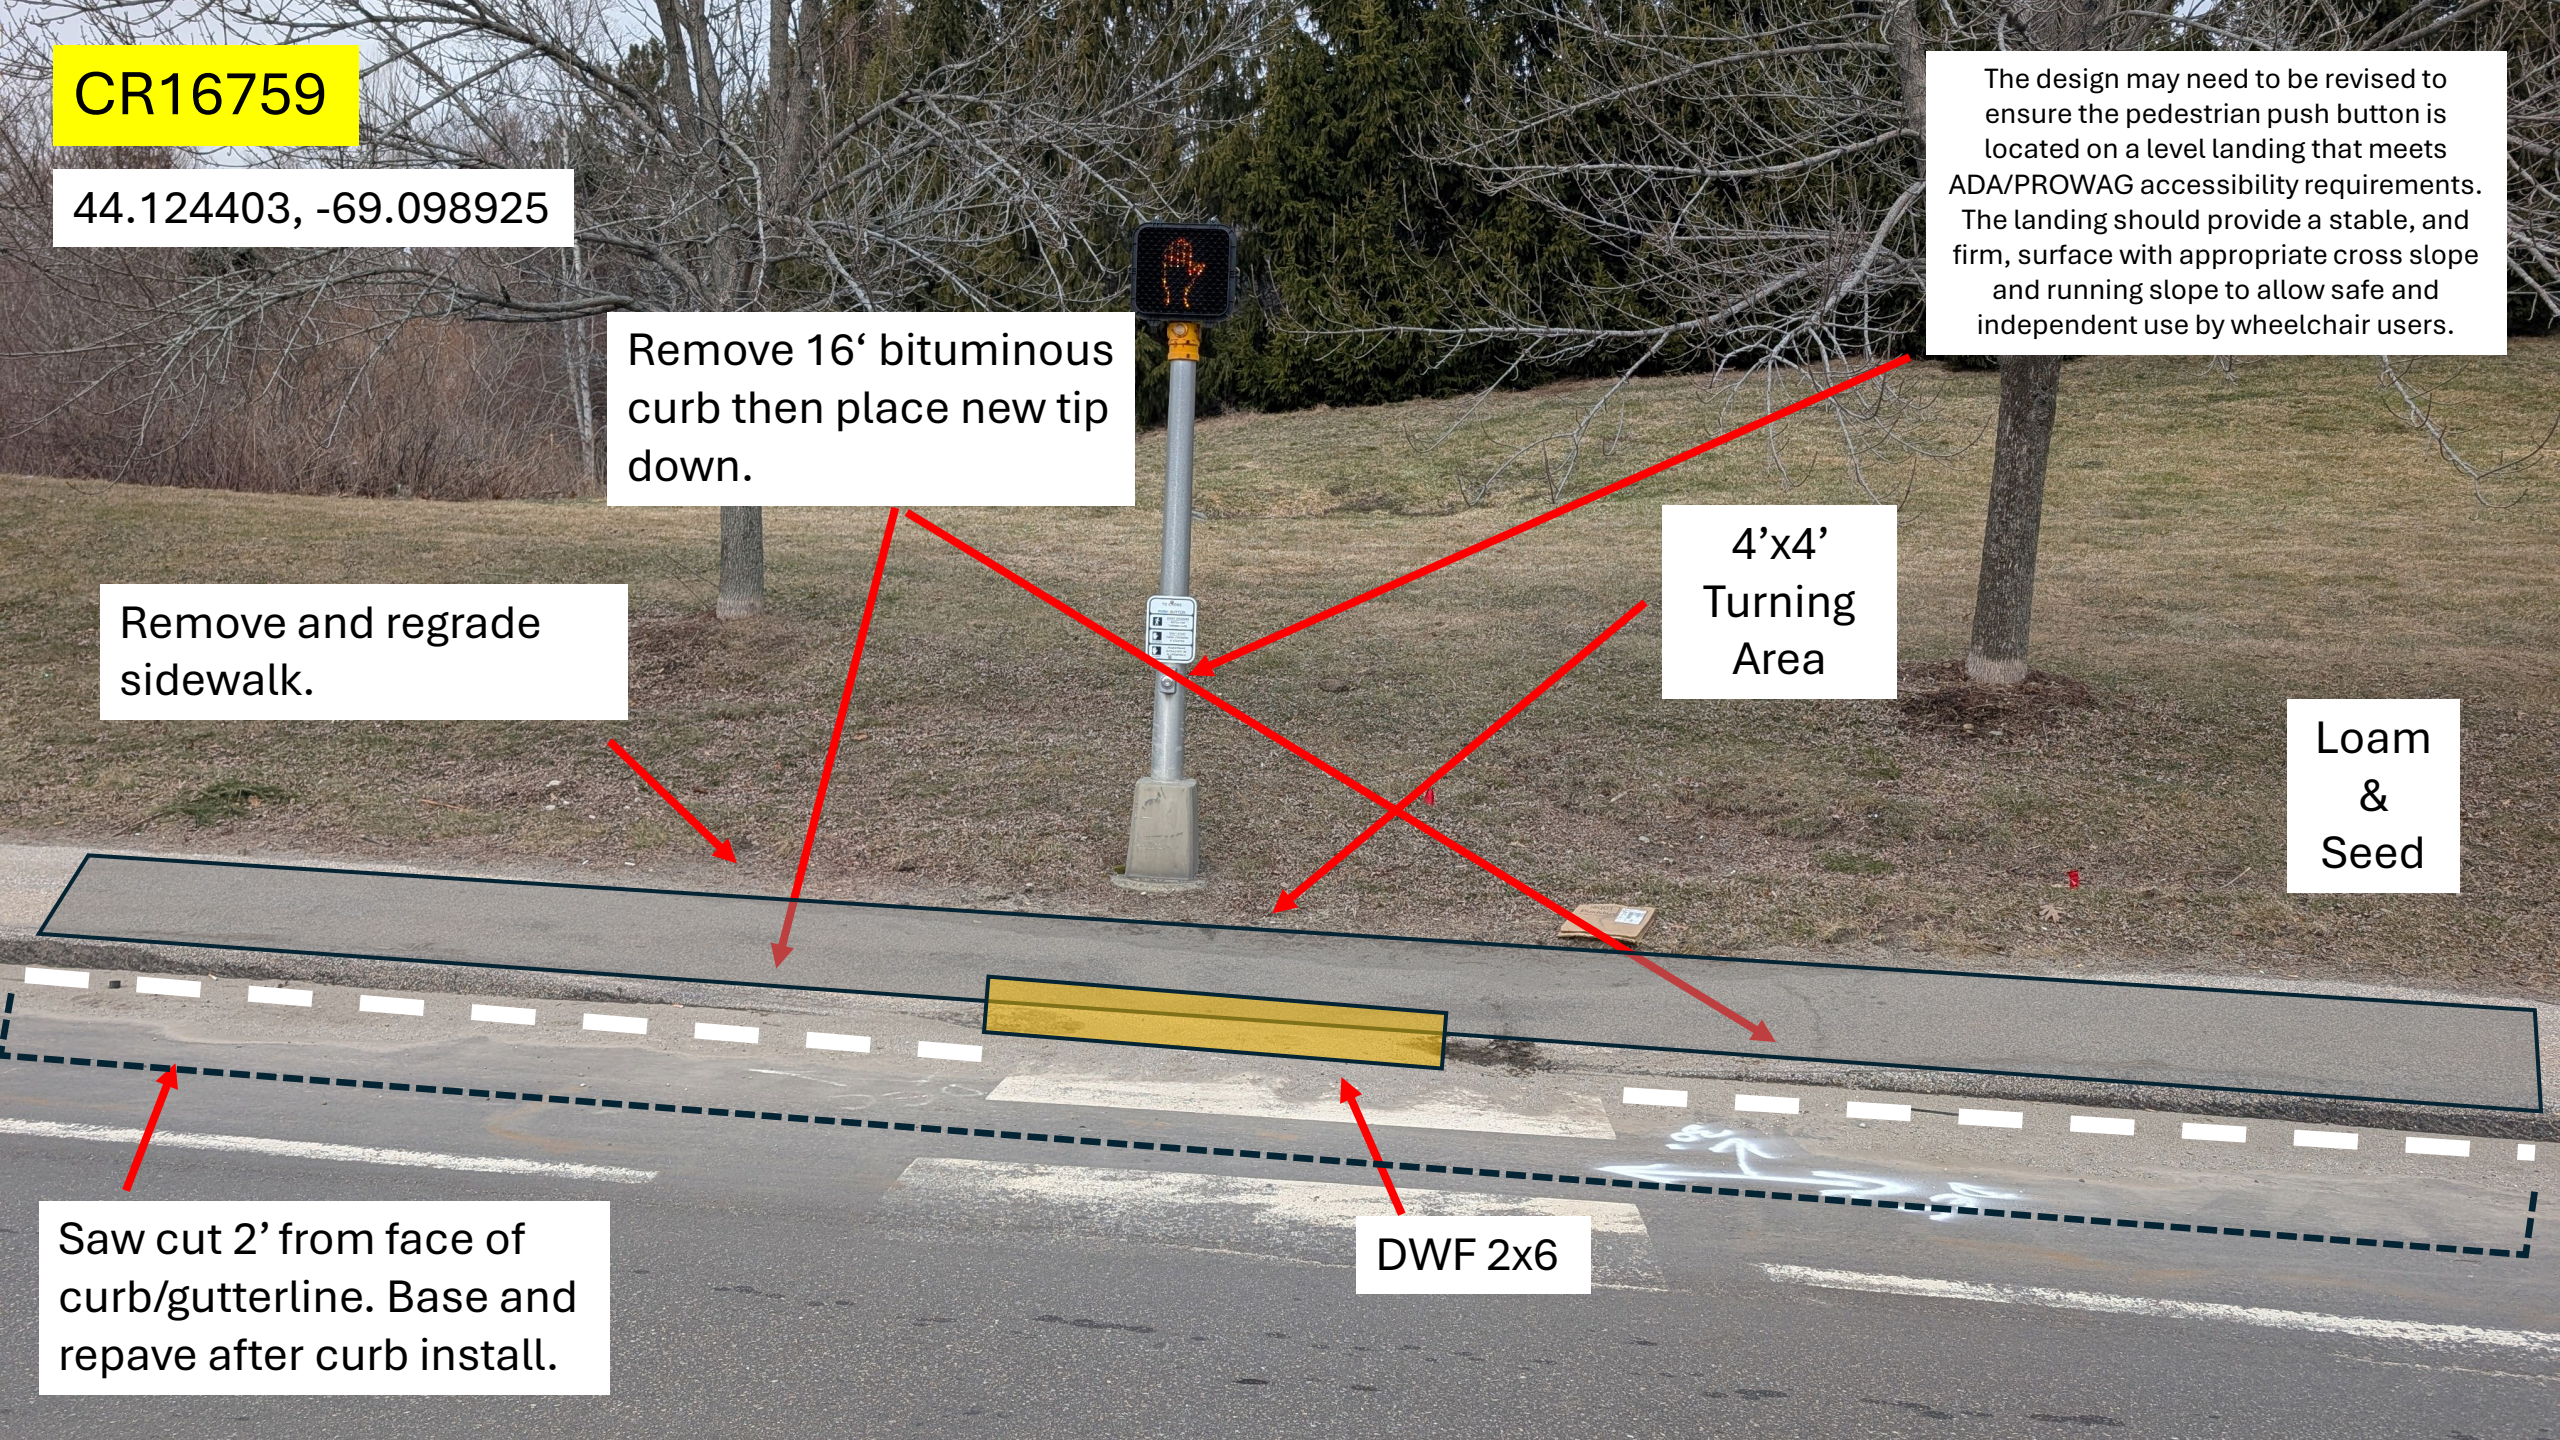

CR13664

44.124347, -69.098714

Remove and regrade
sidewalk.

4'x4'
Turning
Area


The design may need to be revised to ensure the pedestrian push button is located on a level landing that meets ADA/PROWAG accessibility requirements. The landing should provide a stable, and firm, surface with appropriate cross slope and running slope to allow safe and independent use by wheelchair users.

Loam
and
seed.

Construct sidewalk.

Saw cut 2' from face of
curb/gutterline. Base and
repave after curb install.

DWF 2x8

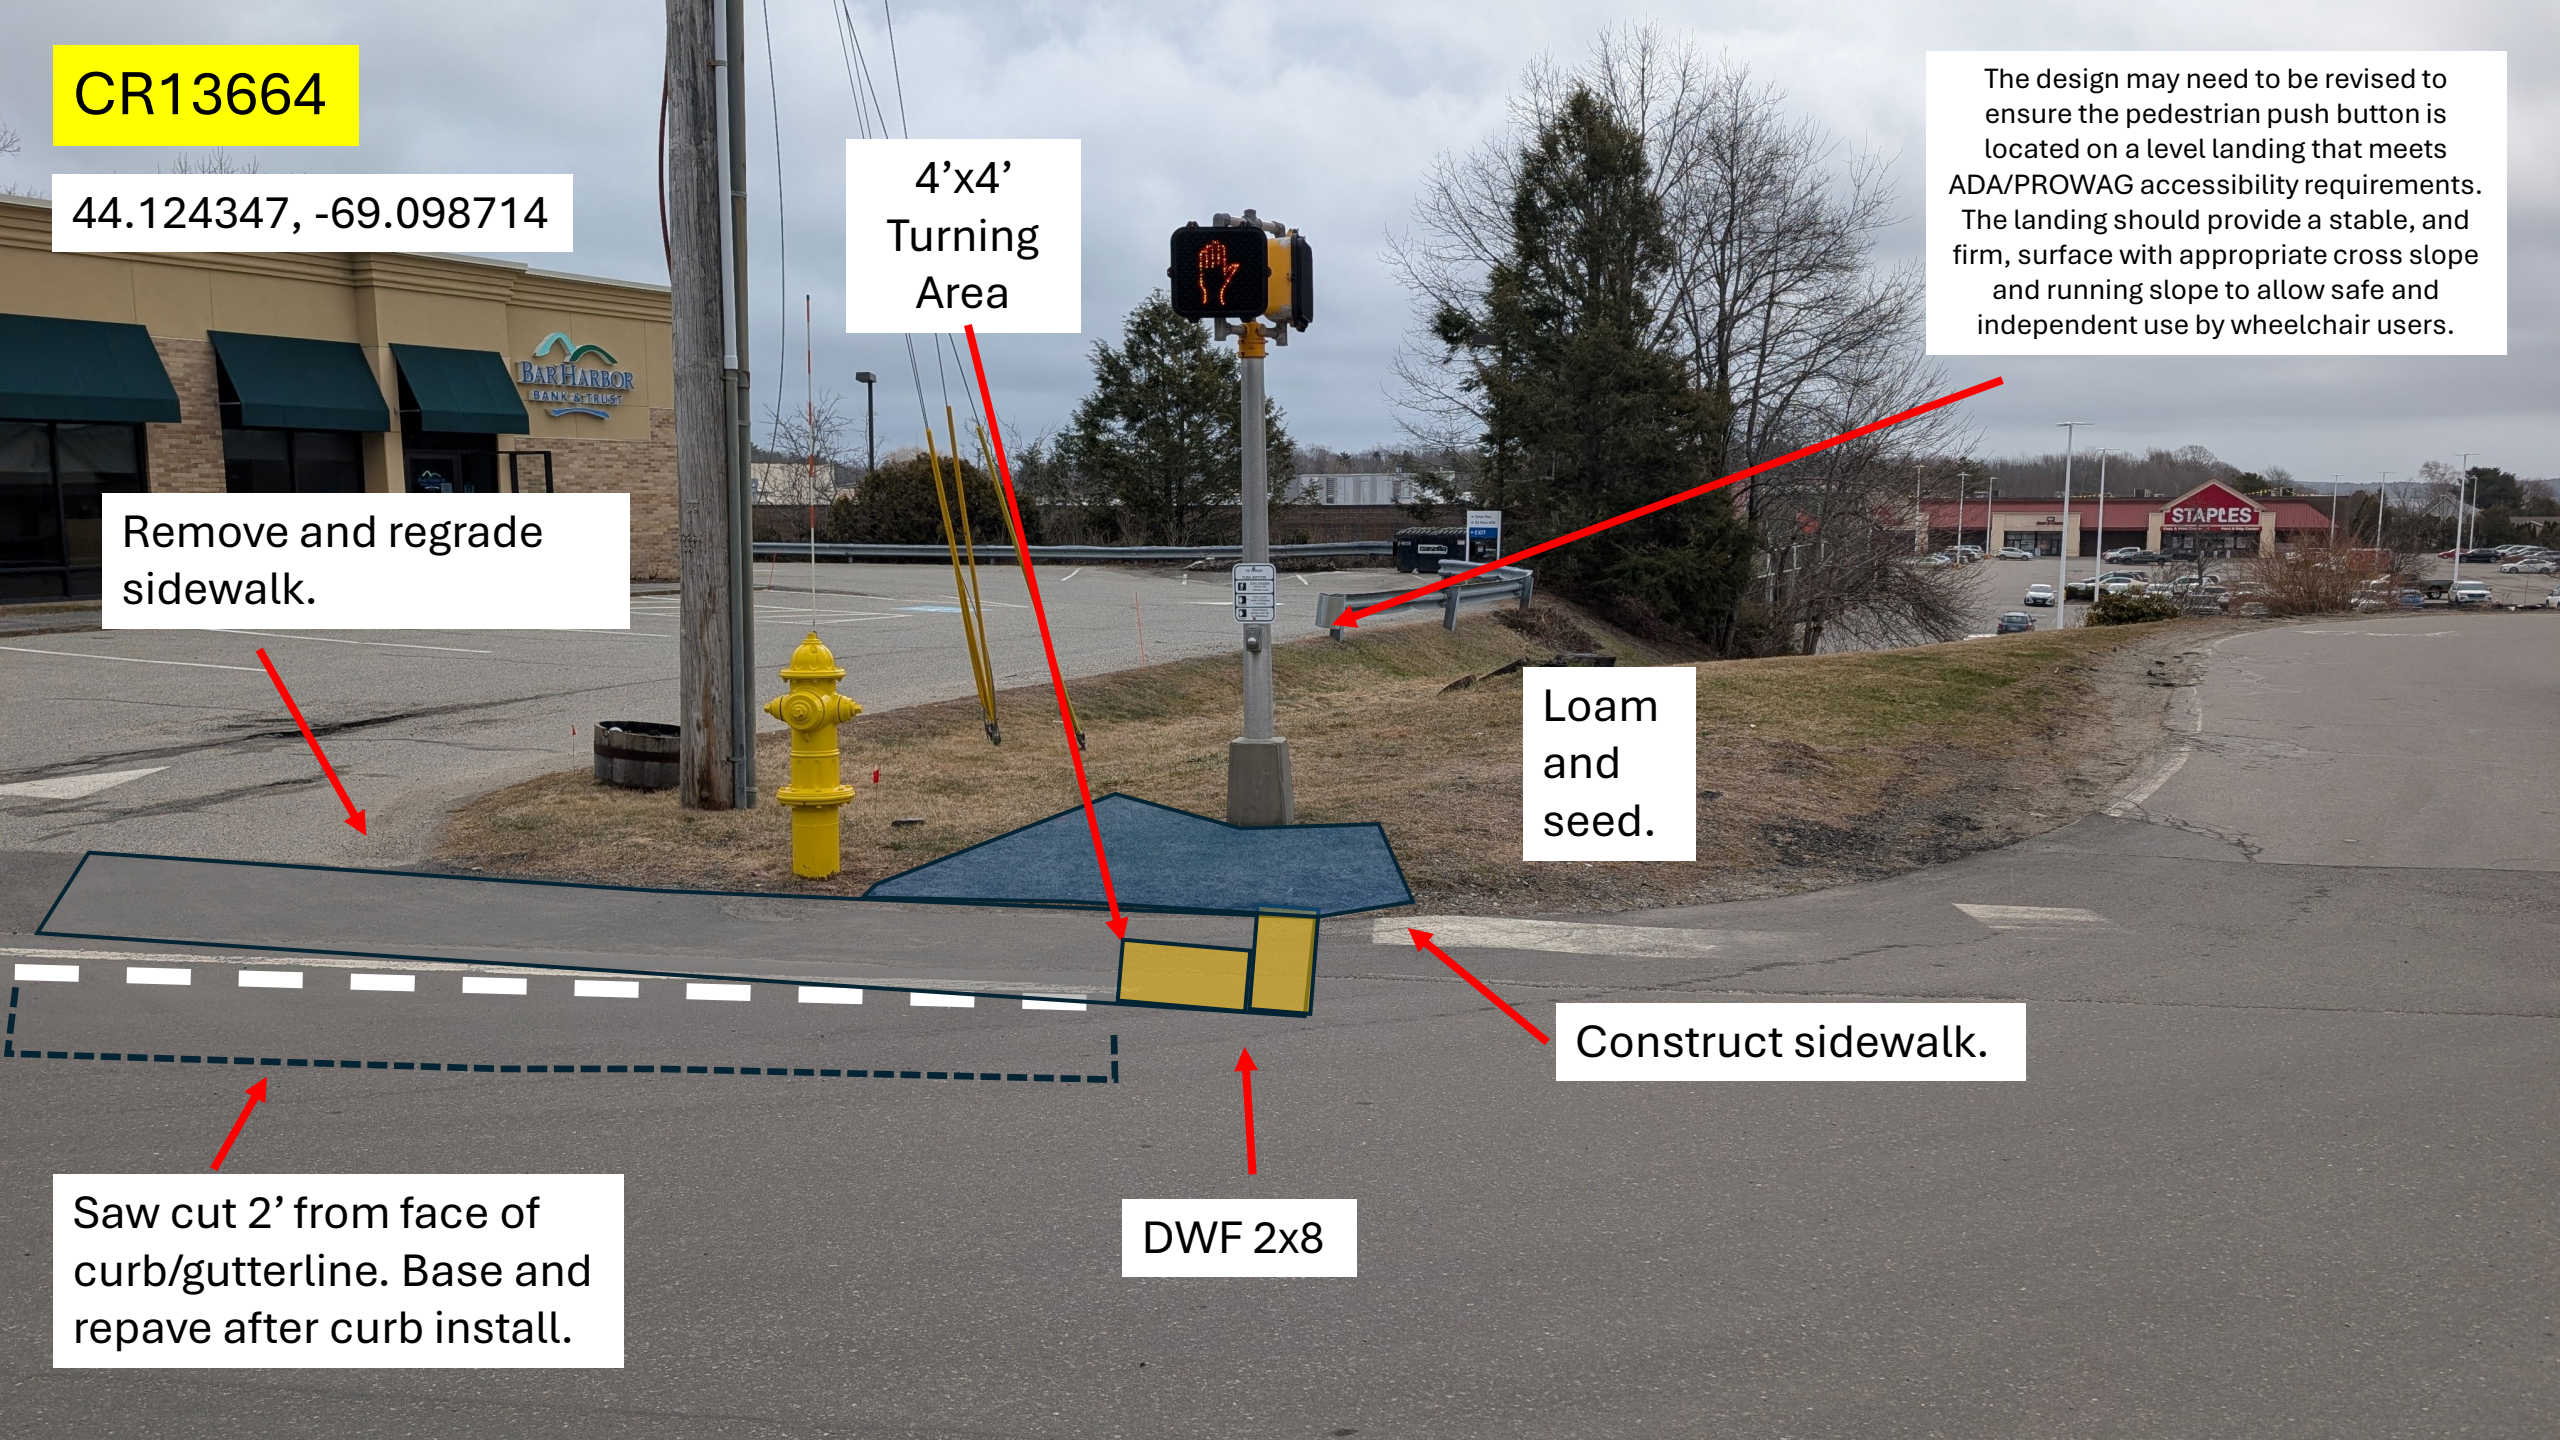

CR16758

44.123984, -69.098799

The design may need to be revised to ensure the pedestrian push button is located on a level landing that meets ADA/PROWAG accessibility requirements. The landing should provide a stable, and firm, surface with appropriate cross slope and running slope to allow safe and independent use by wheelchair users.

Remove and regrade sidewalk.


Add new 10' bituminous curb then place new tip down.

4'x4' Turning Area

Loam and seed.

DWF 2x5 *to be within 5' of side road entrance

Saw cut 2' from face of curb/gutterline. Base and repave after curb install.

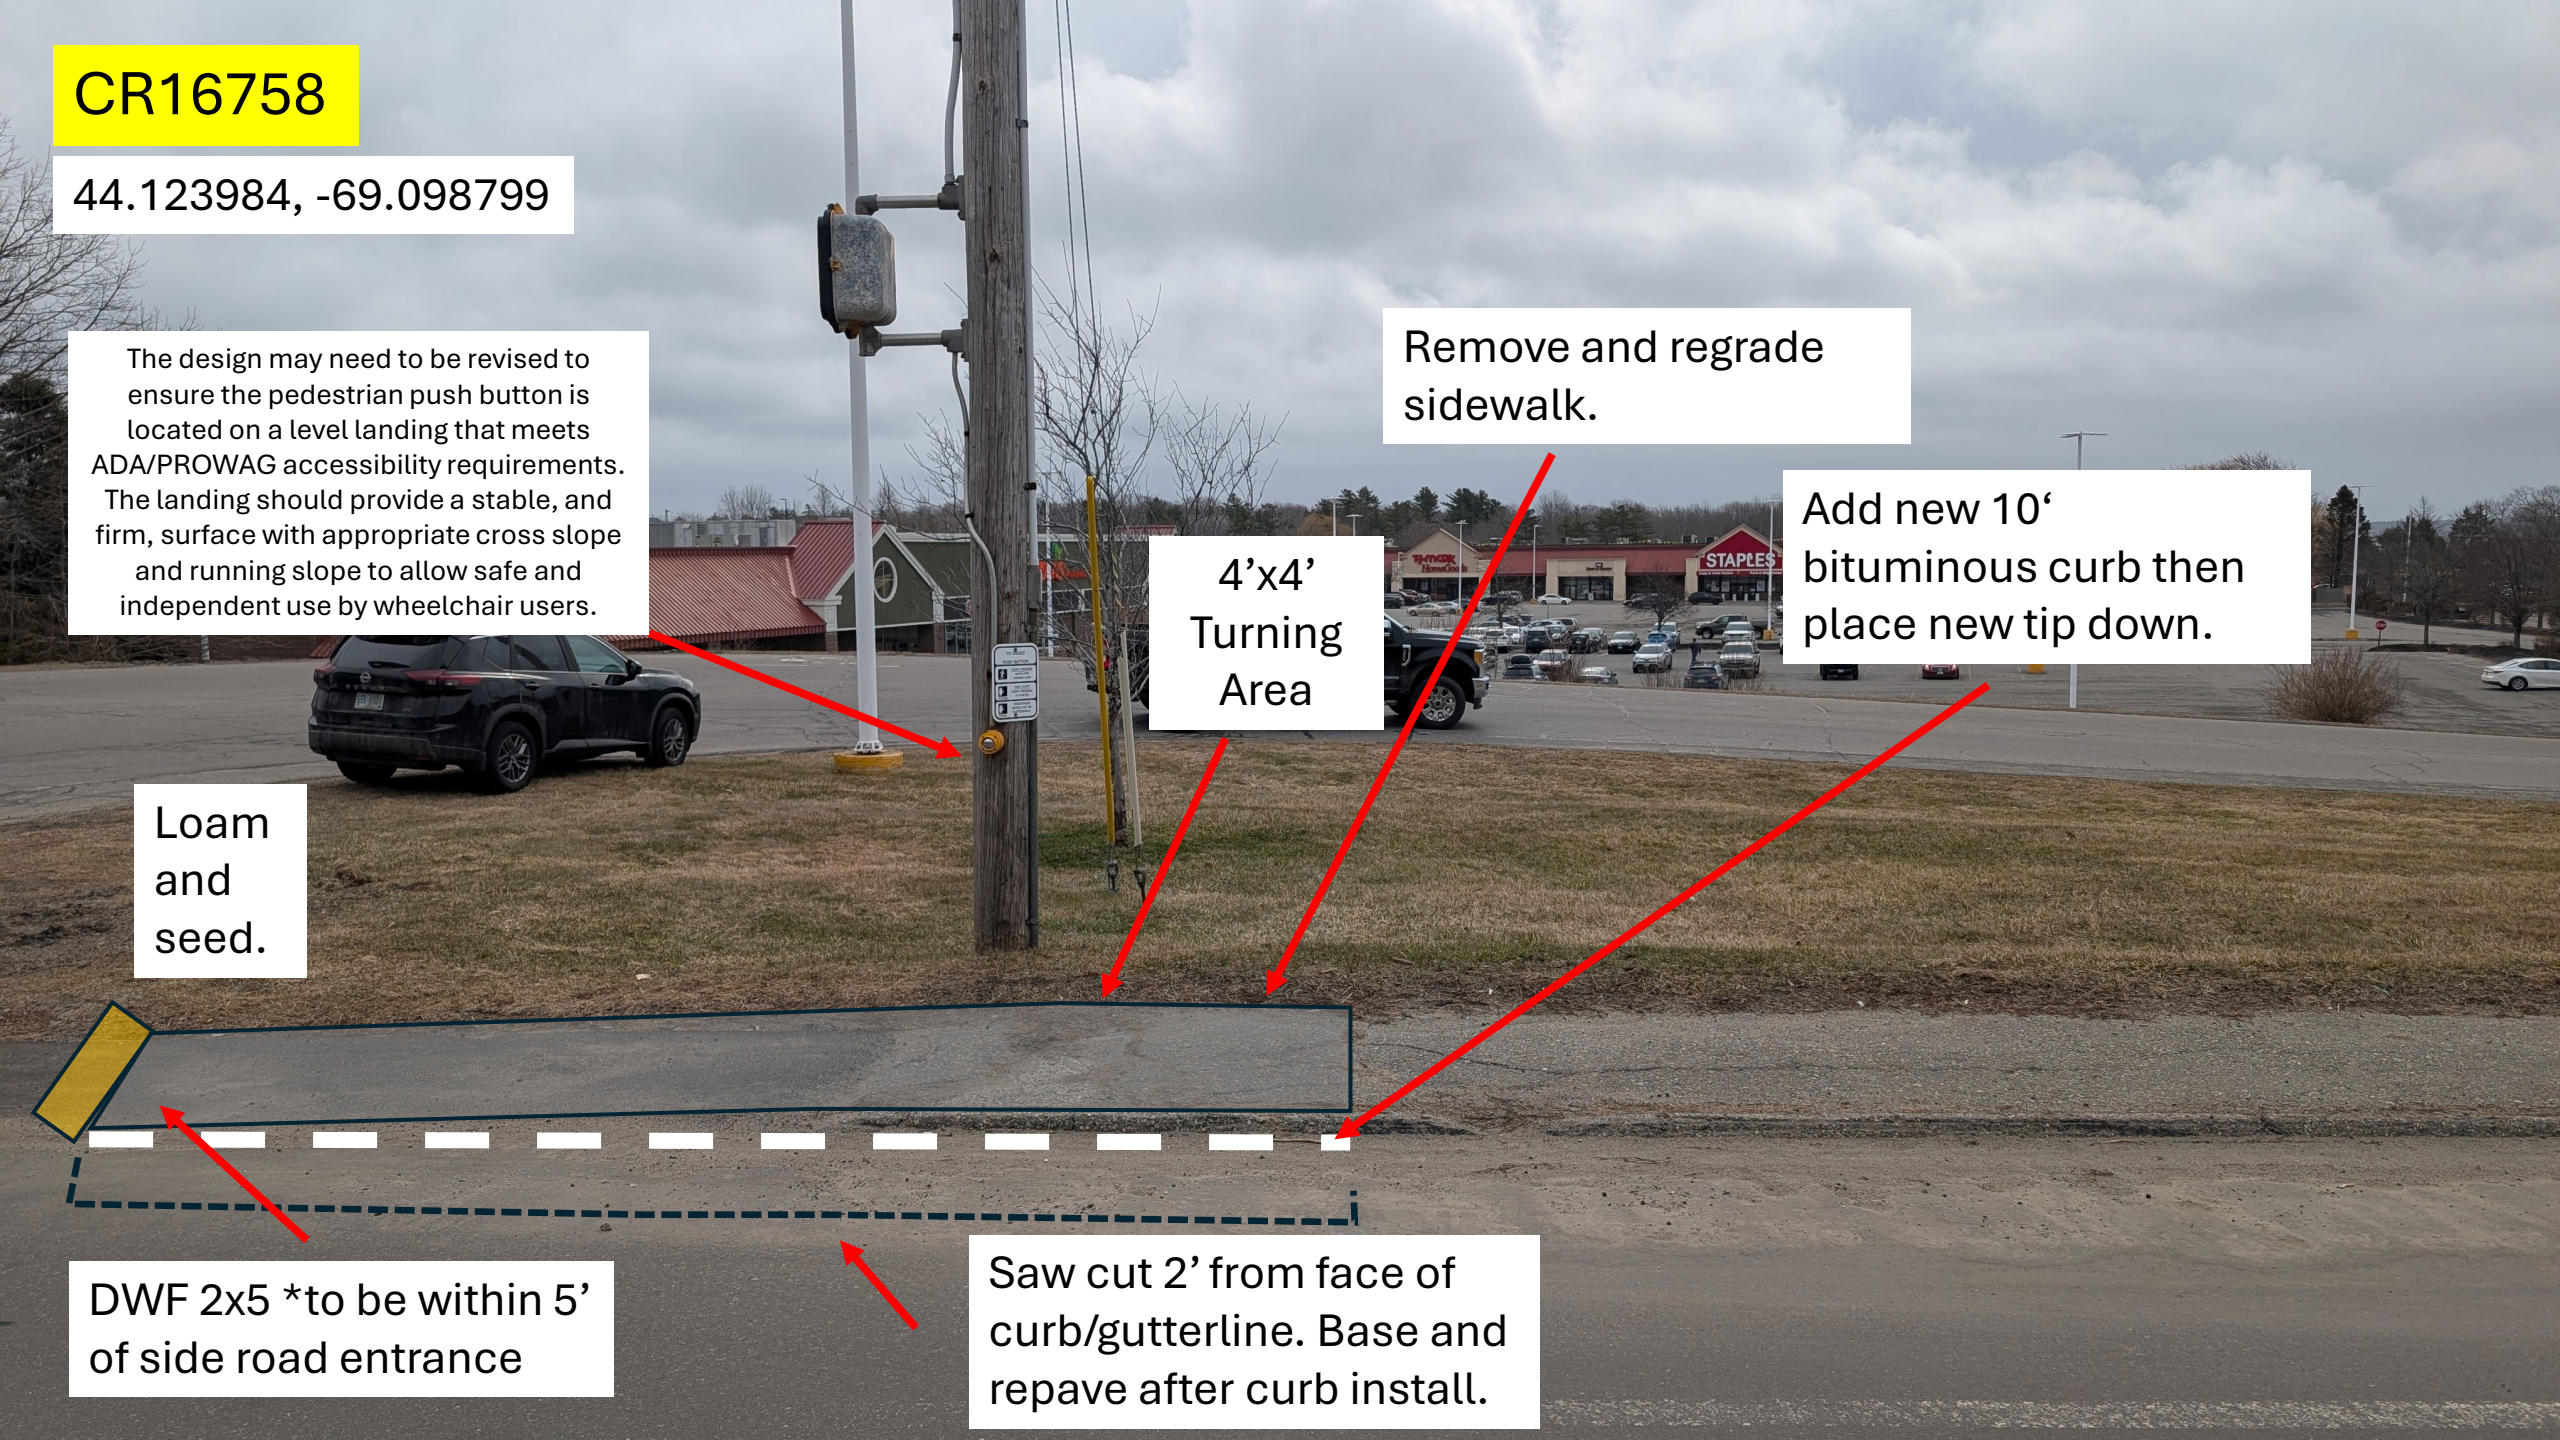



RAMP REPORT REGION 2 ADA 2026

Home Depot and Harbor Freight,
Rockland

CR16936

44.125867, -69.098039

The design may need to be revised to ensure the pedestrian push button is located on a level landing that meets ADA/PROWAG accessibility requirements. The landing should provide a stable, and firm, surface with appropriate cross slope and running slope to allow safe and independent use by wheelchair users.

Loam
&
Seed

Remove pavement
and Loam and
Seed


4'x4'
Turning
Area

DWF 2x10

Remove and regrade
sidewalk.

Reset 34' Granite curb.

Saw cut 2' from face of
curb/gutterline. Base and
repave after curb install.

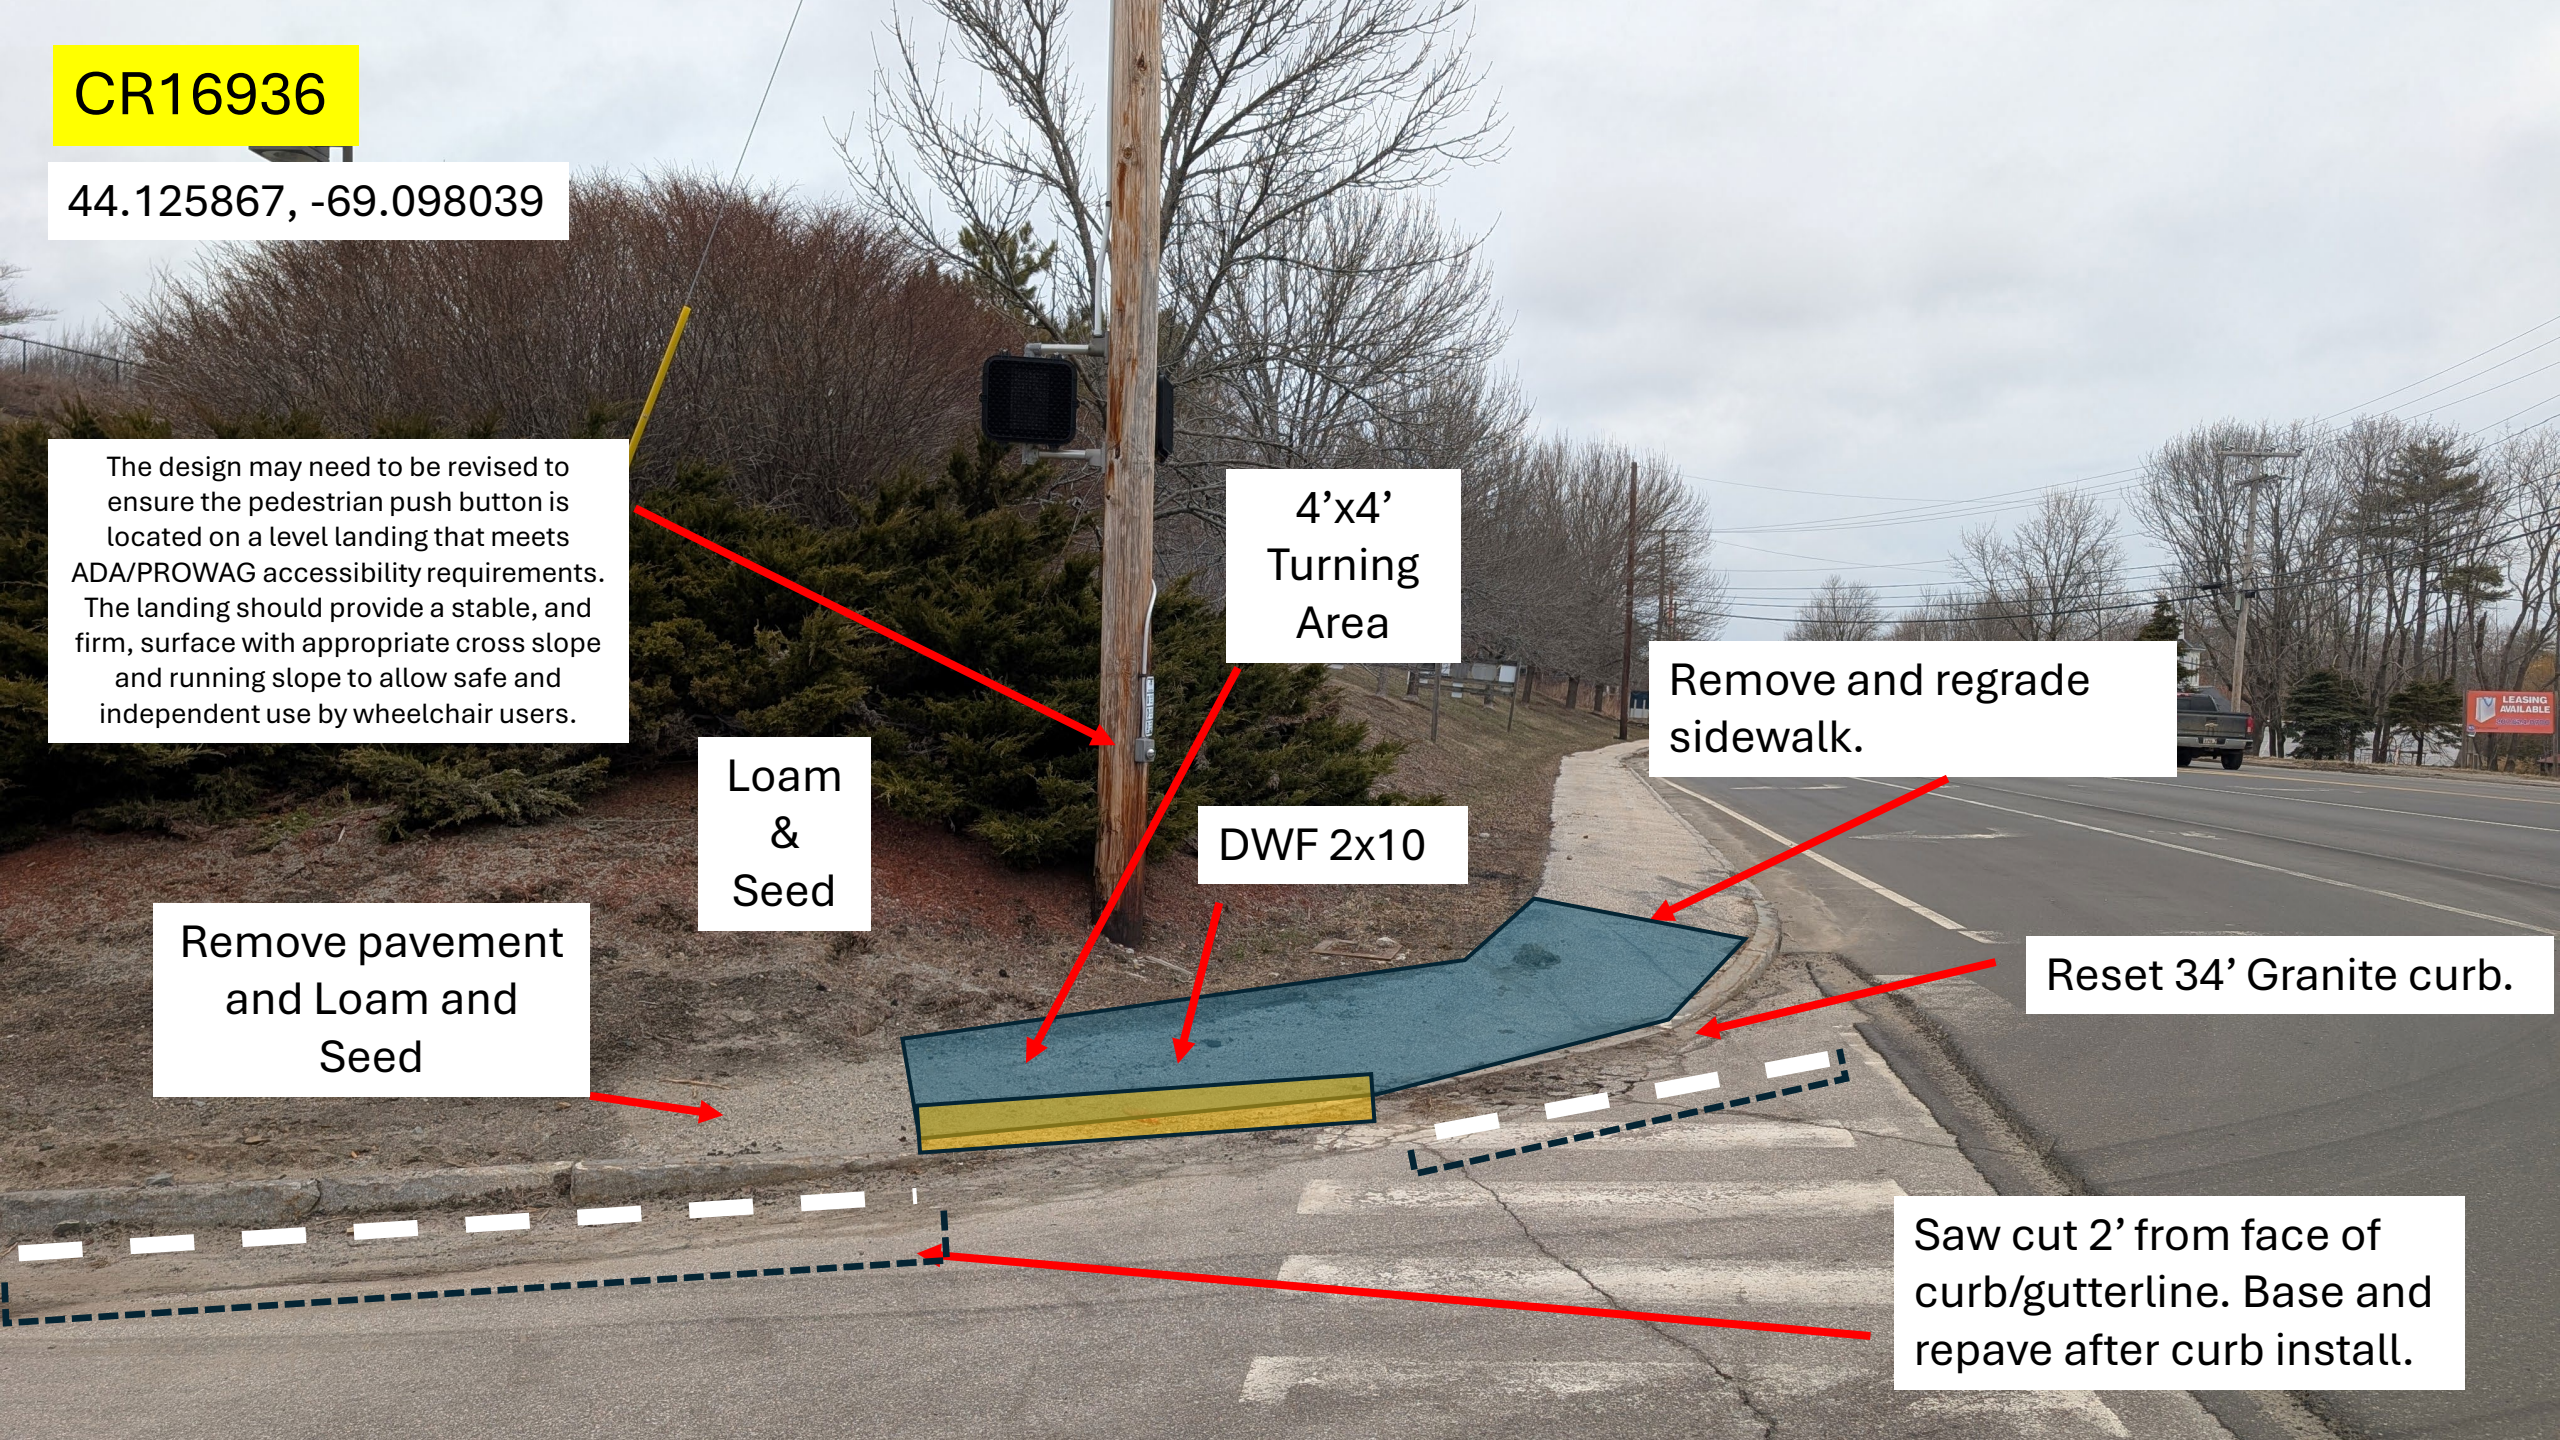

CR16773

44.125617, -69.098206

Remove and regrade
sidewalk.

4'x4'
Turning
Area


DWF 2x10

Loam
and
seed.

Remove pavement, add
4" loam.


Reset 21' granite curb.

Saw cut 2' from face of
curb/gutterline. Base and
repave after curb install.

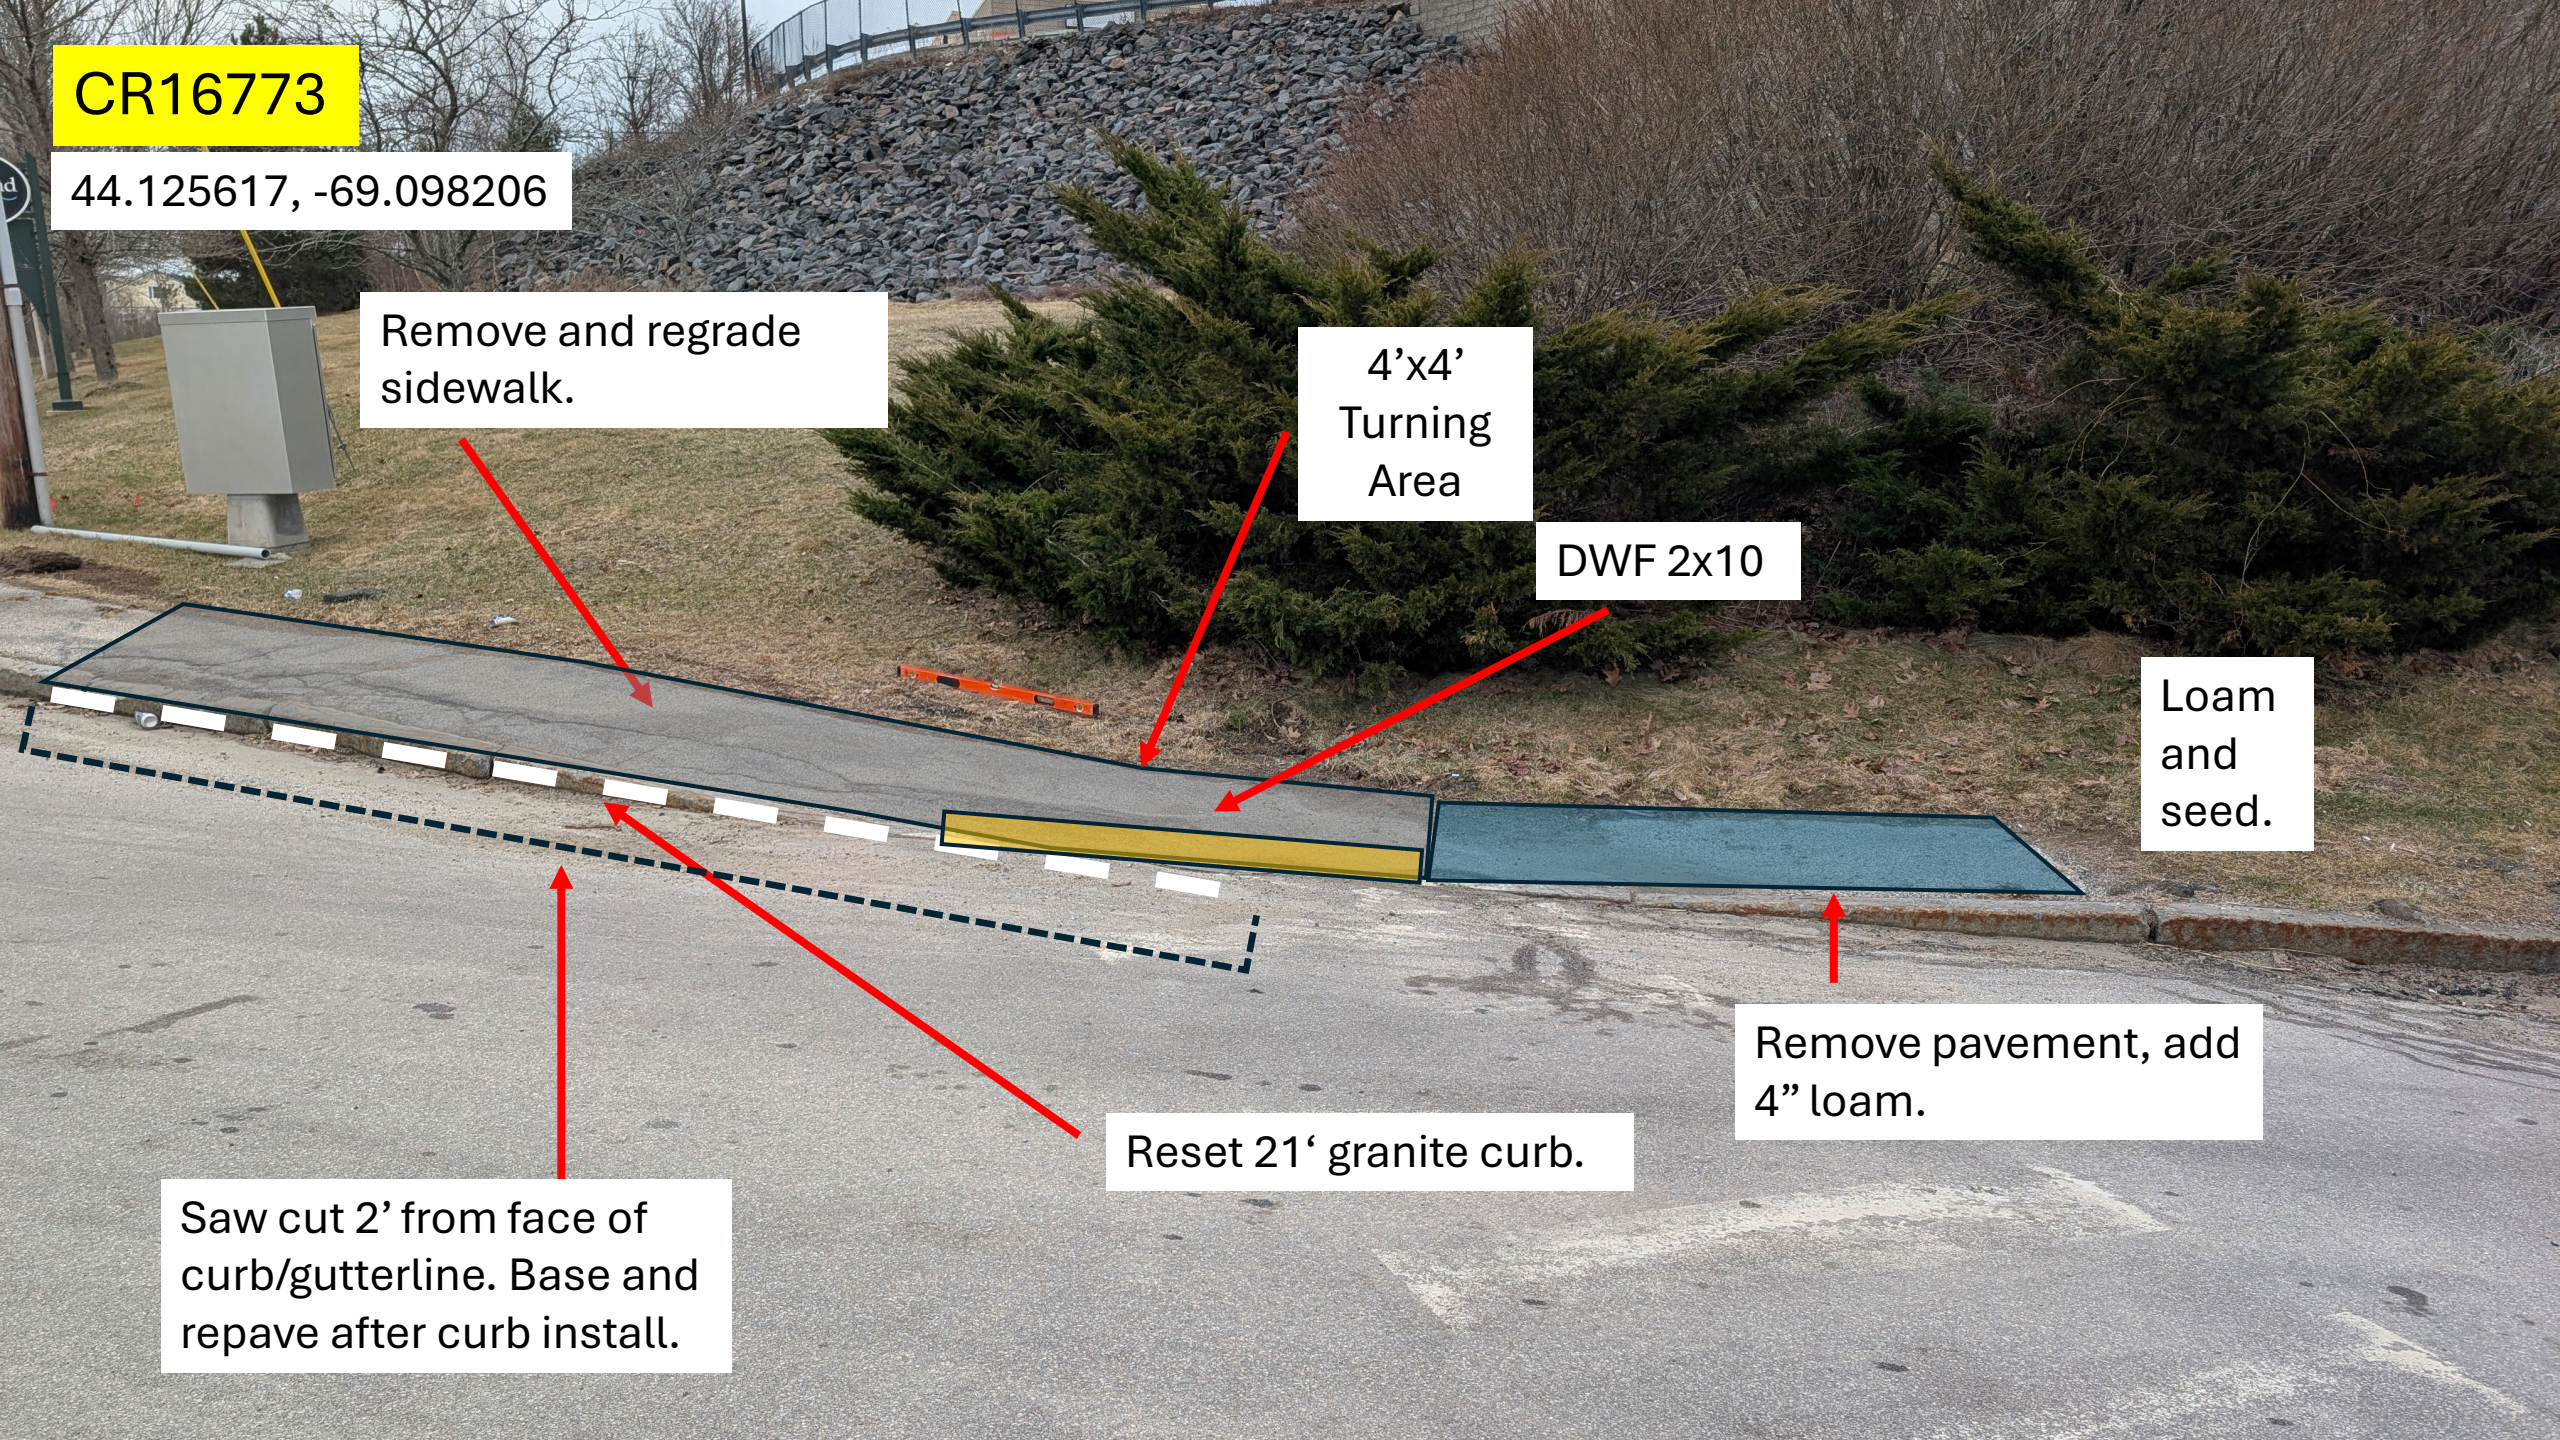

NEEDS # - HOME DEPOT ENTRANCE

44.125683, -69.098144

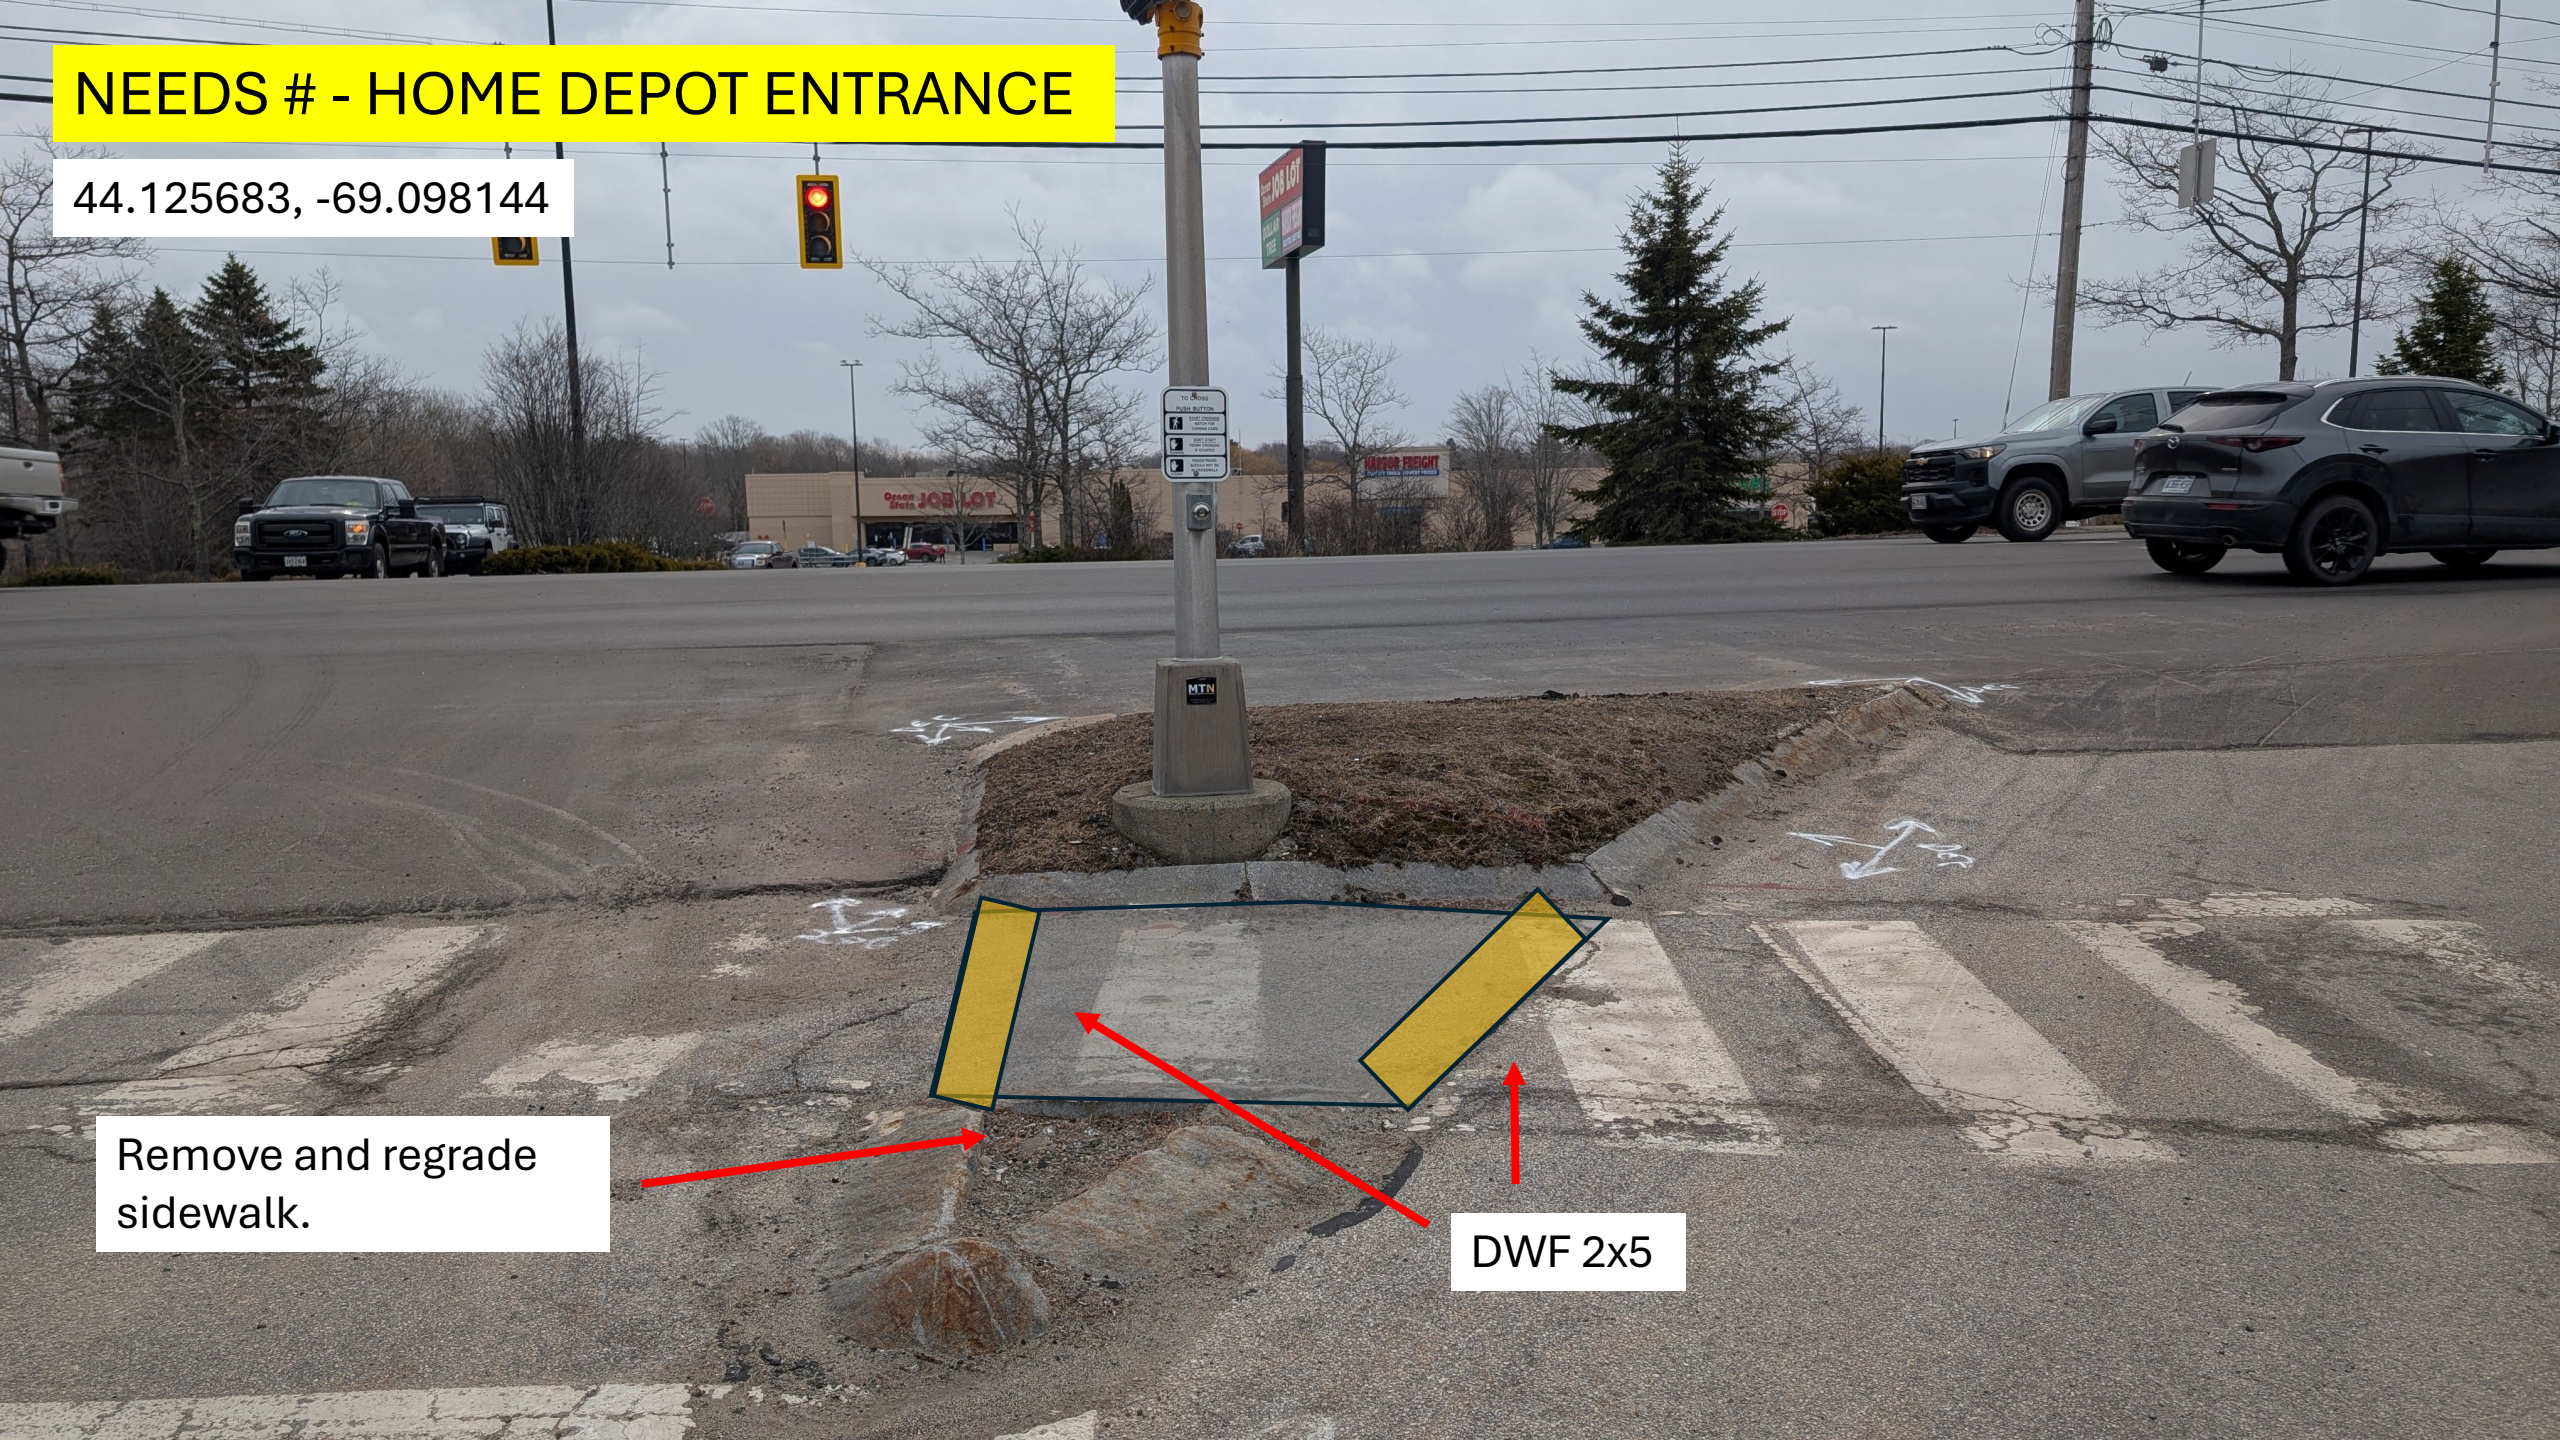

Remove and regrade sidewalk.

DWF 2x5

CR16775

44.125772, -69.097758

Remove and regrade
sidewalk.


Remove 8' bituminous
curb then place new tip
down.

Loam
and
seed.

Saw cut 2' from face of
curb/gutterline. Base and
repave after curb install.


DWF 2x4

The design may need to be revised to ensure the pedestrian push button is located on a level landing that meets ADA/PROWAG accessibility requirements. The landing should provide a stable, and firm, surface with appropriate cross slope and running slope to allow safe and independent use by wheelchair users.

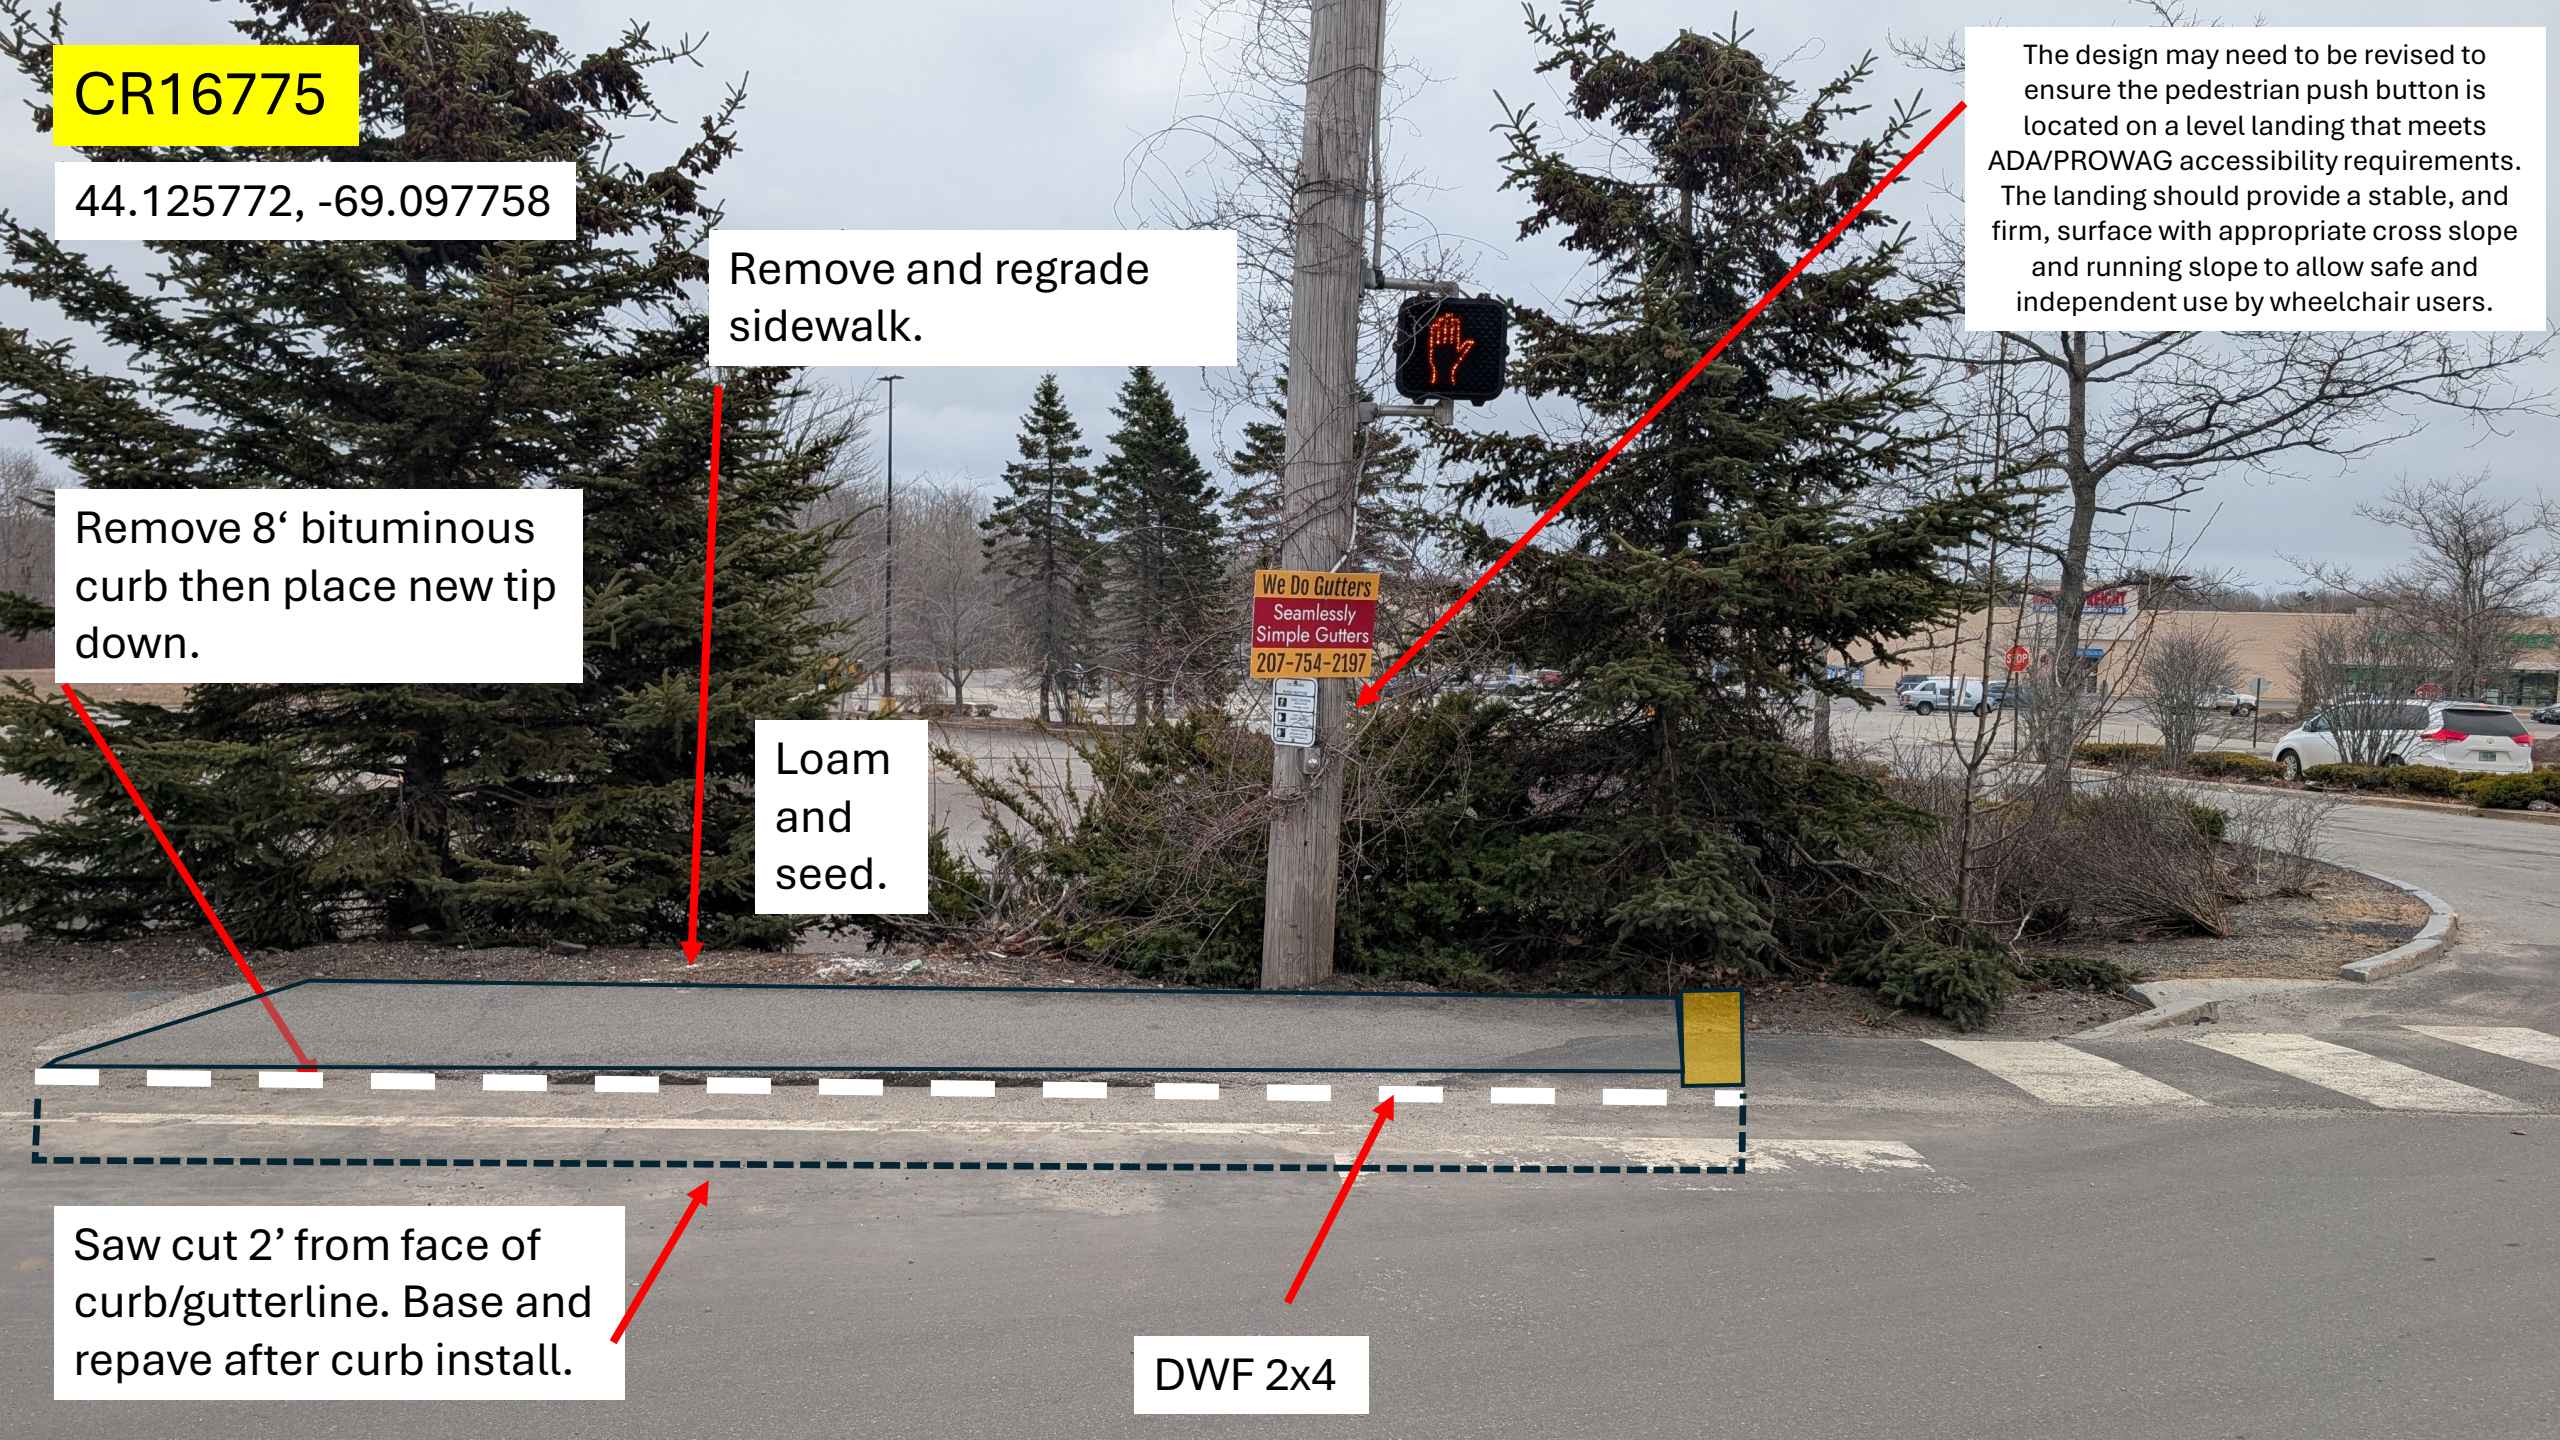

CR16774

44.125525, -69.097931

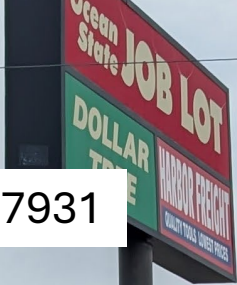

Loam
and
seed.

Remove and regrade
sidewalk.

DWF 2x4

Add 25' of new
Bituminous curb

Saw cut 2' from face of
curb/gutterline. Base and
repave after curb install.



RAMP REPORT REGION 2 ADA 2026

Marketplace Crossing

Rockland

New Ramp # Marketplace

44.116753, -69.103624

Loam
and
seed


Remove & Regrade
sidewalk

4'x4'
Turning
Area

DWF 2x6

Saw cut 2' from face of
curb/gutter line. Base and
repave after curb install.

Remove 8' bituminous curb
then place new tip down.

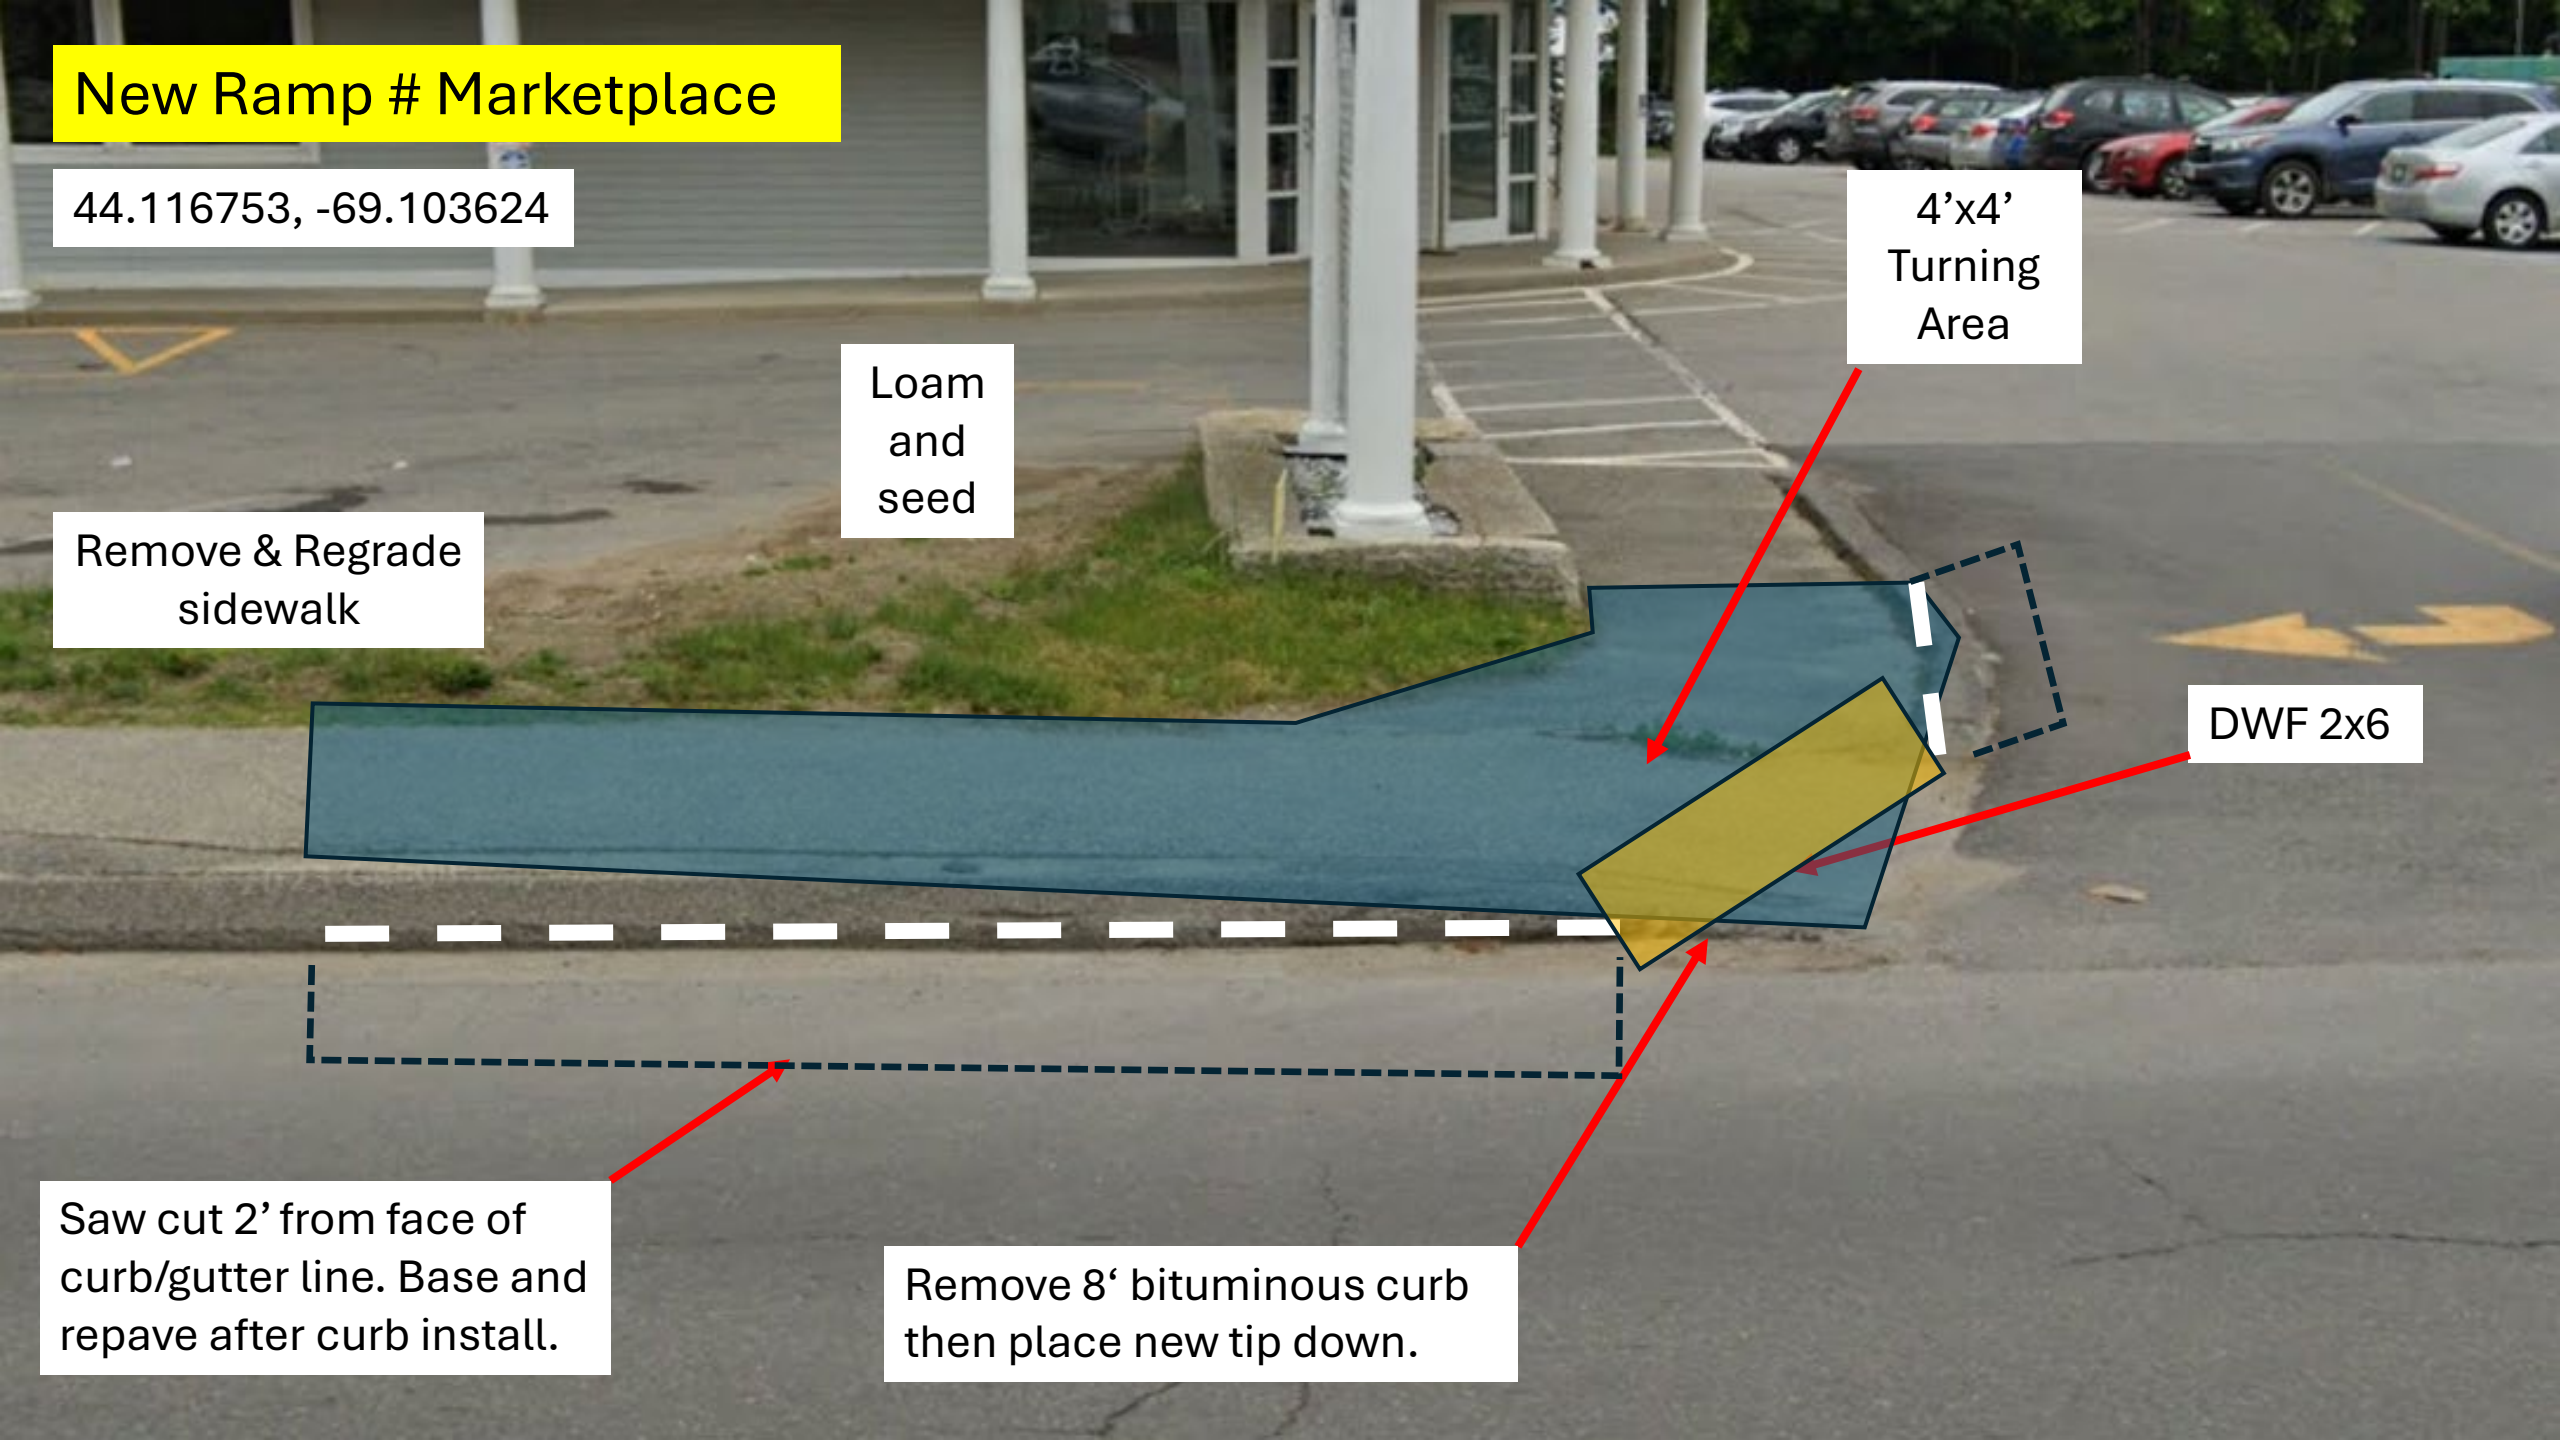

New Ramp

44.116753, -69.103624

Construct
sidewalk

Loam
and
seed

4'x4'
Turning
Area

Move the existing
crossing down to this
location

Saw cut 2' from face of
curb/gutter line. Base and
repave after curb install.

DWF 2x4

Remove bituminous curb
then place new tip downs.

