



40-7" ϕ x 0'-3 1/2"
60-7" ϕ x 0'-3" - H.S. BOLTS REQ'D. PER SPLIC.

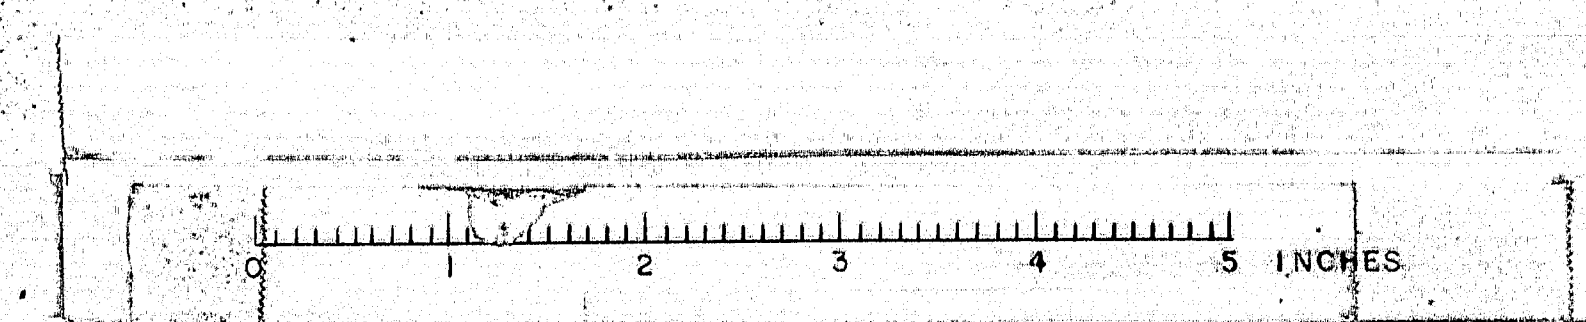


APP'D. AS NOTED 9-16-2

95-7



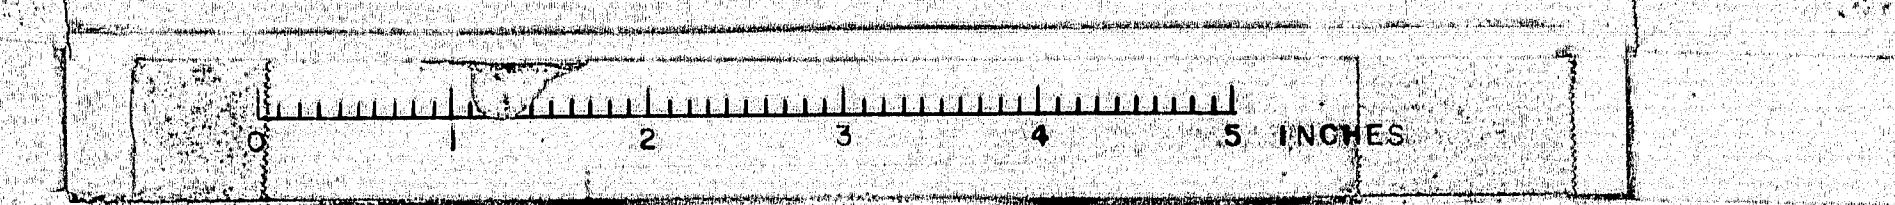




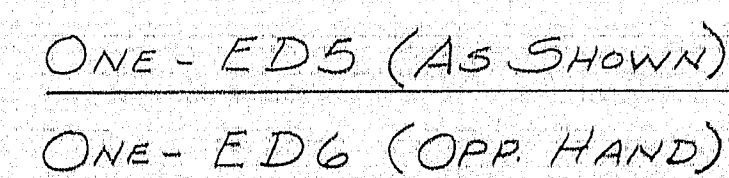


SHOP CONNECTIONS: WELD
FIELD CONNECTIONS:
HOLES: NONE
PAINT: STATE SPEC'S

SIDEWALK EXPANSION DAMS

PRINT ISSUE		Bancroft & Martin Inc.	
		Brewer, Maine	
2	SHC 10-15-64	RTE. #155 OVER INTERSTATE #95	
3	DIST. 10-9-64	HOWLAND, MAINE	
5	SHOP 9-22-64		
2	F.A. 9-11-64	CUSTOMER REED & REED	
	9-10-64 R.A.M.	DESIGNER MAINE STATE HIGHWAY COMM.	
REVISION			
REVISION		ORDER VERBAL DWG. 64-245-54	
REVISION			

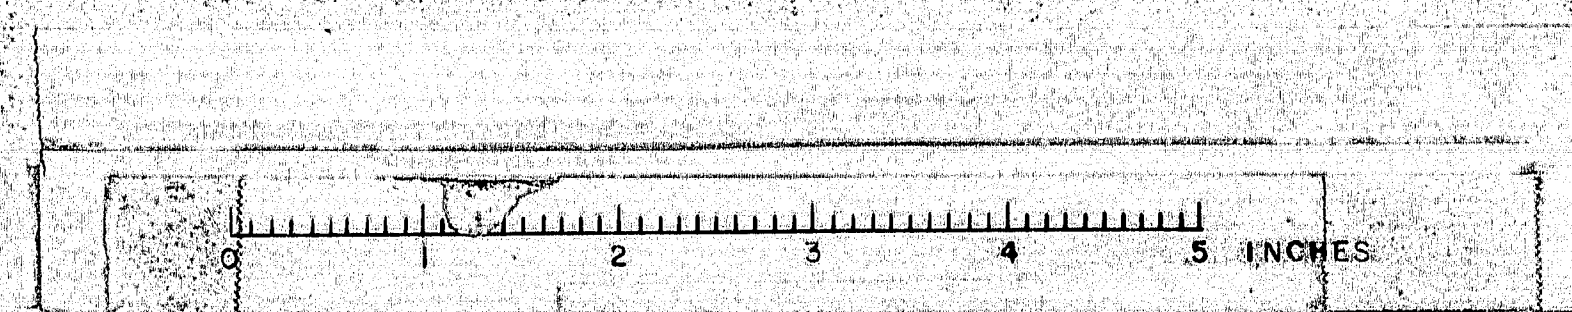

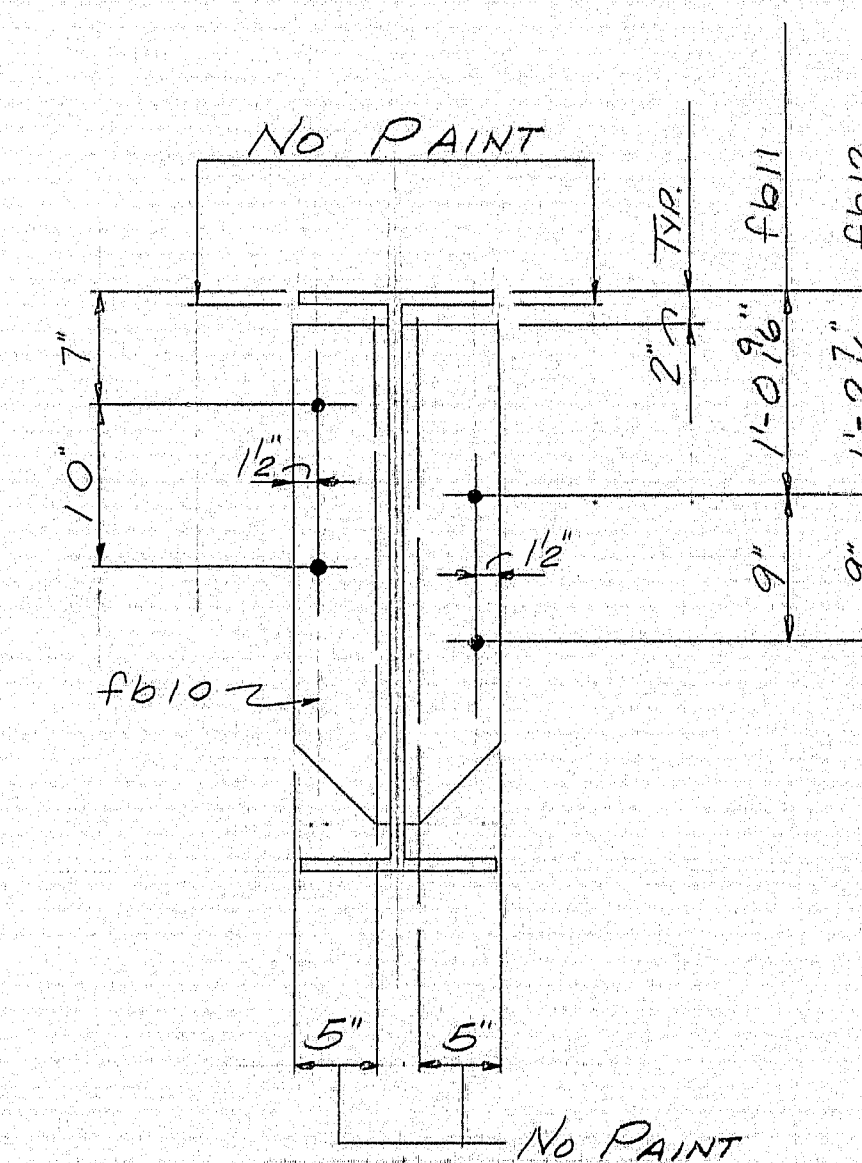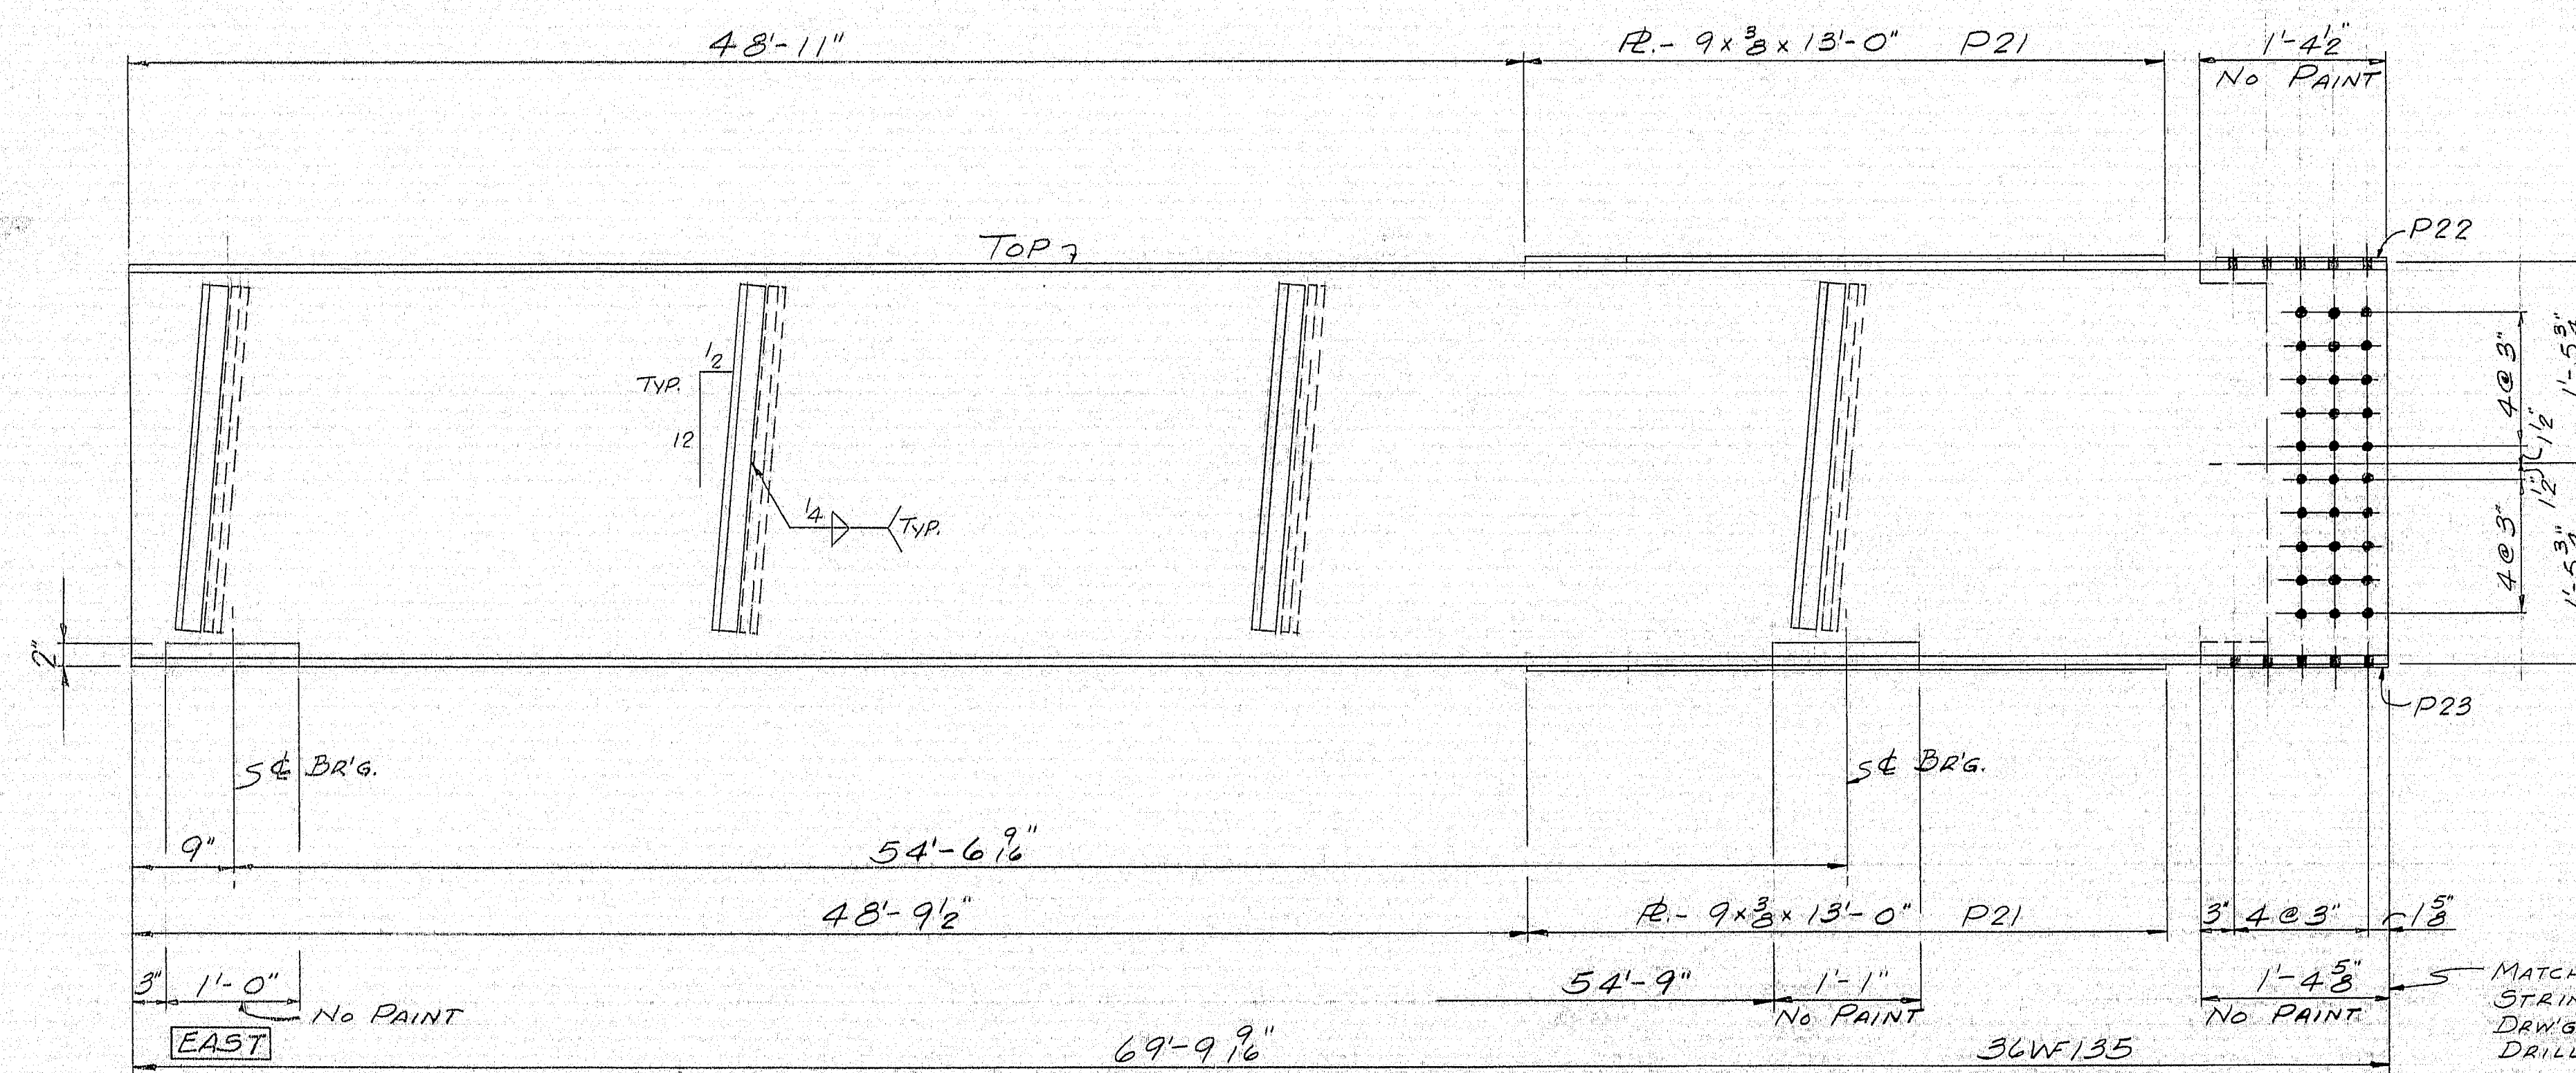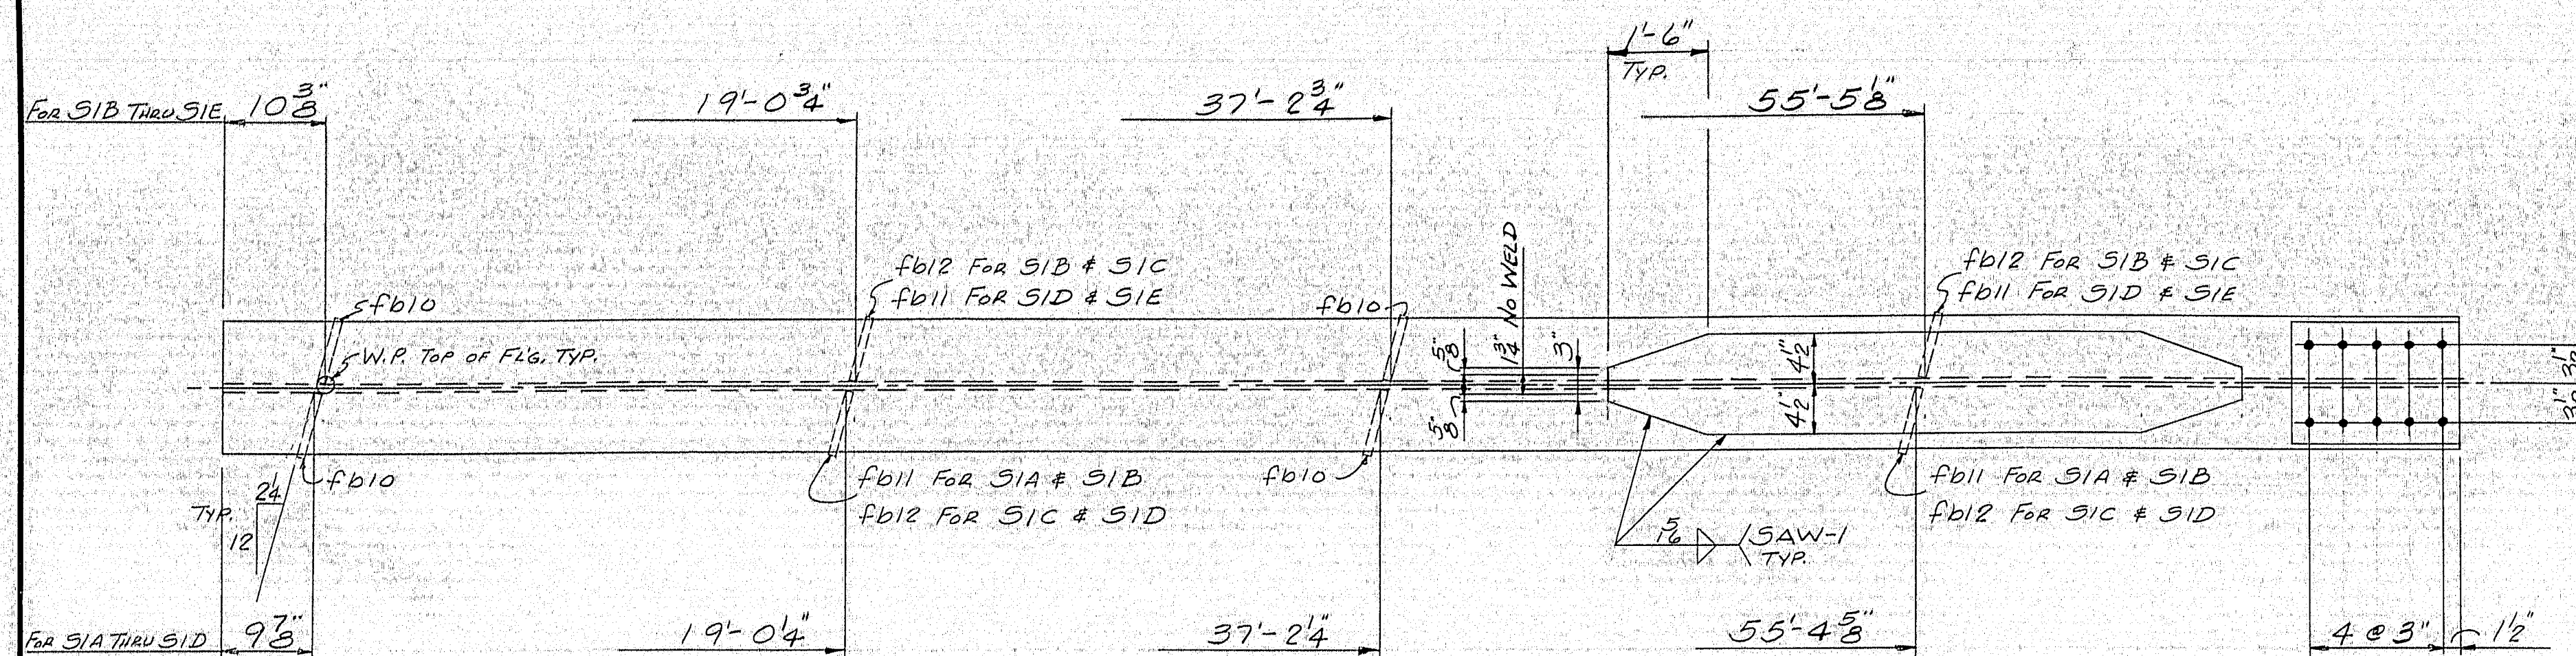

ONE - SIA, SIB, SIC, SID, & SIE


SHIP		BILL OF MATERIAL			DWG. B64-245-55	
MARK	NO.	MARK	SHAPE	LENGTH	WT.	REMARKS
SIA	1		36W135	69'9 1/2"		A-36
SIB	1		Do	69'9 1/2"		
SIC	1		Do	69'9 1/2"		
SID	1		Do	69'9 1/2"		
SIE	1		Do	69'9 1/2"		
	10	P21	R-9 x 3/8	13'0"		
	5	P22	R-11 x 3/8	1'3"		
	5	P23	Do	1'3 1/2"		
	16	fb10	BAR-6 x 3/8	2'7"		
	8	fb11	Do	2'7"		
	8	fb12	Do	2'7"		
FIELD	1020		3/8" H.S. BOLT	0'3 1/2"		A325 HEAVY HEAD
Do	1530		Do	0'3"		A325 W/HEAVY NUT
Do	400		3/4" MACH. BOLT	0'1 3/4"		FOR DIAPHRAGMS
Do	2550		3/8" H.S. WASHER			A325


E70 LOW HYDROGEN ROD
 SHOP CONNECTIONS: UNLESS NOTED
 FIELD CONNECTIONS: WELD # 3/8" H.S. BOLT
 HOLES: 1 1/2" #
 PAINT: STATE OF MAINE SPEC'S.

APP'D. AS NOTED 10-14-64

STRINGERS		SPAN #1	
PRINT ISSUE		Bancroft & Martin Inc.	
		Brewer, Maine	
2	SHC	10-15-64	RT. #155 OVER INTERSTATE #95
3	DIST.	10-15-64	HOWLAND, MAINE
5	SHOP	10-15-64	
2	FA.	10-8-64	
DRAWN 10-3-64 R.A.M.		CUSTOMER REED & REED	
REVISION		DESIGNER MAINE STATE HIGHWAY COMM.	
REVISION		ORDER VERBAL	
REVISION		DWG. B64-245-55	

95-10-12

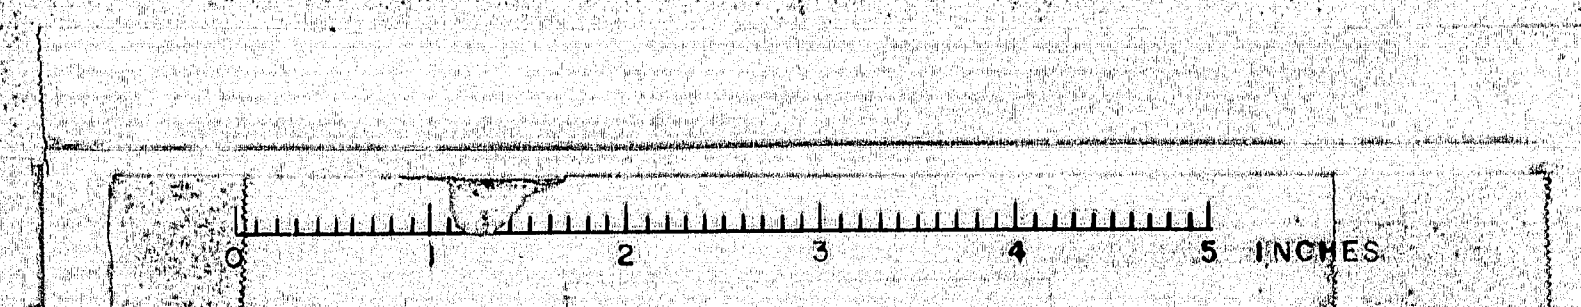


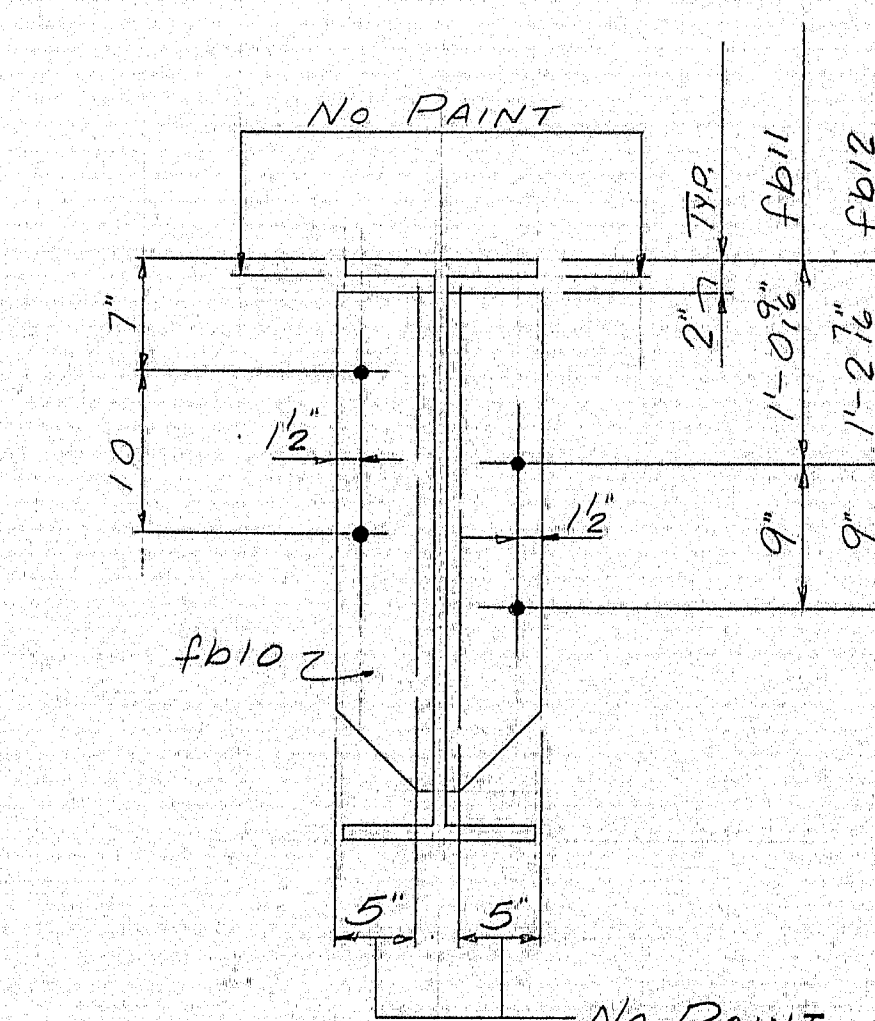


770' LOW HYDROGEN ROD
SHOP CONNECTIONS: UNLESS NOTED
FIELD CONNECTIONS: WELD & 3" & H.S. BOLT
HOLES: 1 1/2" &
PAINT: STATE OF MAINE SPEC'S.

STRINGERS SPAN #2


PRINT ISSUE		<i>Bancroft & Martin Rollings Mills Company</i> <i>Brewer, Maine</i>	
2	J.H.C. 10-15-64	RTE. #155 OVER INTERSTATE #95 HOWLAND, MAINE	
3	DIST. 10-15-64		
5	SHOP 10-15-64		
2	F.A. 10-8-64		
DRAWN 10-5-64 R.A.M.		CUSTOMER <u>REED & REED</u>	
REVISION		DESIGNER <u>MAINE STATE HIGHWAY COMM.</u>	
REVISION			
REVISION		ORDER <u>VERBAL</u>	DWG <u>64-245-56</u>

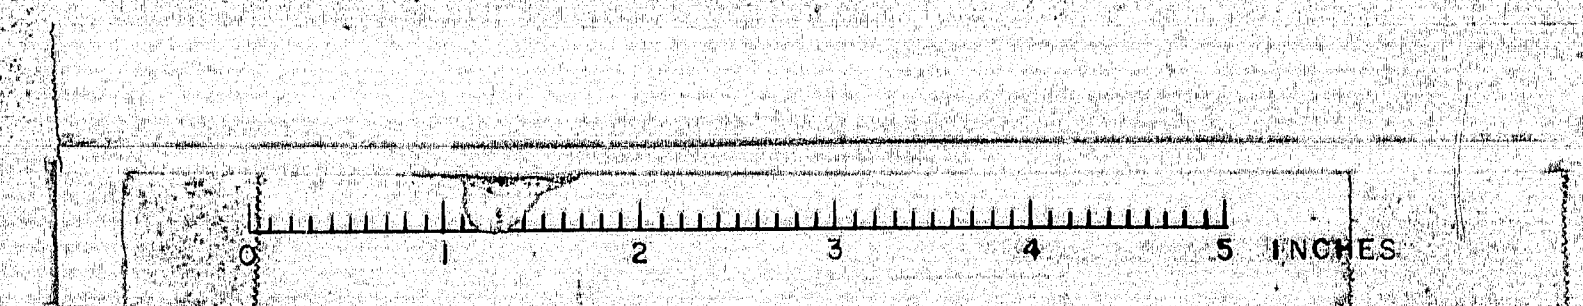


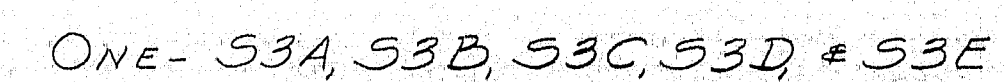

E70 LOW HYDROGEN ROD
 SHOP CONNECTIONS: UNLESS NOTED
 FIELD CONNECTIONS: WELD & 3" H.S. BOLT
 HOLES: 1 1/2" ϕ
 PAINT: STATE OF MAINE SPEC'S.

PRINT ISSUE		<i>Bancroft & Martin Rolling Mills Company</i> <i>Brewer, Maine</i>	
2	S.H.C. 10-15-64	RTE. #155 OVER INTERSTATE #95	
3	Dist. 10-15-64	HOWLAND MAINE	
5	SHOP 10-15-64		
2	F.A. 10-8-64		
DRAWN	10-6-64 R.A.M.	CUSTOMER REED & REED	
REVISION		DESIGNER MAINE STATE HIGHWAY COMM.	
REVISION			
REVISION		ORDER VERBAL	DWG. B64-245-57

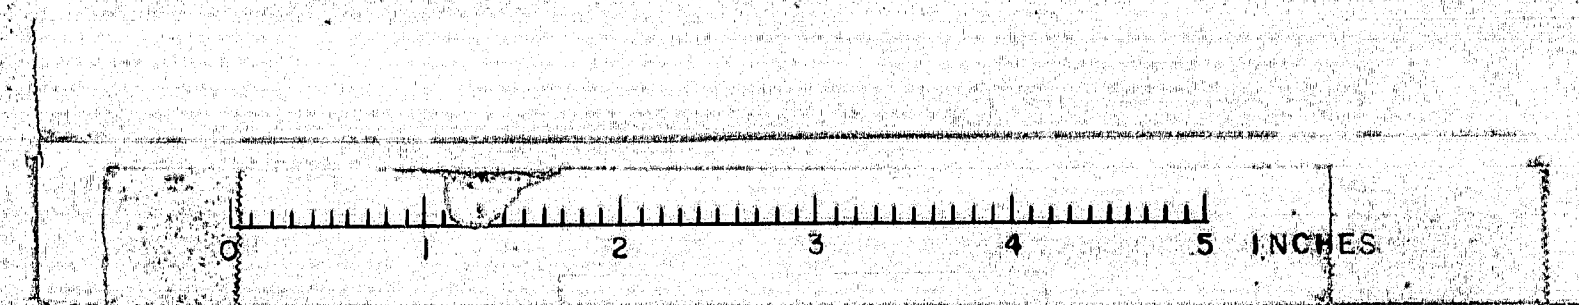


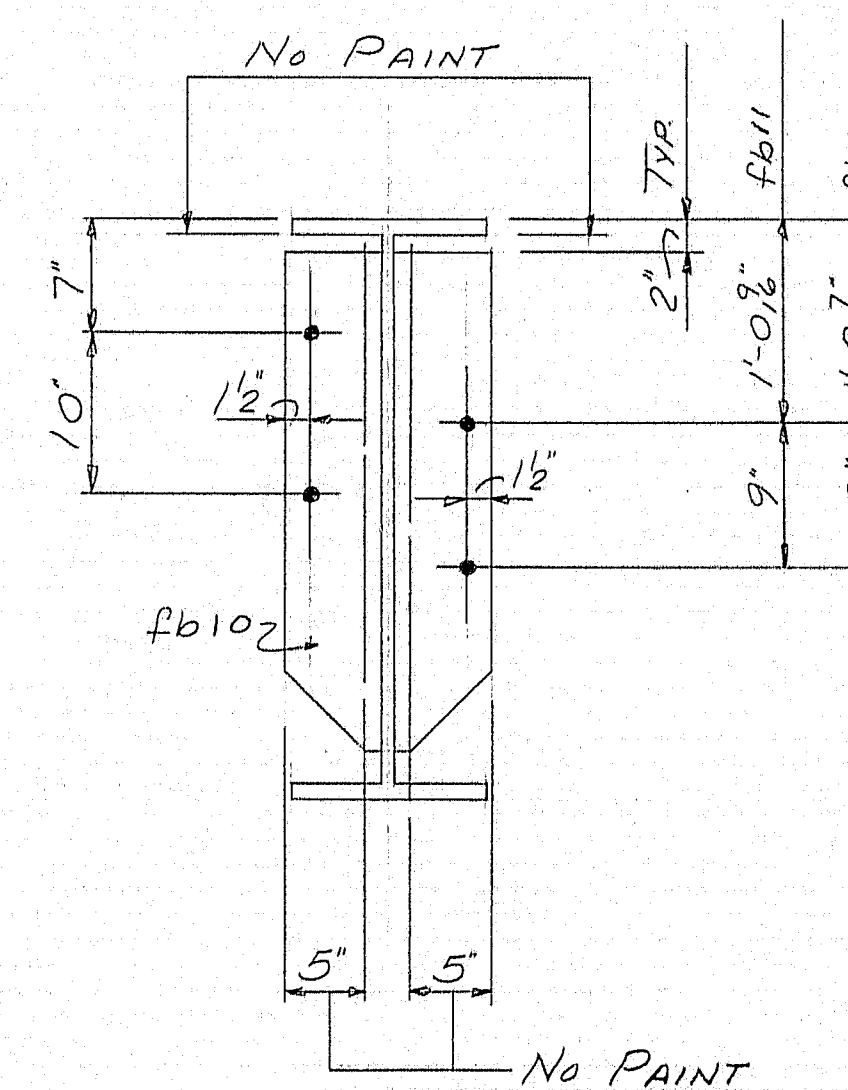

MATCH THIS END WITH EAST END OF
STRINGERS 55A THRU 55E. SEE DRW'G
B64-245-E2 FOR SPLICE DRILLING &
ELEVATION DIAGRAM.

ETO LOW HYDROGEN ROD
SHOP CONNECTIONS: UNLESS NOTED
FIELD CONNECTIONS: WELD # 3" ϕ H.S. BOLT
HOLES: $\frac{1}{16}$ " ϕ
PAINT: STATE OF MAINE SPEC.

DWG. B64-245-58

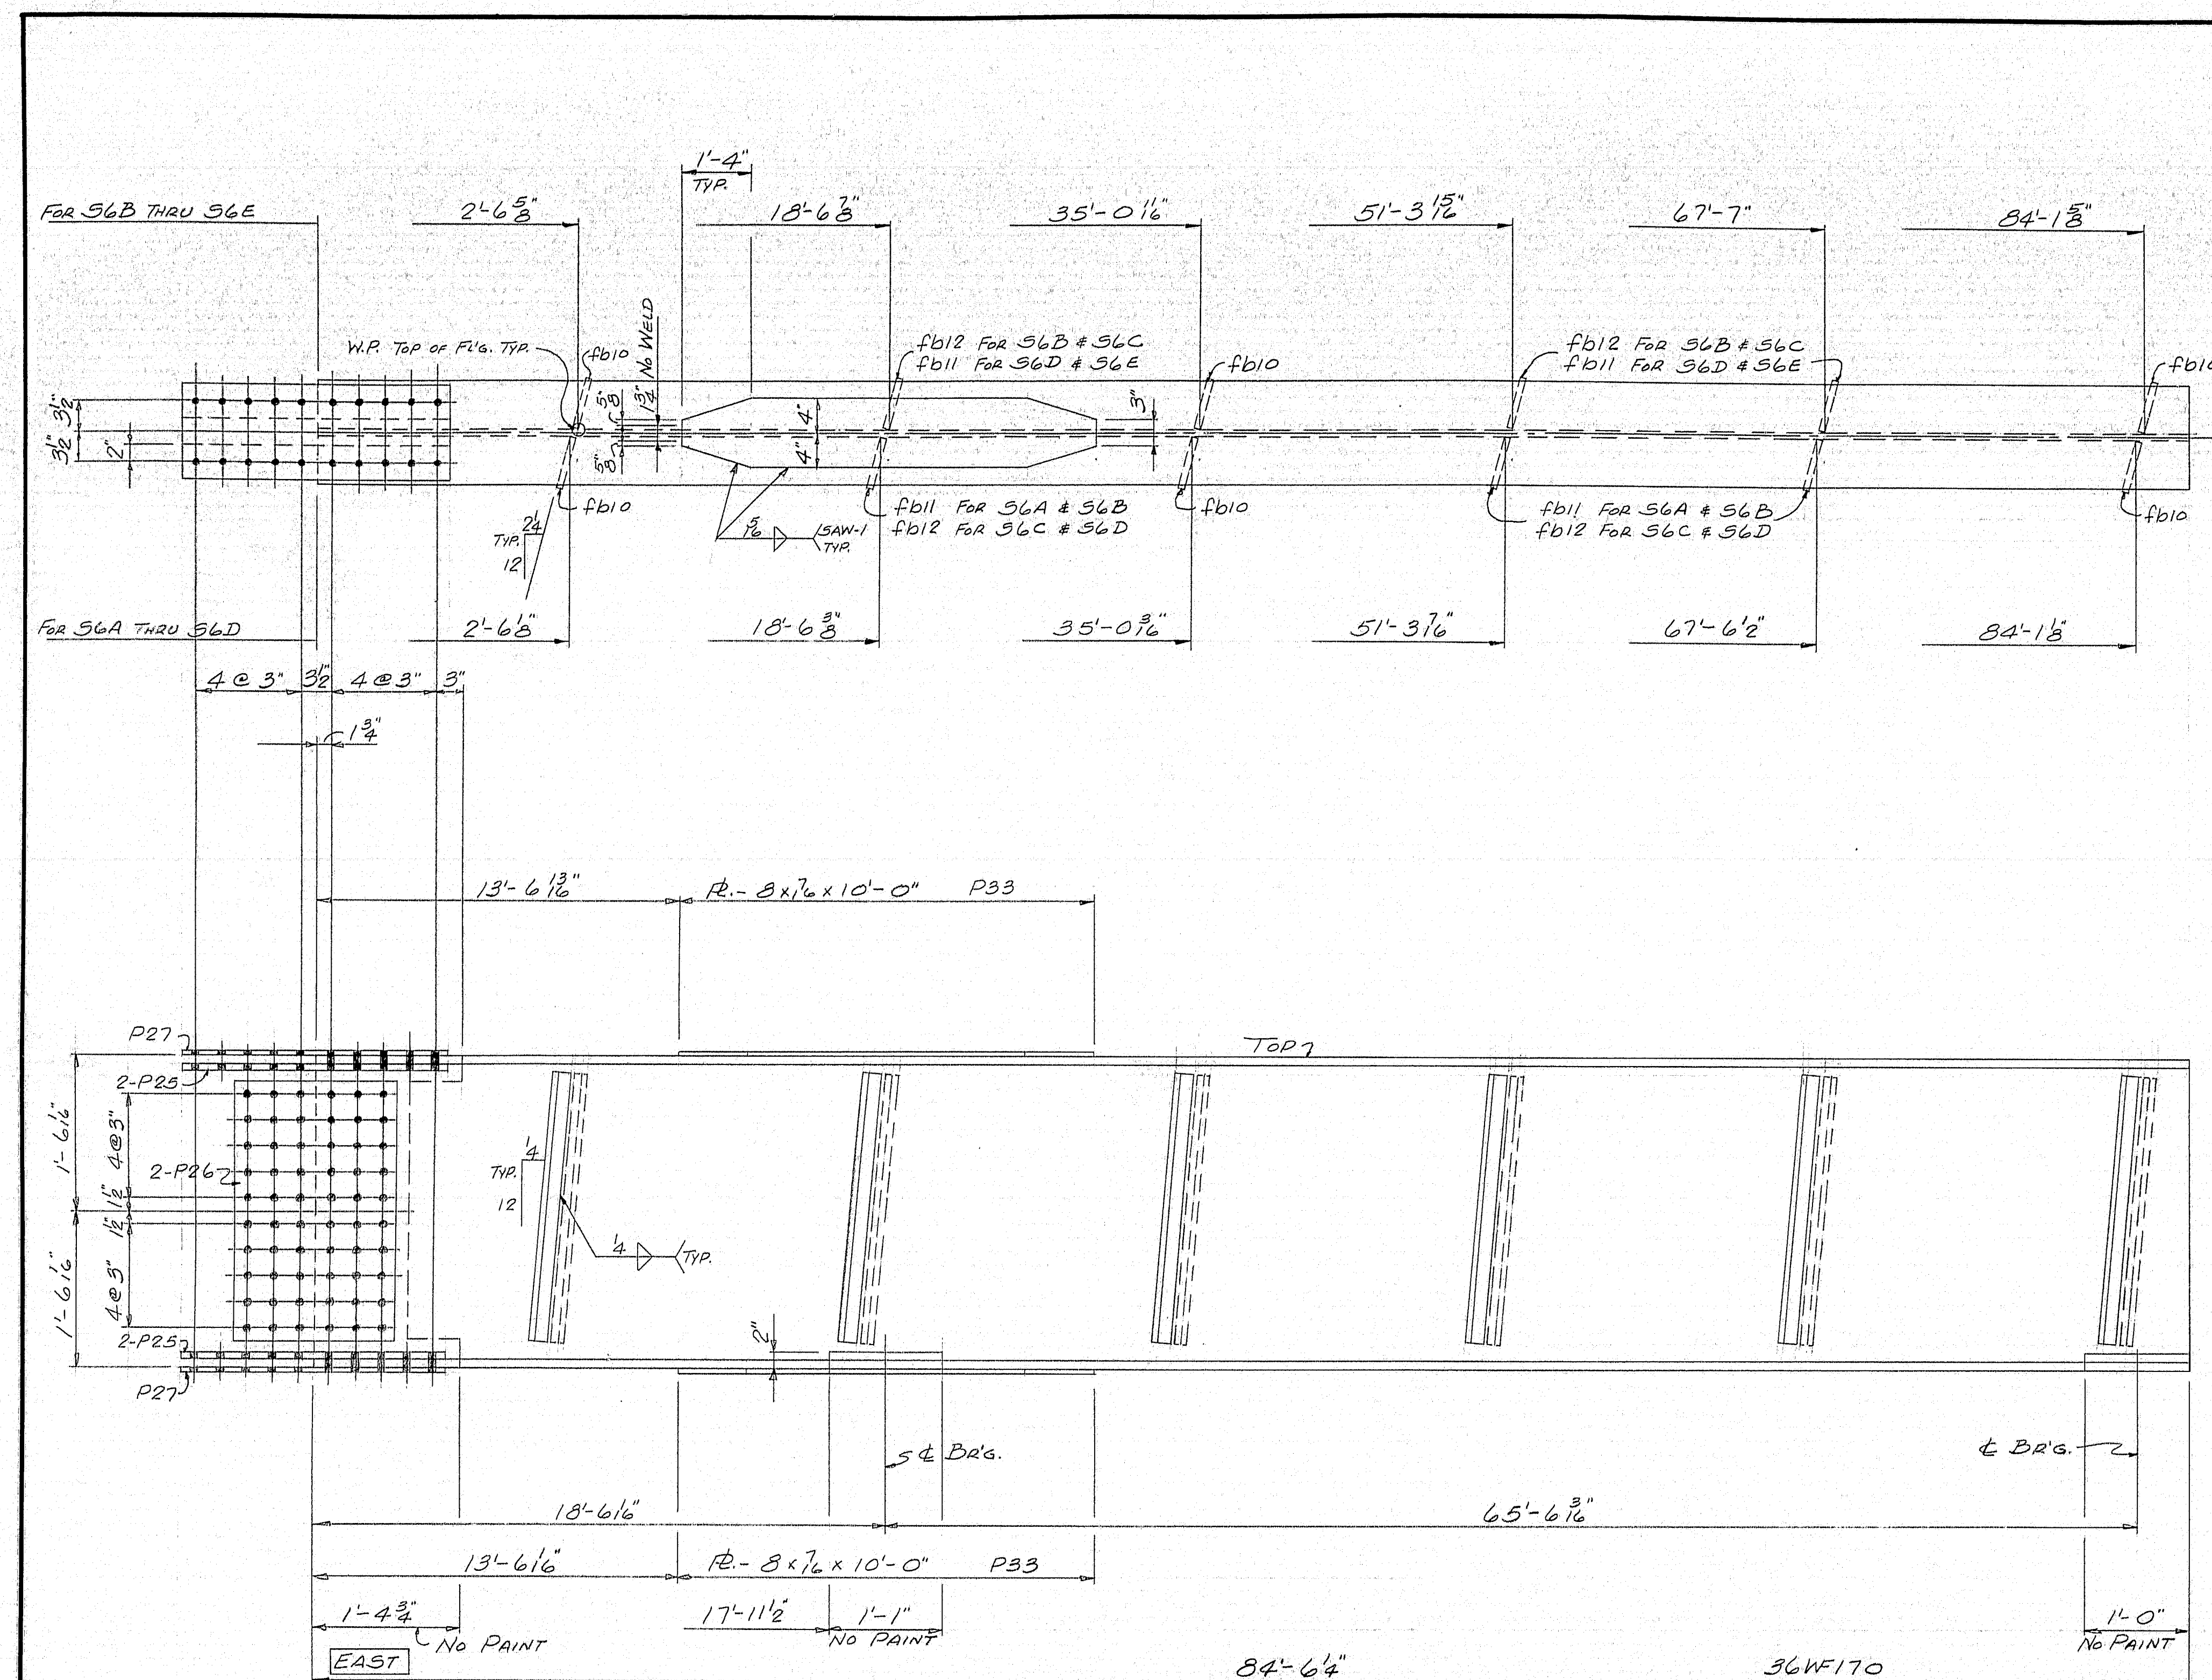

ONE- S6A, S6B, S6C, S6D, & S6E

SHIP		BILL OF MATERIAL				DWG. B64-245-510
MARK	NO.	MARK	SHAPE	LENGTH	WT.	REMARKS
S6A	1		36WF170	84' 6 1/4"		A36
S6B	1		Do	84' 6 1/4"		
S6C	1		Do	84' 6 1/4"		
S6D	1		Do	84' 6 1/4"		
S6E	1		Do	84' 6 1/4"		
	20	P25	R-4 x 1 1/2	2' 6 1/2"		
	10	P26	R-18 x 2	2' 6"		
	10	P27	R-11 x 1 1/2	2' 6 1/2"		
	10	P33	R-8 x 7/16	10' 0"		
	24	fb10	BAR-6 x 3/8	2' 7"		
	12	fb11	Do	2' 7"		
	12	fb12	Do	2' 7"		

SHOP CONNECTIONS: E70 LOW HYDROGEN ROD
UNLESS NOTED
FIELD CONNECTIONS: WELD # 3/8" H.S. BOLT
HOLES: 1 1/8" Ø
PAINT: STATE OF MAINE SPEC'S.

APP'D. 10-14-64

PRINT ISSUE		STRINGERS SPAN #6	
2	S.H.C.	10-15-64	Bancroft & Martin Rolling Mills Company Brewer, Maine
3	DIST.	10-15-64	Rte. #155 OVER INTERSTATE #95 HOWLAND, MAINE
5	SHOP	10-15-64	
2	F.A.	10-8-64	
DRAWN	10-7-64	R.A.M.	CUSTOMER REED & REED
REVISION			DESIGNER MAINE STATE HIGHWAY COMM.
REVISION			ORDER VERBAL
REVISION			DWG. B64-245-510

