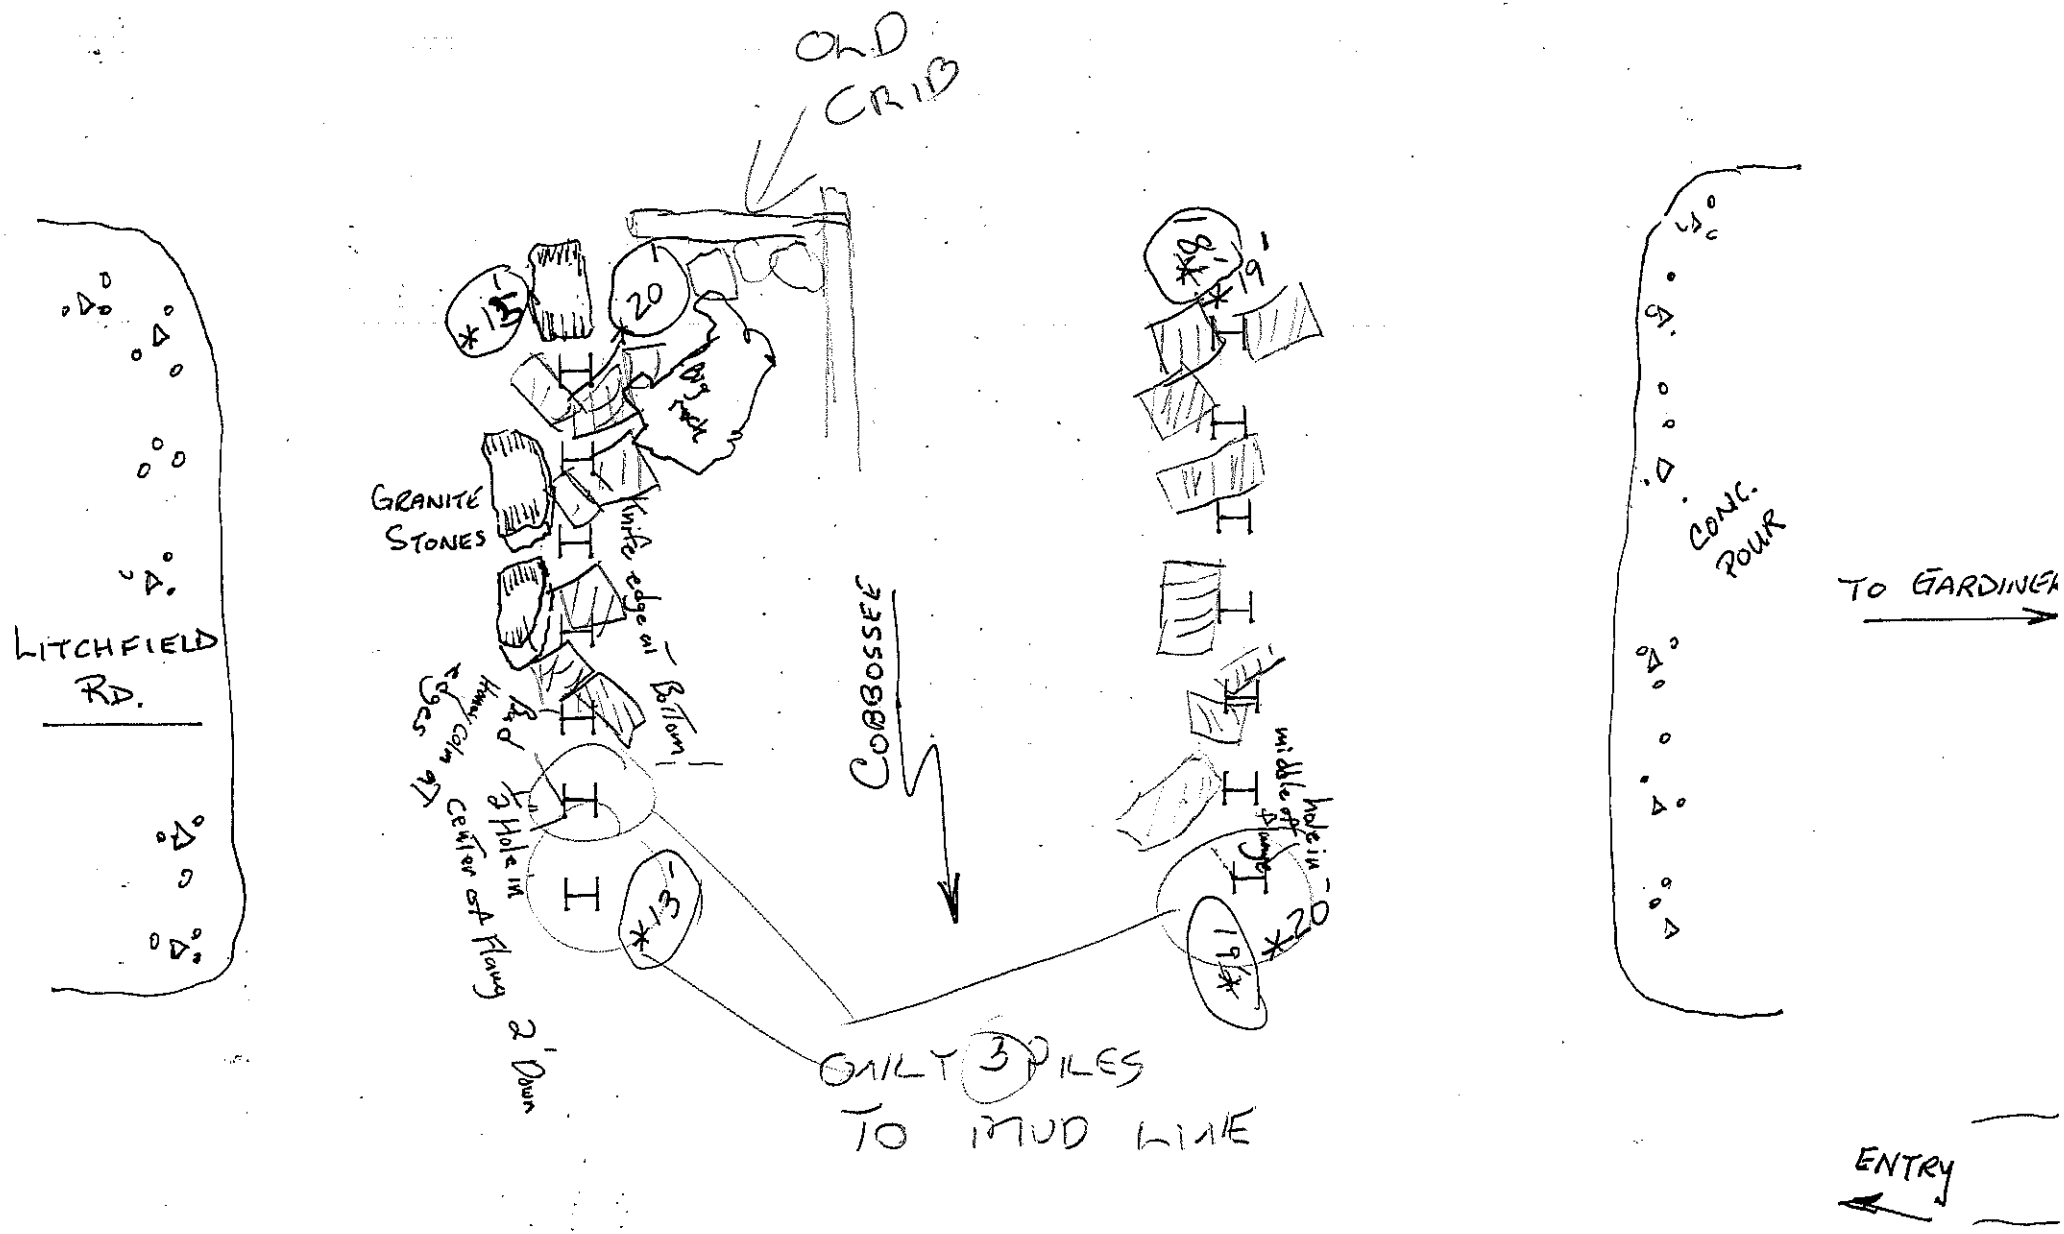

2834 WEST GARDINER TAPPAN 05-01-19