
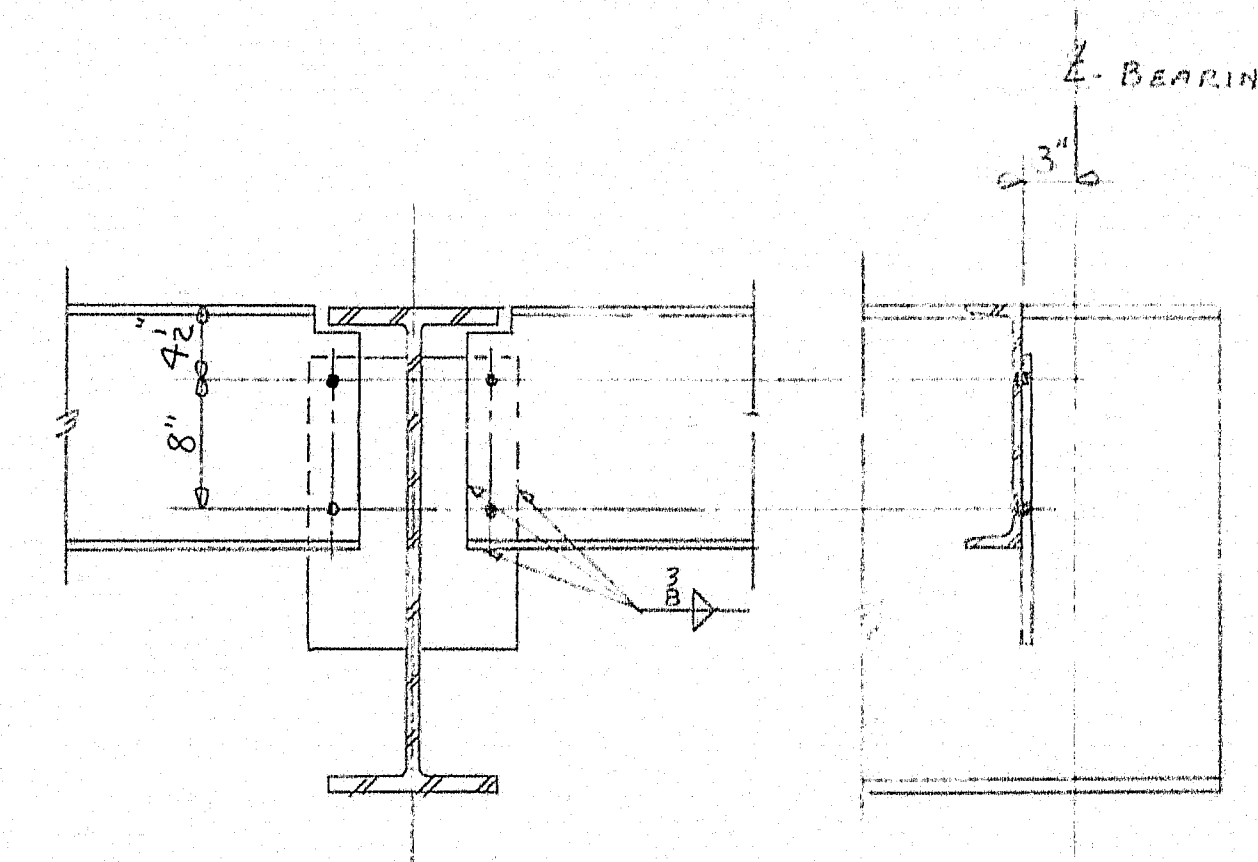
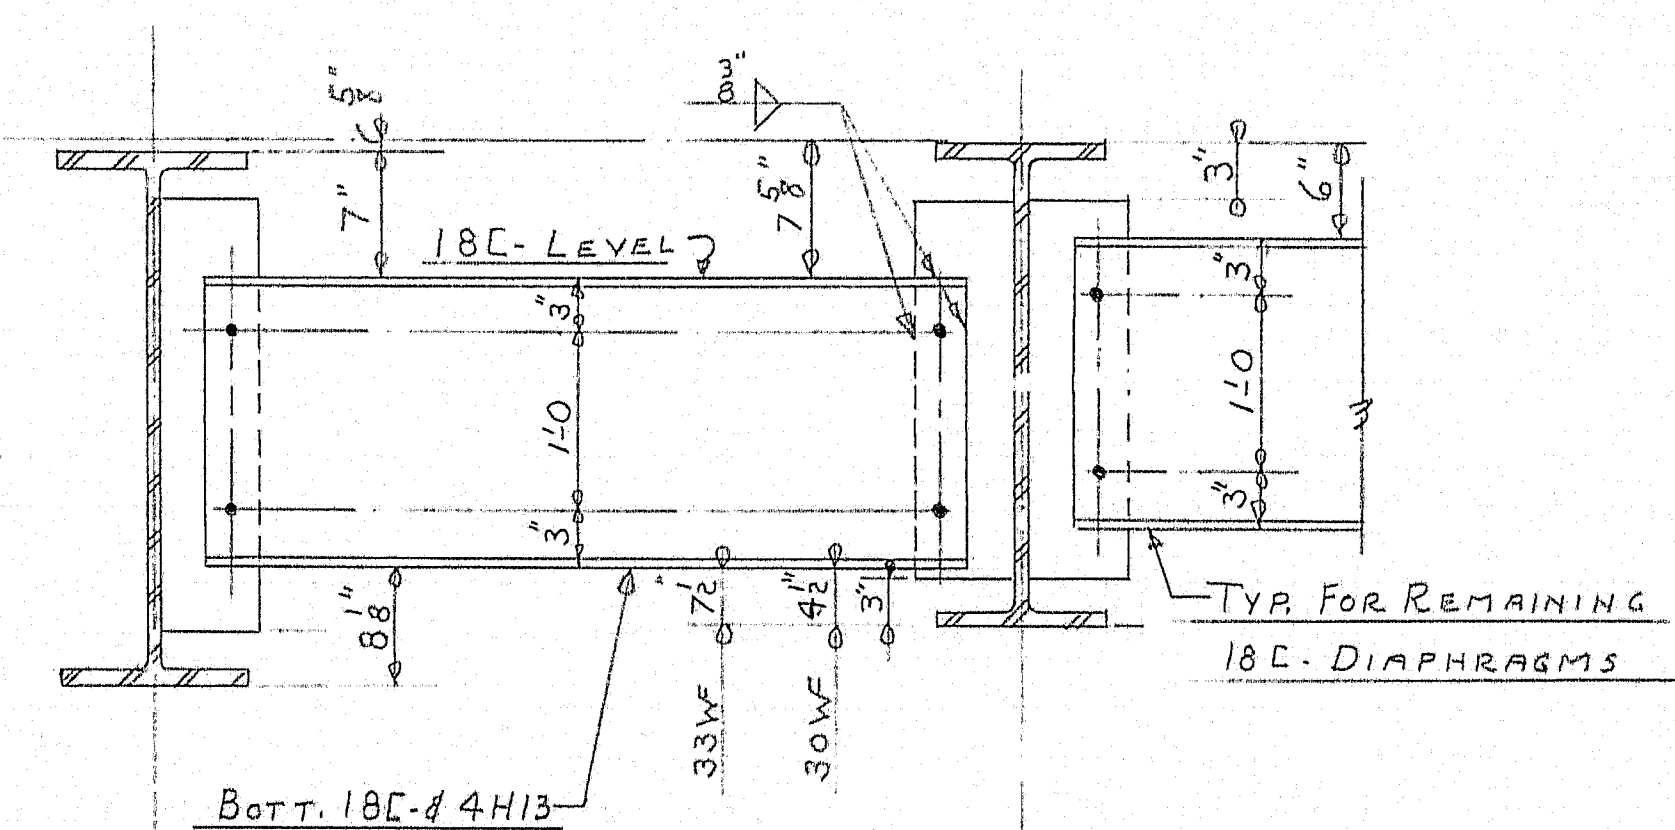
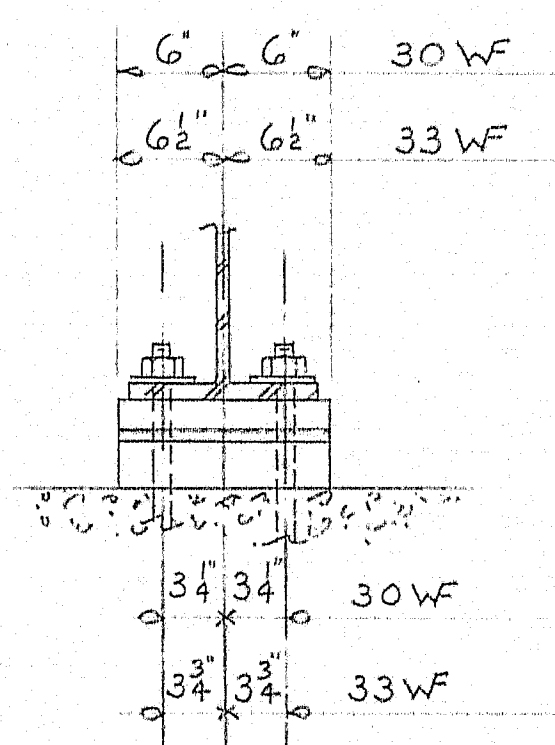
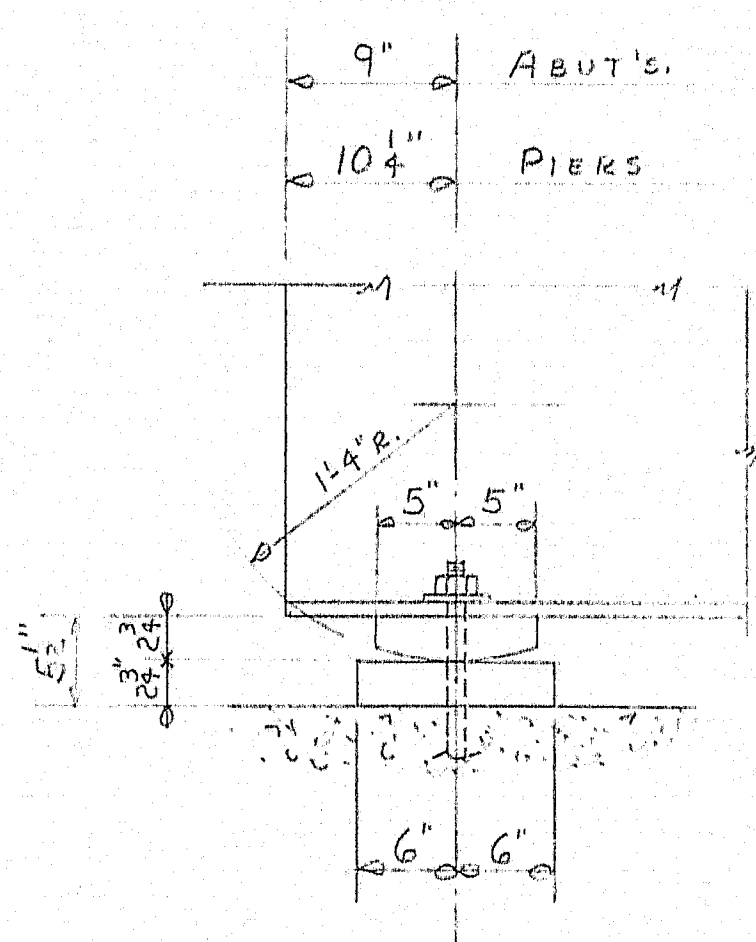


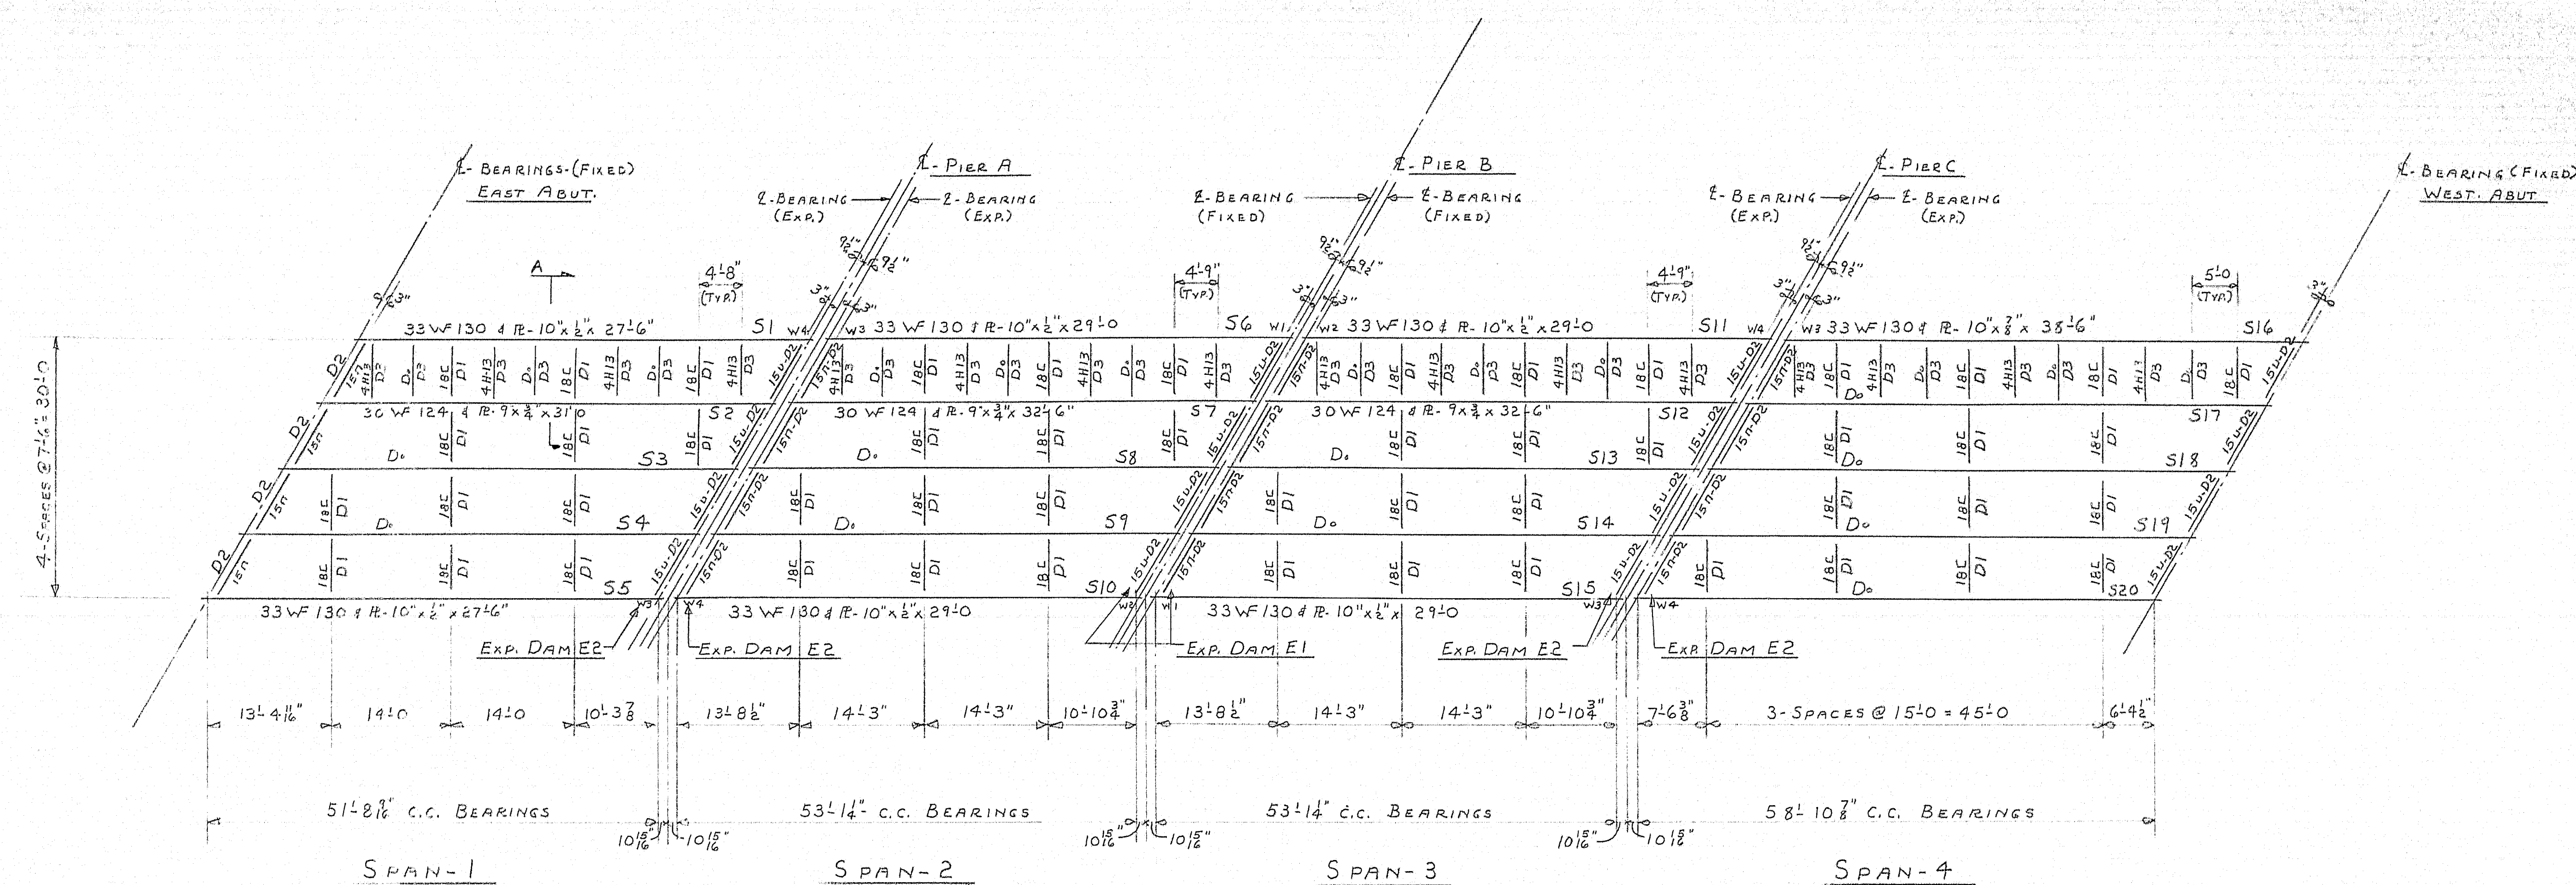

NOTES:
SHOP CONN'S WELDED
FIELD CONN'S DO
PAINT- STATE OF MAINE SPEC'S.
CAMBER SHOWN IS MINIMUM
LIKELY TO REMAIN PERMANENT

APPR-9-30-58
APPR, AS NOTED- 9-22-58

APPR, AS NOTED- 9-22-58

FRAMING PLAN

Bancroft & Martin Rolling Mills Company

Brewer, Maine

KENDUSKEAG AVE. BRIDGE
INTERSTATE # 95
BANGOR MAINE

INTERSTATE # 95
BANGOR MA

BANGOR MAINE

CUSTOMER SEABOARD ENG. CO. INC.

DESIGNER C. LARKESON ENG. CO. INC.

ORDER <u>VERBAL</u>	DWG. <u>B 8-257-E1</u>
---------------------	------------------------

4-DIST- 3-19-59
4-DIST- 12-16-58
1-SHOP- 10-22-58
4-DIST- 10-22-58
2-F/A- 9-29-58
2-F/A- 9-4-58

4-DIST-12-16-58

1-SHOP-10-22-58

4-DIST- 10-22-58

2-F/A-9-29-58




2 E/A-94-58

DRAWN	8-20-58	P.C.
-------	---------	------

REVISION	12-16-58	D.C.
----------	----------	------

REVISION		
REVISION		

REVISION		
----------	--	--

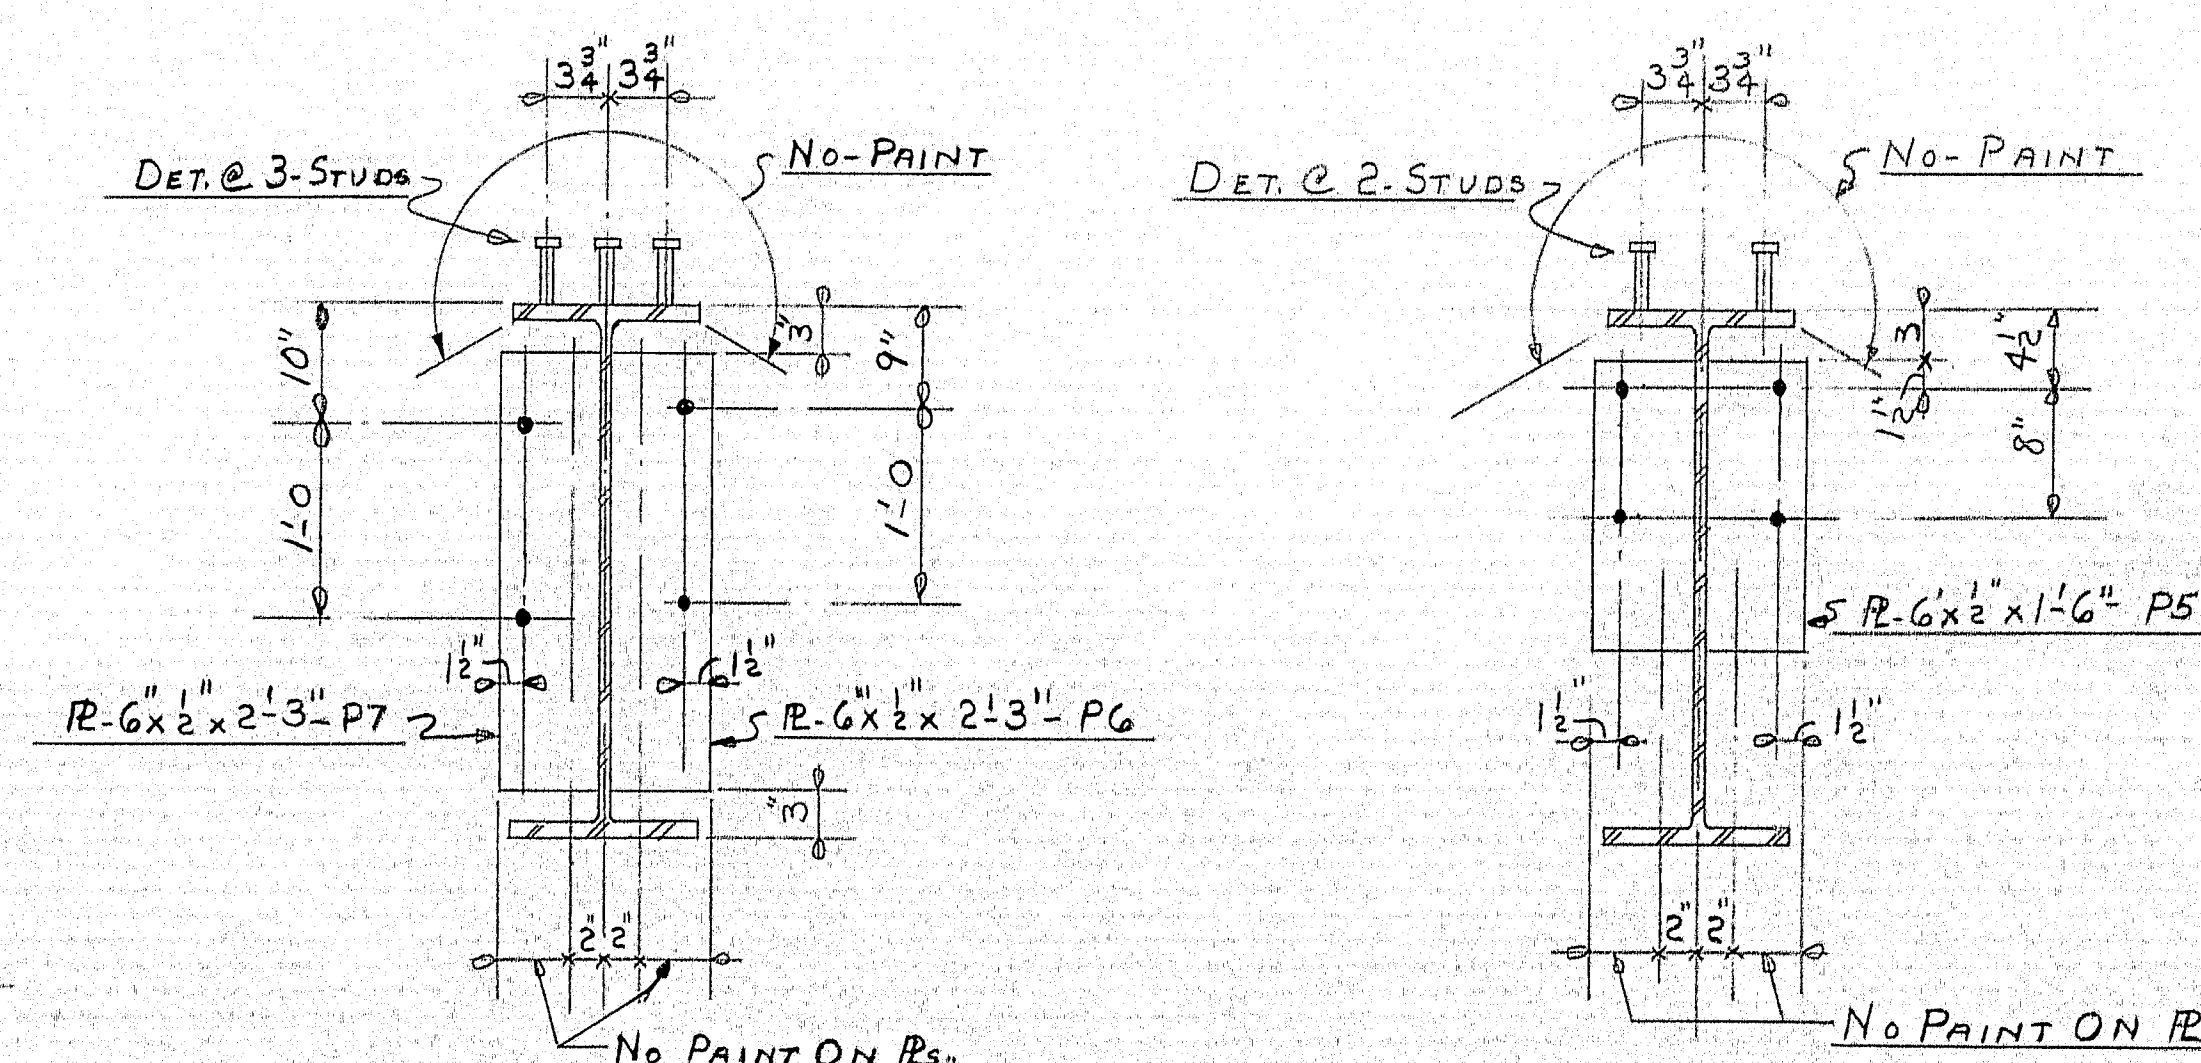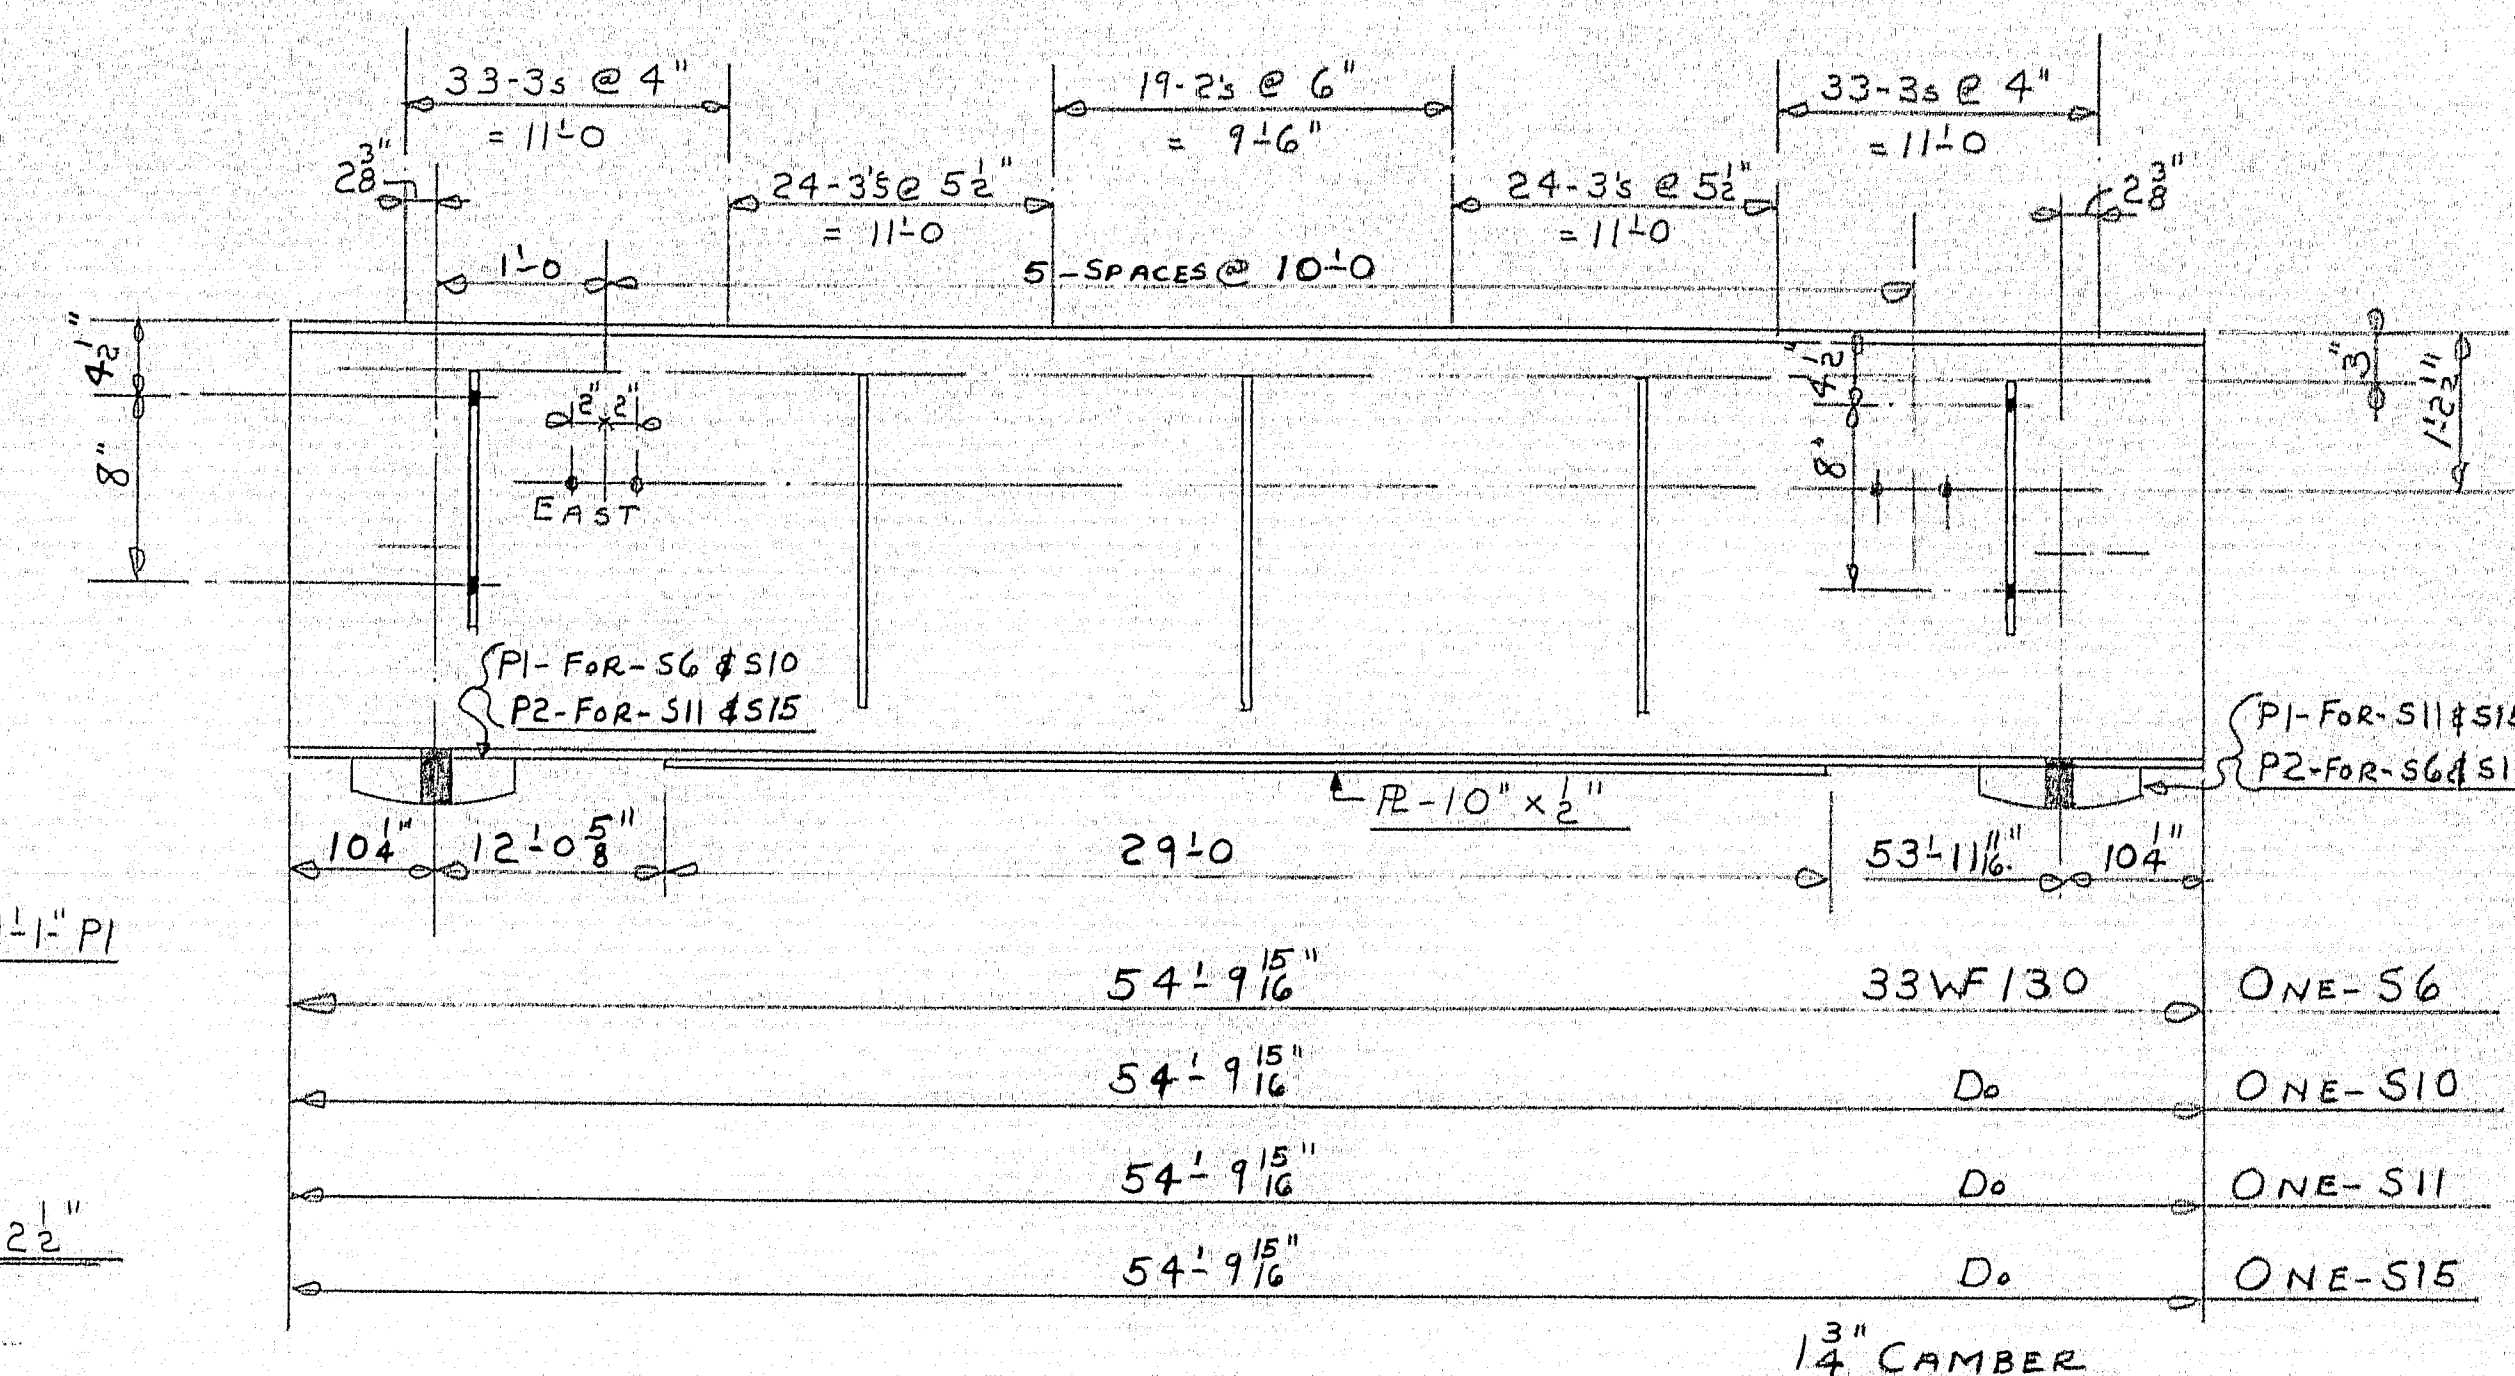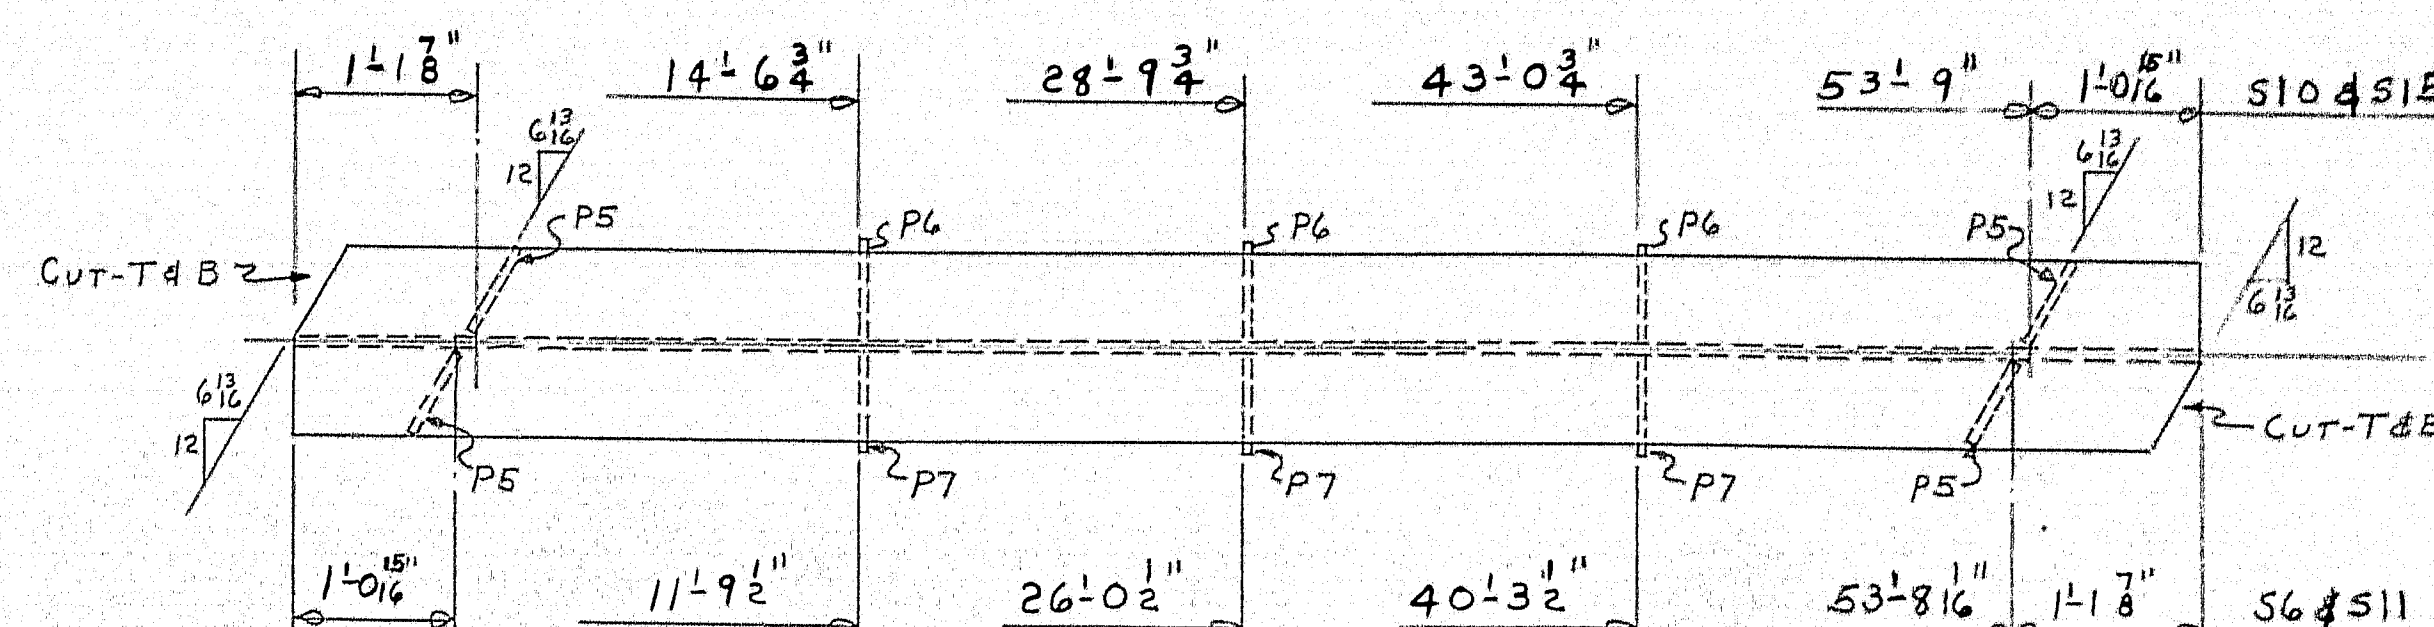

DETAIL OF DIAPHRAGM PLATES AND SHEAR CONNECTORS

SHOP CONNECTIONS: WELD
FIELD CONNECTIONS: D.
HOLES: 1 1/2" UNLESS NOTED
PAINT: ST. OR ME. SPEC'S.
RED LEAD TT-P-86
APPR. BY: NITRO- 9-22-58- 1-30-58

Appo. As Notes- 9-22-58- 9-30-58

STRINGERS

Bancroft & Martin Rolling Mills Company
Brewer, Maine


8 KENUSKEAG AVE. BRIDGE
INTERSTATE #95
BANGOR MAINE

CUSTOMER SEABOARD ENG. CO., INC.
DESIGNER CLARKESON ENG. CO., INC.

ORDER	VERBAL	DWG.	B8-257-52
-------	--------	------	-----------

4-DIST-3-19-59
4-SHOP-10-22-58
4-DIST-10-22-58
2-F/A-9-29-58
2-F/A-9-4-58

DRAWN	8-21-58	DIC
REVISION	9-29-58	DIC
REVISION	10-22-58	DIC
REVISION		

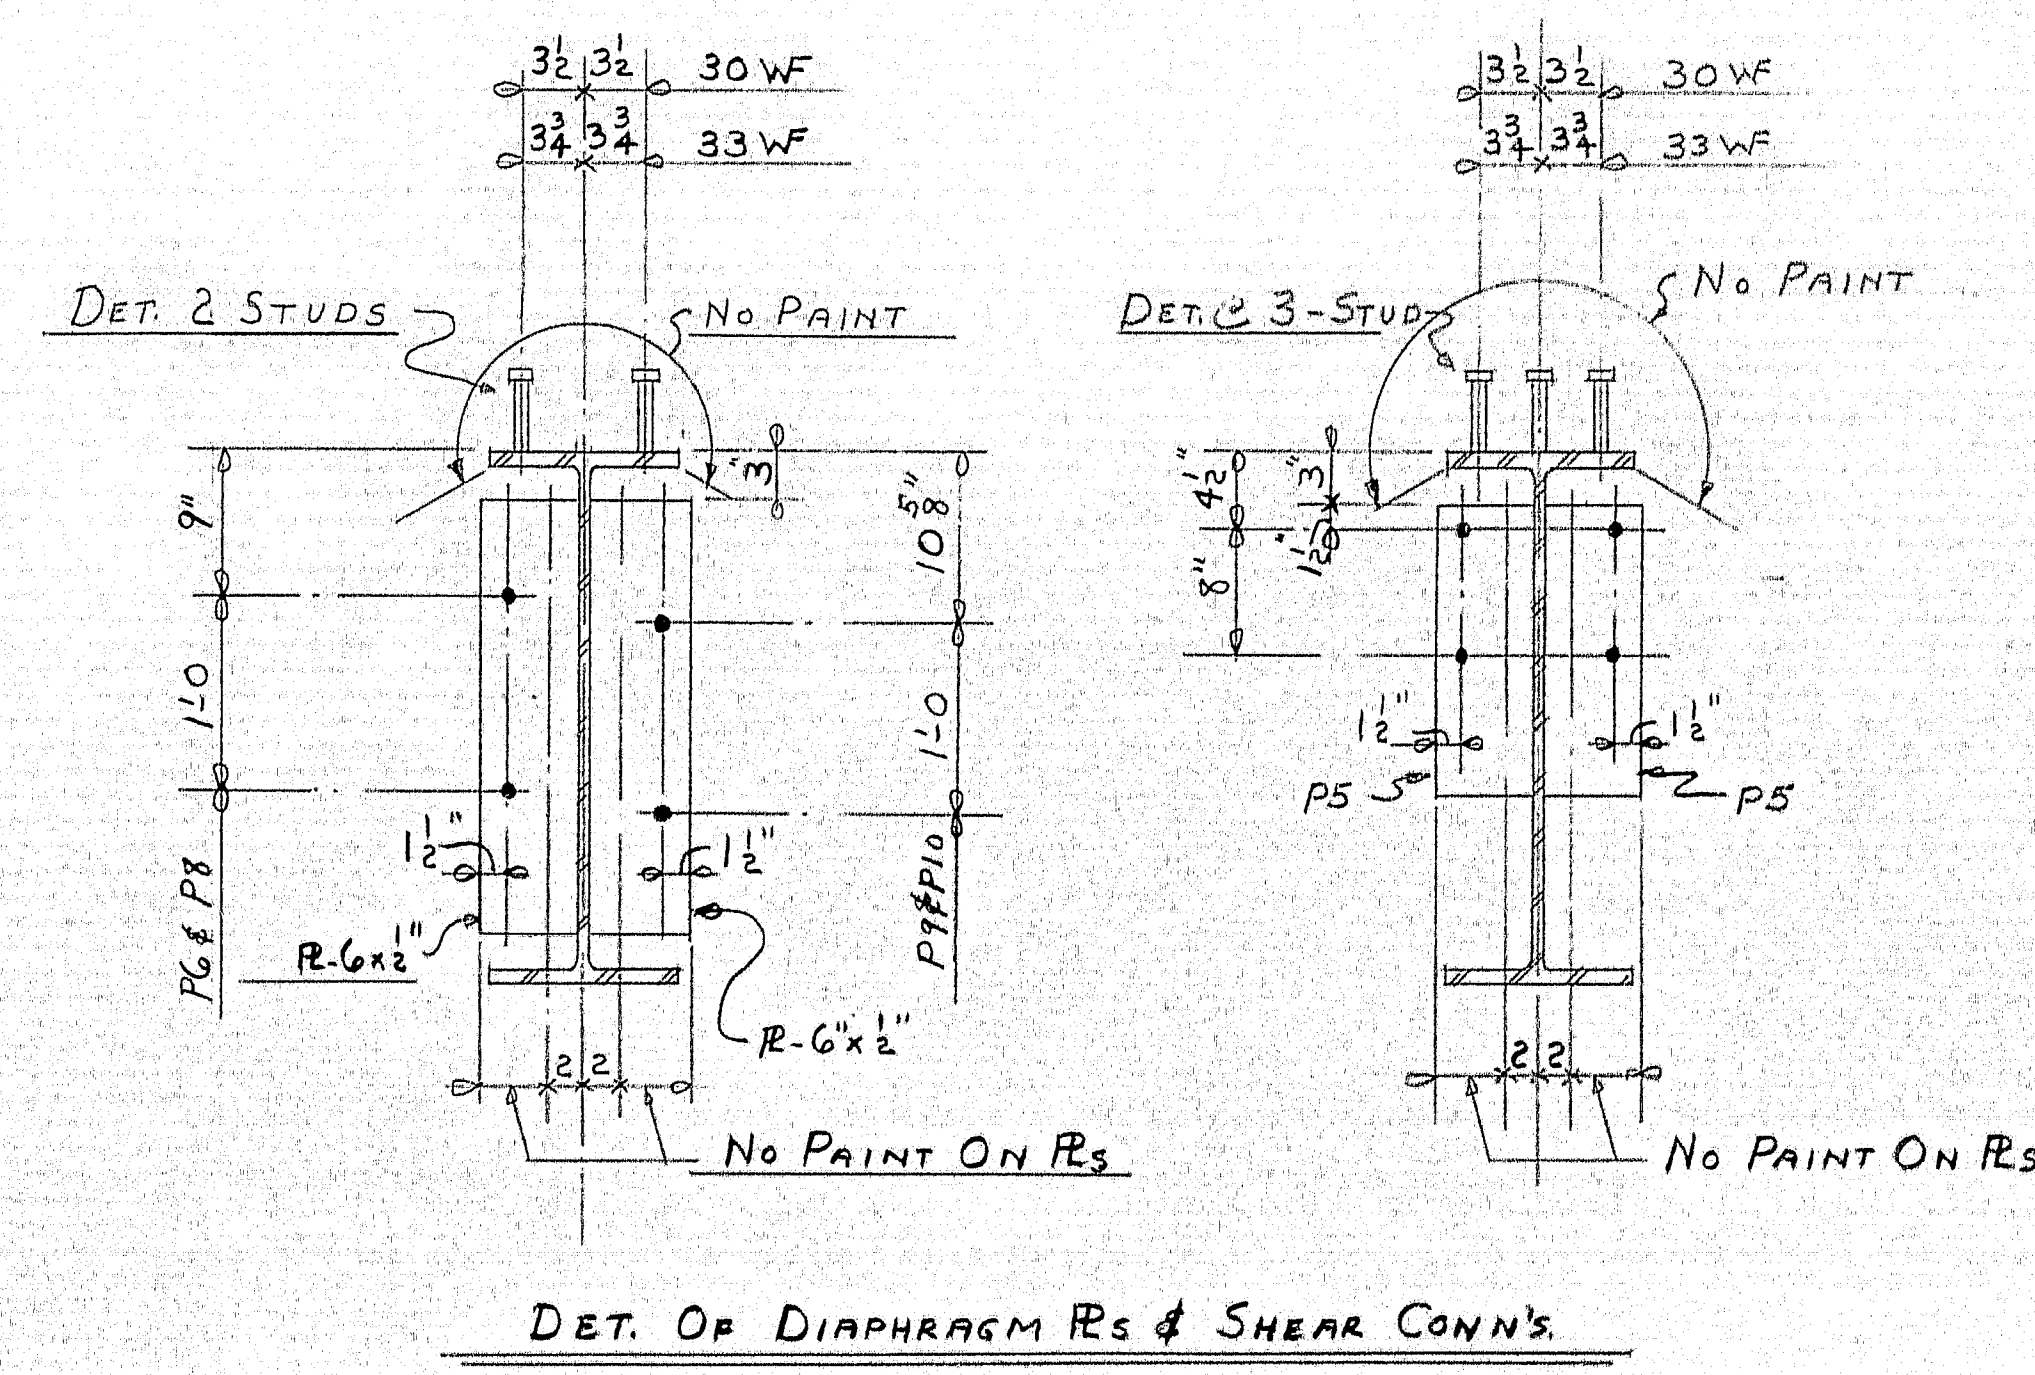


SHOP CONNECTIONS: WELD
FIELD CONNECTIONS: Do
HOLES: 1/2 UNLESS NOTED
PAINT: ST. OF MR. SPEC'S.
RED LEAD. TT-P-86
APPR. AS NOTED- 9-30-58

STRINGERS	
KENOUSKEAS AVE BRIDGE INTERSTATE #95 BANSOR MAINE	
CUSTOMER	SEABOARD ENG. CO. INC.
DESIGNER	CLARKESON ENG. CO. INC.
ORDER	VERBAL
DWG.	B8-257-53

DRAWN	8-21-58	D.C.
REVISION	9-29-58	D.C.
REVISION	10-22-58	D.C.
REVISION		

SHIP		BILL OF MATERIAL				DWG. NO. B8-257-54	
MARK	NO.	MARK	SHAPE	LENGTH	WT.	WT. DEDUCT.	REMARKS
D1	50		18C-42.7	6 11 ³ / ₈ "		1.7 ²	
D2	32		15C-33.9	7 11 ³ / ₈ "		1.59 ²	
D3	28		4WF13	7 3 ¹ / ₄ "			
	56		6x6x2 1/4	0 2			
FIELD	328		3" BOLTS	0 2			

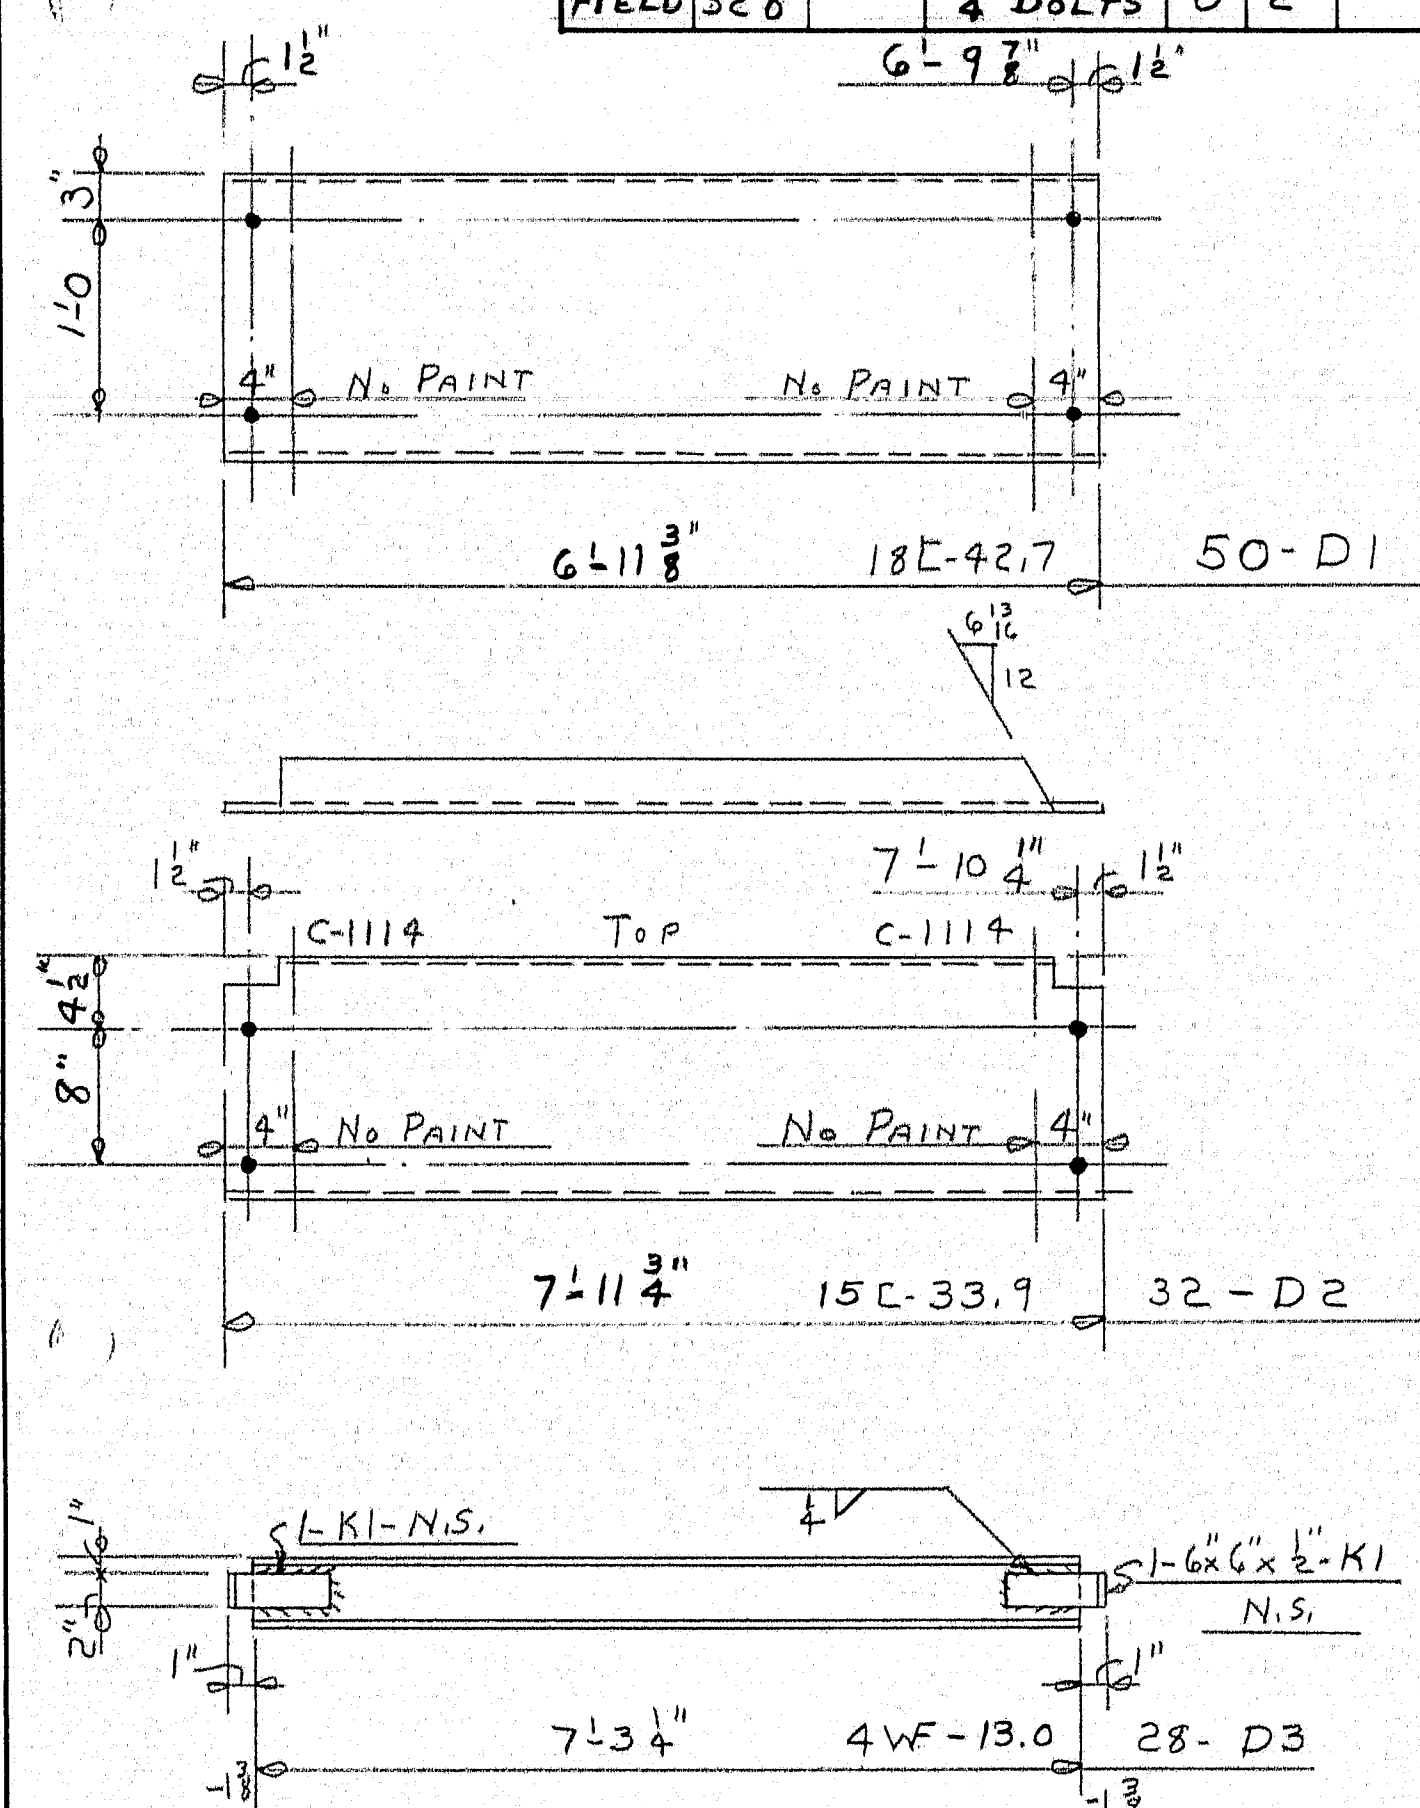

APPR. 9-30-58

DIAPHRAGMS

Ramcraft & Martin Rolling Mills Company
Brewer, Maine

KENDUSKEAG AVE. BRIDGE
INTERSTATE #95
BANGOR MAINE

CUSTOMER SEABOARD ENG. CO. INC.
DESIGNER CLARKSON ENG. CO. INC.

ORDER NO. VERBAL DWG. NO. B8-257-54


- 4-DIST-3-19-59
- 4-SHOP-10-22-58
- 4-DIST-10-22-58
- 2-F/A-9-29-58
- 2-F/A-9-4-58


SHOP CONN: WELD
FIELD CONN: D_o
HOLES: 1 1/2"

DRAWN	8-21-58	D.C.
REVISION	9-29-58	D.C.
REVISION		
REVISION		

ST. OF M.E. SPEC'S.

77-32

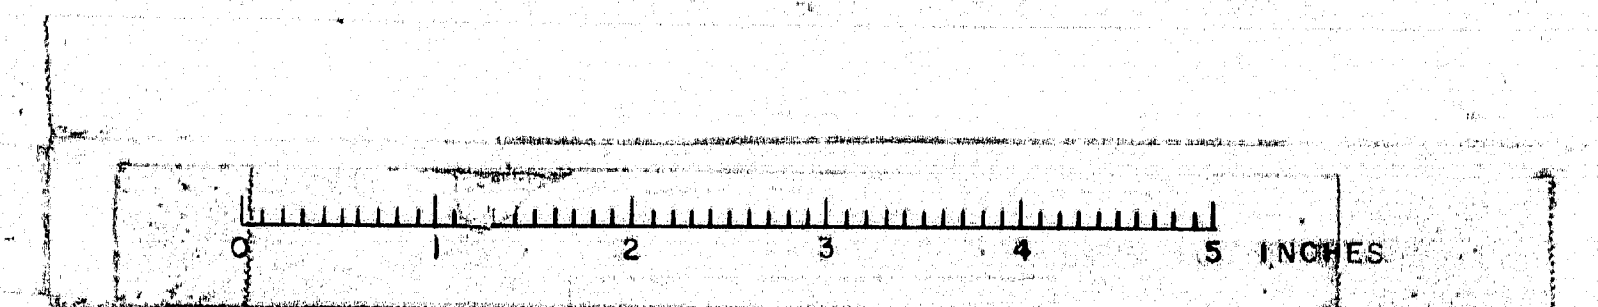

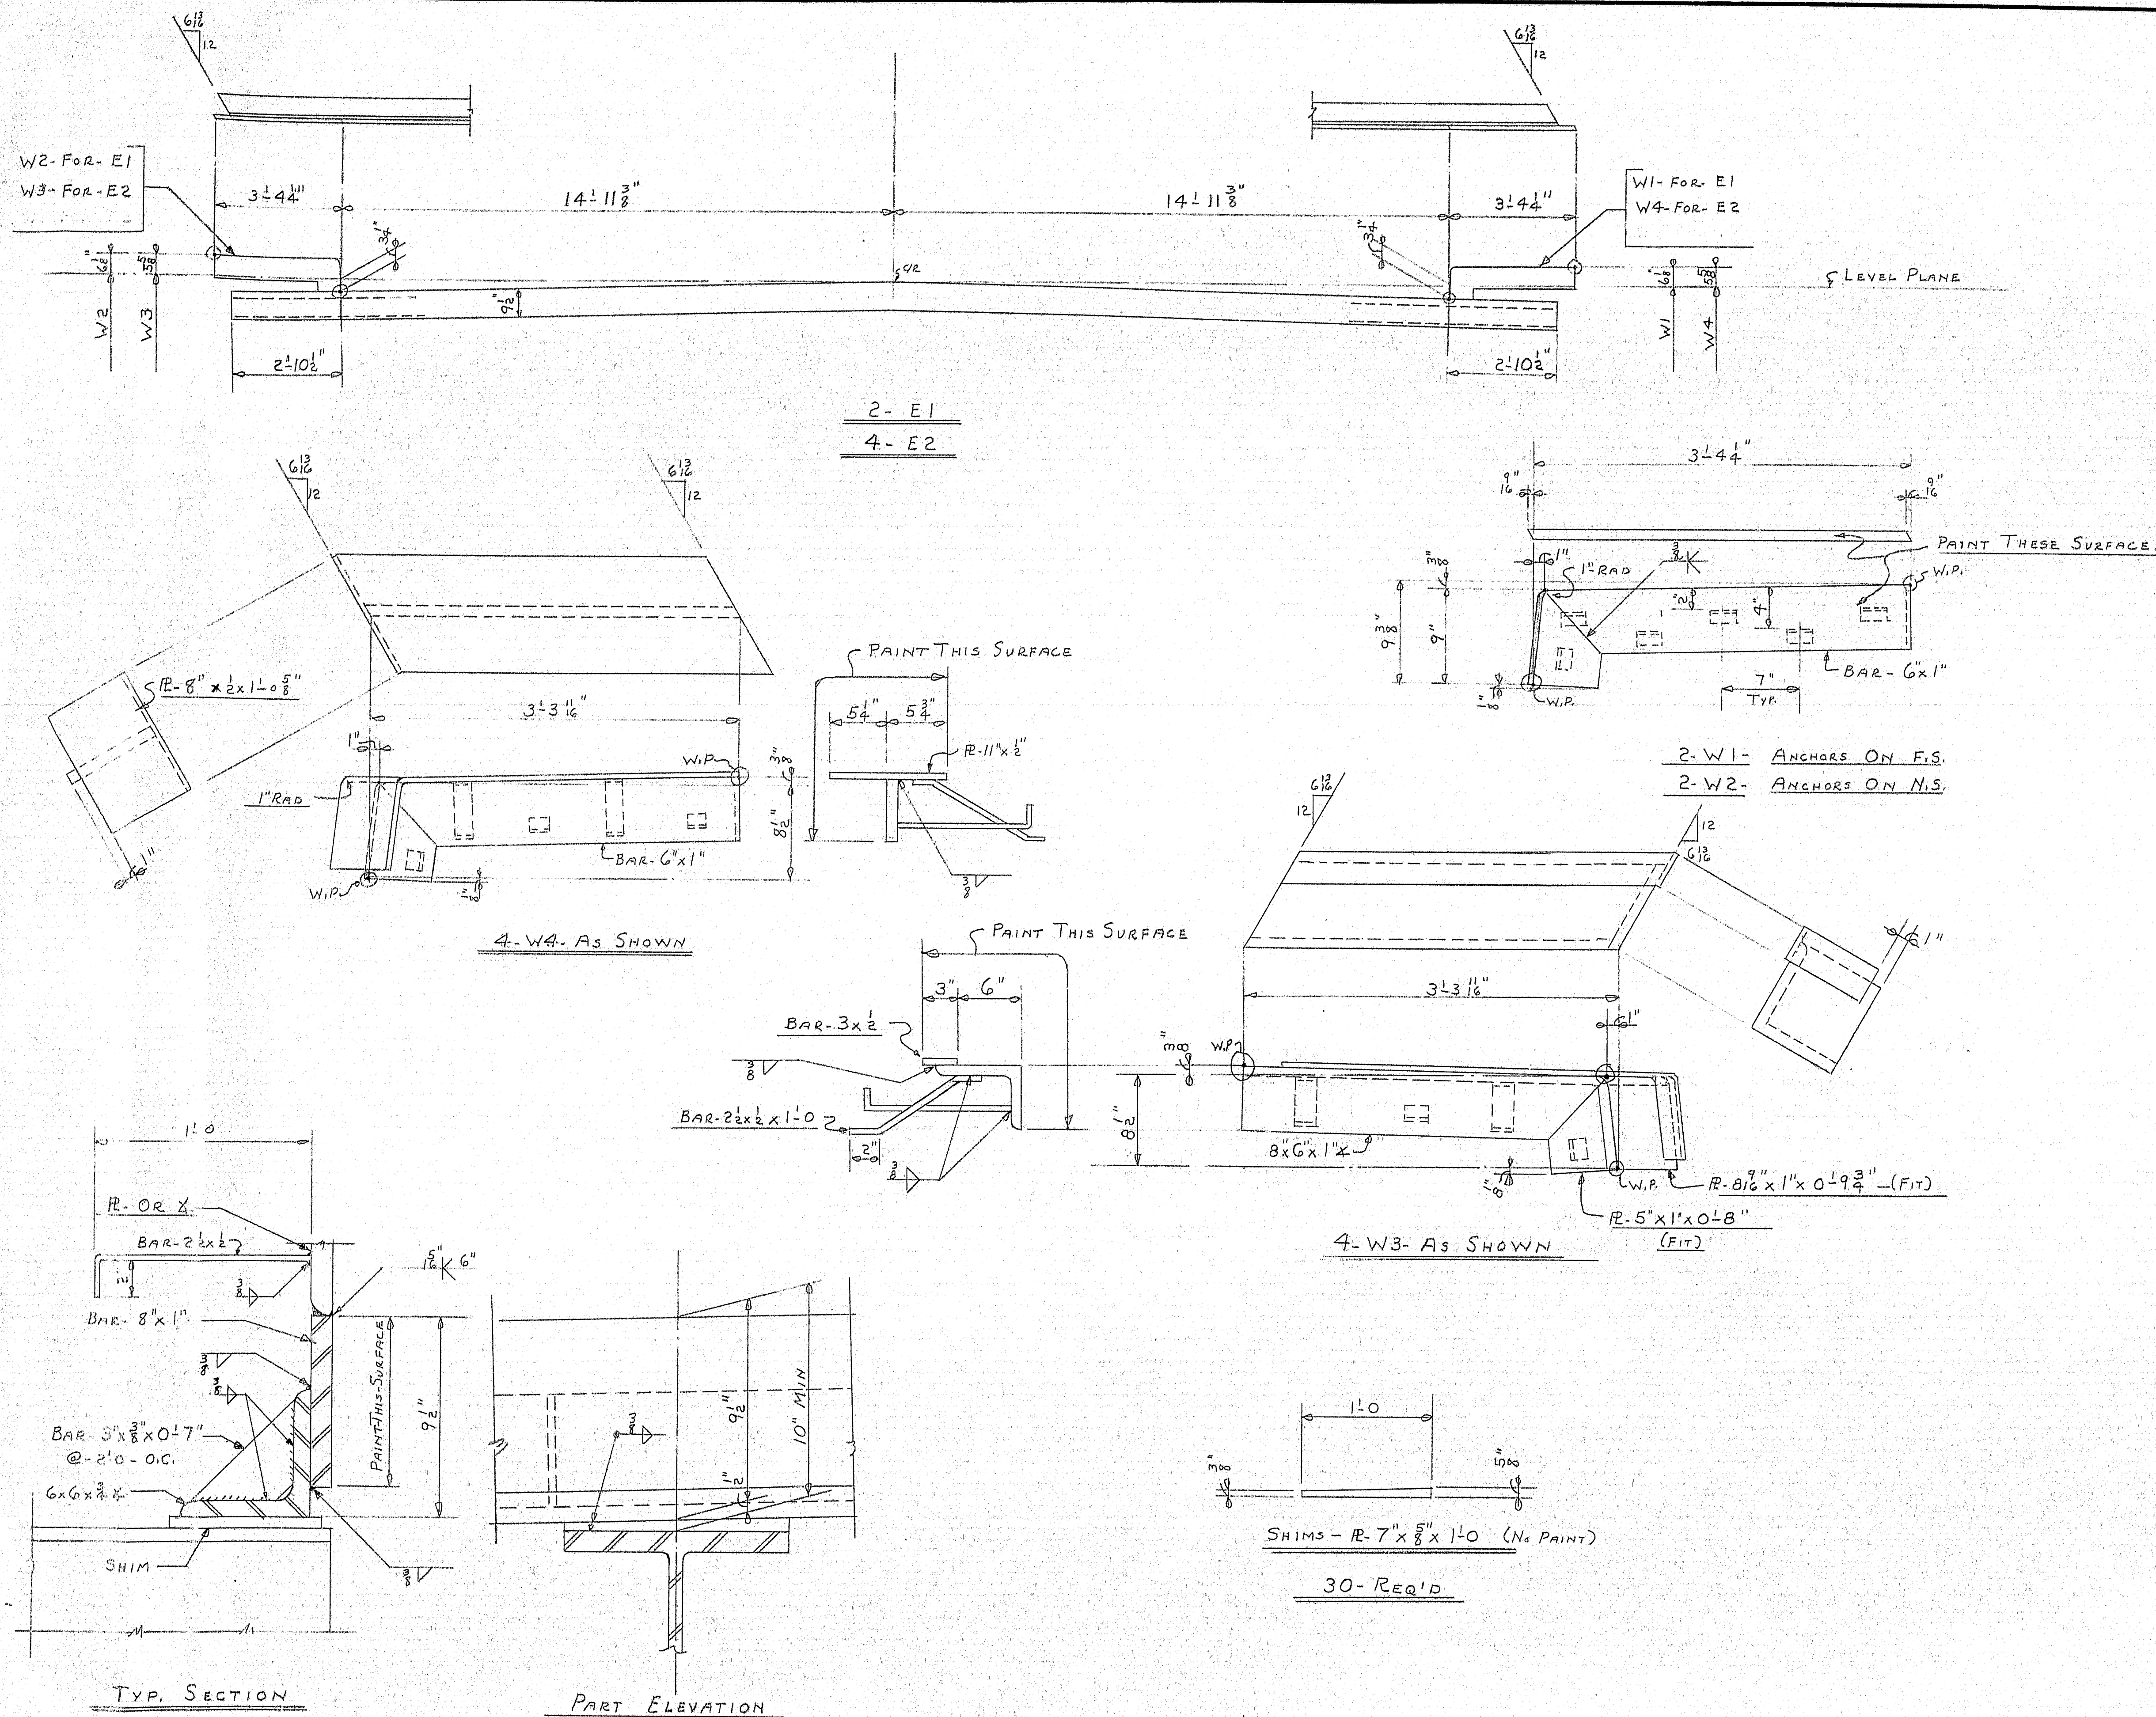

SHIP		BILL OF MATERIAL				DWG. B8-257-55	
MARK	NO.	MARK	SHAPE	LENGTH	WT.	WT. DEDUCT.	REMARKS
E1	2		BAR-8x1	35 8 1/2		4#	
E2	4		D.	35 8 1/2		8#	
	6		6x6x3/4	35 11 1/2		62#	
	96		BAR-3x2	0 7		92#	
	2	W1	BAR-6x1	3 3/4		12 1/2#	
	2	W2	D.	3 3/4		12 1/2#	
	4	W4	D.	3 2 1/4		25#	
	8		D.	0 9		75#	
	4		R-11x1/2	3 9"		41#	
	4		R-8x1/2	1 0 5/8			
	4		8x6x1/4	3 7 1/2		107#	
	4		R-8 1/2x1"	0 9 1/4			
	4		R-5"x1"	0 8		13 1/2#	
	4		BAR-3x2	4 0			
SHIMS	30		R-7x5/8	1 0		89#	
	64		BAR-2 1/2x1/2	1 2			STRAP ANCHORS
	1		3/8" WELD	614 0			@ .50# PER. FT.
	1		1/2" D.	12 0			@ .36# PER. FT.

SHOP CONNECTIONS: WELD
FIELD CONNECTIONS: D.
HOLES:
PAINT: STATE OF ME. SPECS.

APPR. 10-30-58

EXPANSION DAMS

Bancroft & Martin Rolling Mills Company
Brewer, Maine

KENDUSKEAS AVE. BRIDGE
INTERSTATE #95
BANGOR MAINE

CUSTOMER SEABOARD ENG. CO. INC.
DESIGNER CLARKSON ENG. CO. INC.

ORDER VERBAL DWG. B8-257-55

DRAWN	9-9-58	D.C.
REVISION	9-29-58	D.C.
REVISION	12-16-58	D.C.
REVISION		