

1. BEARING WEIGHT INCLUDES MASONRY P.E.
* TOP PLATE BEVEL IN TRANSVERSE DIRECTION. SEE TOP PLATE DETAIL '2' [C]

GENERAL NOTES:

1. ALL STEEL : A588 U.N.O.
2. NEOPRENE : A.A.S.H.T.O. 60 DUROMETER.
3. STAINLESS FACING : 14 GA. A740-TYPE 304 MIRROR FINISH.
4. ROTATION : .86° (.015 RADIAN)
5. MOVEMENT : SEE PLAN.
6. COATING : ZINC METALIZED PER AWS C2.2 WITH 3 MIL EXTERNAL DRY COAT THICKNESS & 2 MIL INTERNAL THICKNESS.
7. X INDICATES THICK EDGE OF TOP PLATE.
8. MAGNETIC PARTICLE TESTING REQUIRED FOR 10% OF WELD LENGTH.
9. BEARINGS TO BE SHOP ASSEMBLED, MATCH MARKED, AND SHIPPED AS A UNIT.
10. UPLIFT RESTRAINTS REQUIRED FOR PIER 2-SPAN 3 BEARINGS ONLY, REFER TO DWG. D-1003-1A FOR DETAILS.
11. FOR PARTS DETAILS REFER TO DWGS. D-1001-1B THRU D-1001-1F
12. ZINC METALIZE ALL SURFACES AS PER NOTE 6 (UNLESS NOTED ON PARTS DWGS. D-1001-1D, E, F) AFTER COMPLETING ALL SHOP WELDING. MASK STAINLESS STEEL & Teflon TO PREVENT OVER SPRAY. A588 STEEL NOT METALIZED TO RECEIVE ONE COAT BOILED UNSEED OIL OR APPROVED EQUAL.

No. <u>Δ</u>	REMOVED SMAW FROM Y&W	12-13-84
No. <u>Δ</u>	REV. DIM. ① ON GEN 1800 DEG	11-14-84
No. <u>Δ</u>	Altered as per 10-11-84 approval	9-28-84 10-11-84
No. <u>Δ</u>	Dimension Changes & Uplift Details	8-6-84 [JF]
No.	REVISION	DATE

HIGH STEEL STRUCTURES, INC.

1905 Old Philadelphia Pike
Lancaster, Pennsylvania 17603
Phone 717/299-5311

A Subsidiary of High Industries, Inc.

STATE OF MAINE - DEPT. OF TRANSPORTATION
I-395 BRIDGE OVER PENOBSCOT RIVER
BANGOR - BREWER PENOBSCOT COUNTY

BEARING DETAILS BY BEARING CORP. INT'L, FAIRFIELD, N.J. JOB # 1177-4




STATE CONTRACT OR REF. NO. 6 CONTRACTOR CIAMBRO CORP.

IN CHARGE: _____ DATE: _____
BY: M. BUTAS CHKD. BY: [Signature] DATE: 6-26-84

CONTRACT ME-84088-123 DRAWING NUMBER D-1001-1A

CODE: 6000

REVE ONE COAT BOILED LINSEED OIL
R95-153

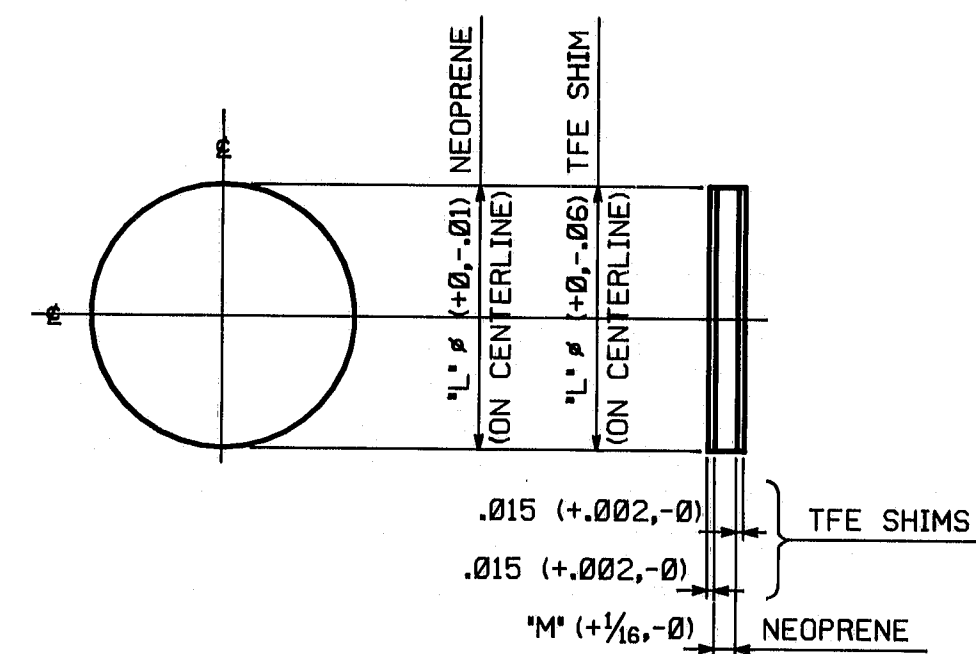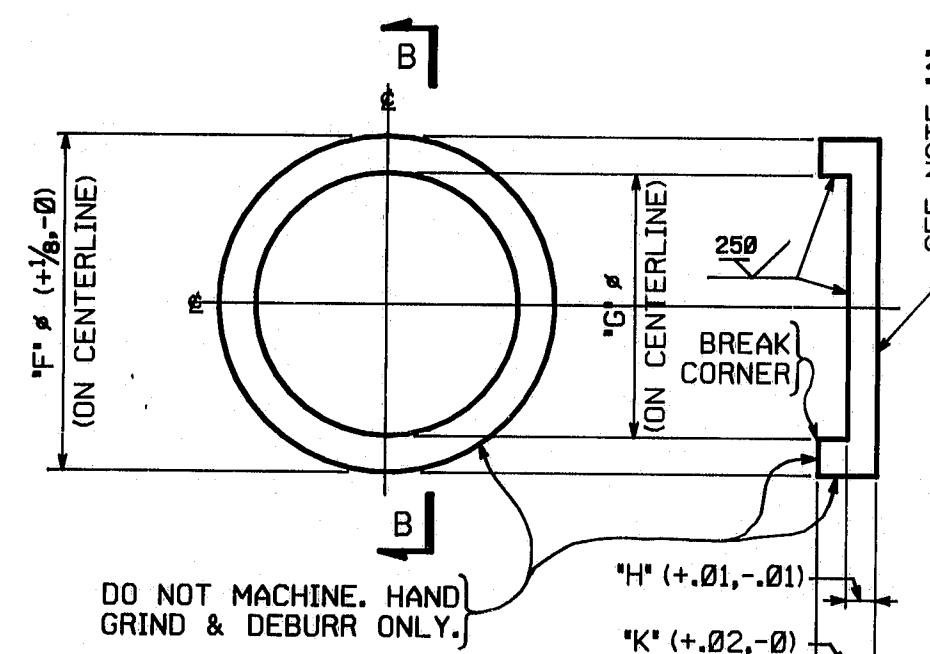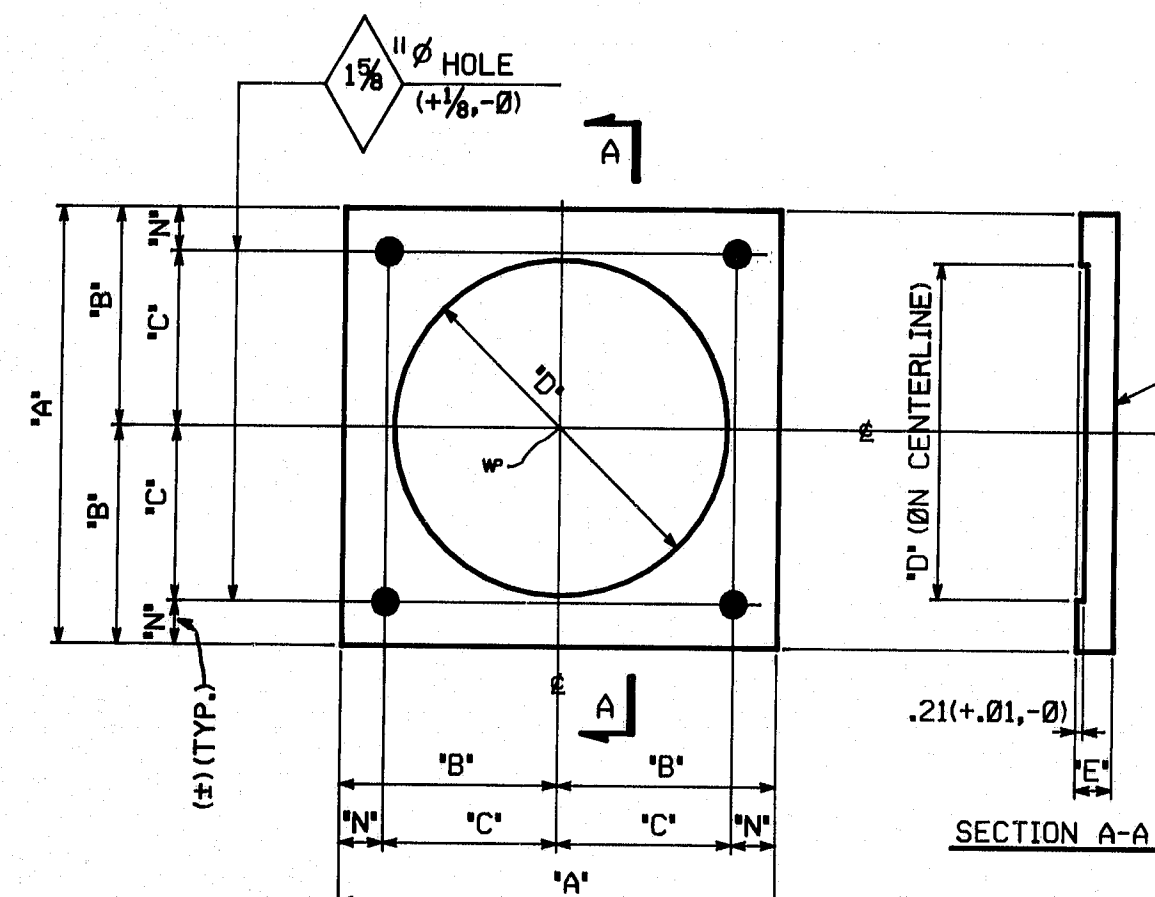

MASONRY PLATES

LOCATION	GIRDER	BRG. TYPE	"A"	"B"	"C"	"D"	"E"	"H"
PIER 2	12.35 6.8,3.18	N-350(2)	1'-10 1/8"	11 1/8"	9 1/8"	1'-2 7/8"	1.46	2 1/4"
SPAN 2	4,7	G-350(2)						
ABUT. 1	12.35 6.8,3.18	N-400(2)						
ABUT. 2	12.35 6.8,3.18	N-400(7)	1'-11 1/2"	11 1/4"	9 1/2"	1'-3 3/4"	1.50	2 1/4"
ABUT. 1	4,7	G-400(2)						
ABUT. 2	4,5	G-400(7)						
PIER 1	4,7	F-900	2'-6 3/4"	1'-3 3/4"	1'-1 1/4"	1'-11"	2.08	2 1/4"
	12.35 6.8,3.18	G-900(2)						
PIER 6	12.35 6.8,3.18	N-1000(3)	2'-7 7/8"	1'-3 15/16"	1'-14 1/8"	2'-0 7/8"	2.18	2 1/4"
	4,5	G-1000(3)						
PIER 5	4,5	F-1100						
	12.35 6.8,3.18	N-1100(5)	2'-9 1/4"	1'-4 1/4"	1'-2 1/4"	2'-1 1/2"	2.27	2 1/4"
PIER 7	4,5	G-1100(5)						
	12.35 6.8,3.18	G-1100(2)						
PIER 5	12.35 6.8,3.18	N-1500(3)	3'-2 3/4"	1'-7 3/4"	1'-4 3/4"	2'-5 3/8"	2.65	3"
PIER 4	4,5	G-1500(3)						
PIER 3	12.35 6.8,3.18	N-1800(7)	3'-6 1/2"	1'-9 1/4"	1'-6 1/4"	2'-8 1/8"	2.86	3"
	4,5	G-1800(7)						
DIMENSION TOLERANCES			+1/8"-0	+1/16"-0	+1/16"-1/8"	+1/32"-0	+0.06"-0	--

BASE PLATES

LOCATION	GIRDER	BRG. TYPE	"F"	"G"	"H"	"K"
PIER 2	12.35 6.8,3.18	N-350(2)	1'-2 3/4"	10.74 (+.008,-0)	1.00	2.49
SPAN 2	4,7	G-350(2)				
ABUT. 1	12.35 6.8,3.18	N-400(2)				
ABUT. 2	12.35 6.8,3.18	N-400(7)	1'-3 3/8"	11.89 (+.009,-0)	1.02	2.53
ABUT. 1	4,7	G-400(2)				
ABUT. 2	4,5	G-400(7)				
PIER 2	12.35 6.8,3.18	N-600(3)	1'-6 1/8"	14.11 (+.010,-0)	1.20	2.93
SPAN 3	4,5	G-600(3)				
PIER 1	4,7	F-900	1'-10 1/8"	18.48 (+.010,-0)	1.50	3.70
	12.35 6.8,3.18	G-900(2)				
PIER 6	12.35 6.8,3.18	N-1000(3)	2'-0"	19.09 (+.012,-0)	1.57	3.80
	4,5	G-1000(3)				
PIER 5	4,5	F-1100				
	12.35 6.8,3.18	N-1100(5)	2'-1 1/8"	20.16 (+.012,-0)	1.71	4.10
PIER 7	4,5	G-1100(5)				
	12.35 6.8,3.18	G-1100(2)				
PIER 5	12.35 6.8,3.18	N-1500(3)	2'-5 1/4"	23.32 (+.012,-0)	1.95	4.56
PIER 4	4,5	G-1500(3)				
PIER 3	12.35 6.8,3.18	N-1800(7)	2'-8"	25.63 (+.012,-0)	2.08	5.00
	4,5	G-1800(7)				

NEOPRENE AND TFE SHIMS

LOCATION	GIRDER	BRG. TYPE	"L"	"M"
PIER 2	12.35 6.8,3.18	N-350(2)	10.74	3/4"
SPAN 2	4,7	G-350(2)		
ABUT. 1	12.35 6.8,3.18	N-400(2)		
ABUT. 2	12.35 6.8,3.18	N-400(7)	11.89	3/4"
ABUT. 1	4,7	G-400(2)		
ABUT. 2	4,5	G-400(7)		
PIER 2	12.35 6.8,3.18	N-600(3)	14.11	1"
SPAN 3	4,5	G-600(3)		
PIER 1	4,7	F-900	18.48	1 1/4"
	12.35 6.8,3.18	G-900(2)		
PIER 6	12.35 6.8,3.18	N-1000(3)	19.09	1 1/4"
	4,5	G-1000(3)		
PIER 5	4,5	F-1100		
	12.35 6.8,3.18	N-1100(5)	20.16	1 3/8"
PIER 7	4,5	G-1100(5)		
	12.35 6.8,3.18	G-1100(2)		
PIER 5	12.35 6.8,3.18	N-1500(3)	23.32	1 1/2"
PIER 4	4,5	G-1500(3)		
PIER 3	12.35 6.8,3.18	N-1800(7)	25.63	1 3/4"
	4,5	G-1800(7)		

REQUIRED PER SHIPMENT		BILL OF MATERIAL		FED. ROAD DIV. NO.		STATE		FED. AID PROJ. NO.	
#1	#2	#3	NO.	BRG. TYPE	DESCRIPTION	LENGTH	REMARKS	ITEM	SHIP. WEIGHT
10	--	--	10	350	22 1/2" x 1.46	1	10 1/2"	1A	10
10	--	8	18	400	23 1/2" x 1.50	1	11 1/2"	1A	9
10	--	--	10	900	30 3/4" x 2.06	2	6 1/2"	1A	7
--	--	8	8	1000	31 1/2" x 2.18	2	7 1/2"	1A	6
--	--	16	16	1100	33 1/4" x 2.27	2	9 1/4"	1A	5
--	8	--	8	1500	38 3/4" x 2.85	3	2 1/2"	1A	4
--	8	--	8	1800	42 1/2" x 2.86	3	6 1/2"	1A	3
BASE PLATES									
10	--	--	10	350	1'-2 3/4" x 2.49" THK.			1A	20
10	--	8	18	400	1'-3 3/8" x 2.53" THK.			1A	19
--	8	--	8	600	1'-6 1/8" x 2.93" THK.			1A	18
10	--	--	10	900	1'-10 1/8" x 3.70" THK.			1A	17
--	--	8	8	1000	2'-0" x 3.80" THK.			1A	16
--	--	16	16	1100	2'-1 1/8" x 4.10" THK.			1A	15
--	8	--	8	1500	2'-5 1/4" x 4.56" THK.			1A	14
--	8	--	8	1800	2'-8" x 5.00" THK.			1A	13
NEOPRENE									
10	--	--	10	350	10.74" x 3/4" THK.		ASHTO GRADE 50 DUROMETER	1D	10
10	--	8	18	400	11.89" x 3/4" THK.		ASHTO GRADE 50 DUROMETER	1D	9
--	8	--	8	600	14.11" x 1" THK.		ASHTO GRADE 50 DUROMETER	1D	8
10	--	--	10	900	18.48" x 1 1/4" THK.		ASHTO GRADE 50 DUROMETER	1D	7
--	--	8	8	1000	19.09" x 1 1/4" THK.		ASHTO GRADE 50 DUROMETER	1D	6
--	--	16	16	1100	20.16" x 1 3/8" THK.		ASHTO GRADE 50 DUROMETER	1D	5
--	8	--	8	1500	23.32" x 1 1/2" THK.		ASHTO GRADE 50 DUROMETER	1D	4
--	8	--	8	1800	25.63" x 1 3/4" THK.		ASHTO GRADE 50 DUROMETER	1D	3
TFE SHIMS									
20	--	--	20	350	10.74" x .015" THK.		VIRGIN CHEMFLUOR T.F.E.	1D	21
20	--	16	36	400	11.89" x .015" THK.		VIRGIN CHEMFLUOR T.F.E.	1D	20
--	16	--	16	600	14.11" x .015" THK.		VIRGIN CHEMFLUOR T.F.E.	1D	19
20	--	--	20	900	18.48" x .015" THK.		VIRGIN CHEMFLUOR T.F.E.	1D	18
--	--	16	16	1000	19.09" x .015" THK.		VIRGIN CHEMFLUOR T.F.E.	1D	17
--	--	32	32	1100	20.16" x .015" THK.		VIRGIN CHEMFLUOR T.F.E.	1D	16
--	16	--	16	1500	23.32" x .015" THK.		VIRGIN CHEMFLUOR T.F.E.	1D	15
--	16	--	16	1800	25.63" x .015" THK.		VIRGIN CHEMFLUOR T.F.E.	1D	14

NOTES:

NOTE "A": SURFACES INDICATED ARE TO BE STRAIGHT AND TRUE; FINISH IF NECESSARY.

ALL DIMENSIONS GIVEN THUS: 1.46 ARE DECIMALS OF AN INCH.

FOR NOTES AND REFERENCE, SEE DRAWING D-1001-1A.

MATERIAL TO BE ASTM A588 (U.N.)

SHOP NOTE


HOLES: AS NOTED

BOLTS: NONE

R95-154


NO. 1	REVISION	REV. DATE	DATE 11-14-84
NO. 1	REVISION	DATE 9-28-84	DATE 11-14-84
HIGH STEEL STRUCTURES, INC. 1905 Old Philadelphia Pike Lancaster, Pennsylvania 17603 Phone 717/299-528 A Subsidiary of High Industries, Inc.			
POT BEARING DETAILS I-395 BRIDGE OVER PENOBSCOT RIVER I-395 BRIDGE STA. 164+60.00 PENOBSCOT COUNTY STATE OF MAINE DEPARTMENT OF TRANSPORTATION			
STATE CONTRACT OR REF. NO.	6	CONTRACTOR	CIANBRO CORP.
IN CHARGE	HINKLE	MADE BY	B.J.K.
DATE	7-2-84	DATE	7-2-84
CONTRACT NUMBER	ME-84088-1,2,3	DRAWING NUMBER	D-1001-1B

DETAIL 1

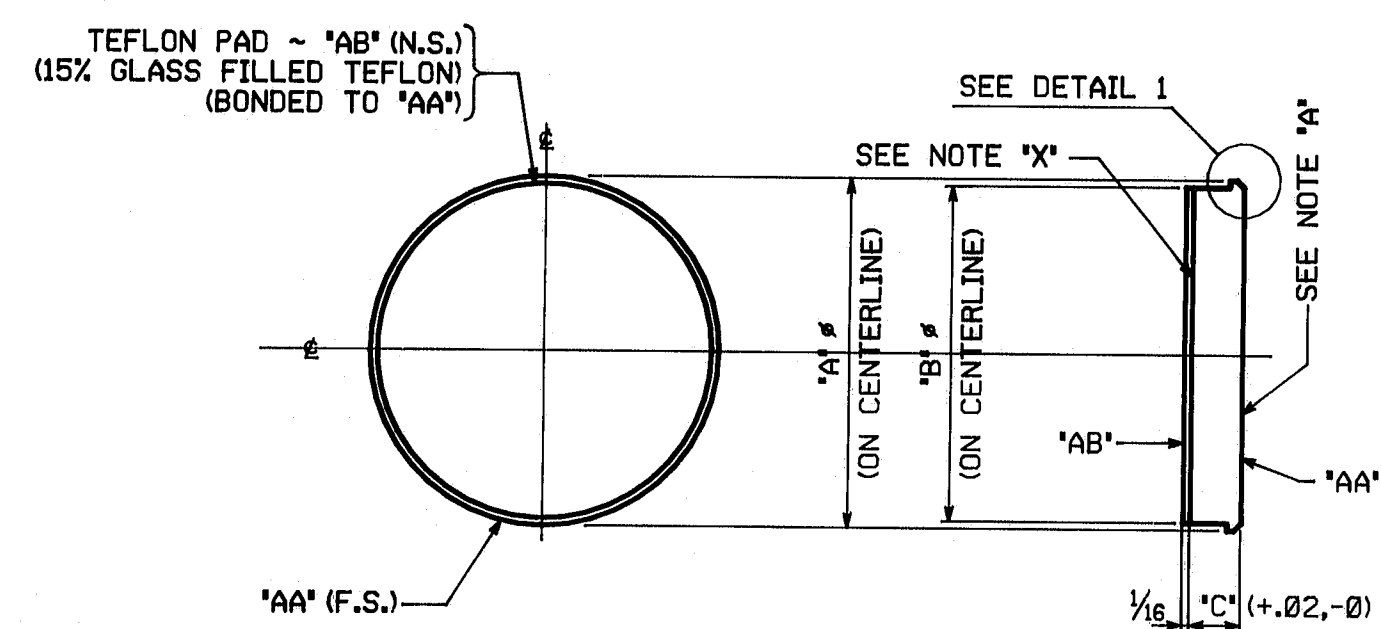


PISTONS - NON GUIDED

LOCATION	GIRDER	BRG. TYPE	'A' Δ	'B' Δ	'C' Δ	'D' Δ	'E' Δ	'F' Δ	'AA' Δ	'AB' Δ
PIER 2 SPAN 2	12.35 6.63.18	N-350(2)	10.72 (+0, -.008)	10.58	1.33	.07	.13	.37	ba	bk
ABUT. 1	12.35 6.63.18	N-400(2)	11.87 (+0, -.009)	11.71	1.36	.08	.13	.37	bb	bm
ABUT. 2	12.35 6.63.18	N-400(7)	11.87 (+0, -.009)	11.71	1.36	.08	.13	.37	bb	bm
PIER 6	12.35 6.63.18	N-600(9)	14.07 (+0, -.010)	13.91	1.46	.08	.14	.37	bc	bn
PIER 7	12.35 6.63.18	N-1000(3)	19.04 (+0, -.012)	18.84	1.77	.10	.18	.50	bd	bp
PIER 4	12.35 6.63.18	N-1500(3)	23.27 (+0, -.012)	23.05	2.04	.11	.24	.56	bg	bt
PIER 3	12.35 6.63.18	N-1800(7)	25.58 (+0, -.012)	25.36	2.14	.11	.27	.56	bh	bw

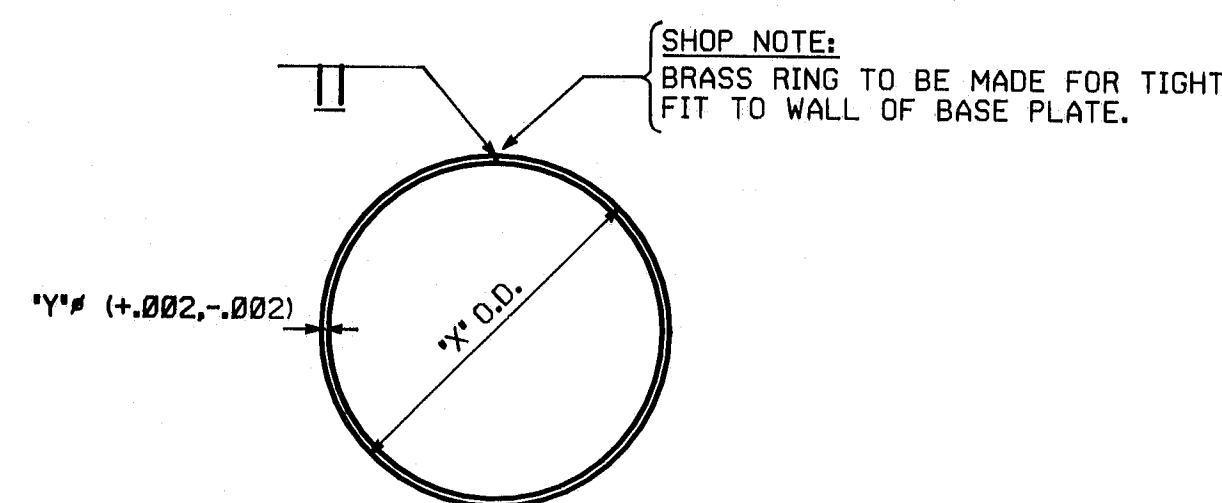


BRASS SEALING RINGS

LOCATION	GIRDER	BRG. TYPE	'X' Δ	'Y' Δ
PIER 2 SPAN 2	12.35 6.63.18	N-350(2)	10.74	5/16
ABUT. 1	12.35 6.63.18	N-400(2)	11.89	5/16
ABUT. 2	12.35 6.63.18	N-400(7)	11.89	5/16
ABUT. 1	12.35 6.63.18	N-400(2)	11.89	5/16
ABUT. 2	12.35 6.63.18	N-400(7)	11.89	5/16
PIER 2 SPAN 3	12.35 6.63.18	N-600(9)	14.11	5/16
PIER 1	12.35 6.63.18	N-900(2)	18.48	3/8
PIER 6	12.35 6.63.18	N-1000(3)	19.09	3/8
PIER 5	12.35 6.63.18	N-1100(5)	20.16	3/8
PIER 7	12.35 6.63.18	N-1100(5)	20.16	3/8
PIER 5	12.35 6.63.18	N-1100(2)	20.16	3/8
PIER 4	12.35 6.63.18	N-1500(3)	23.32	1/2
PIER 3	12.35 6.63.18	N-1800(7)	25.63	1/2

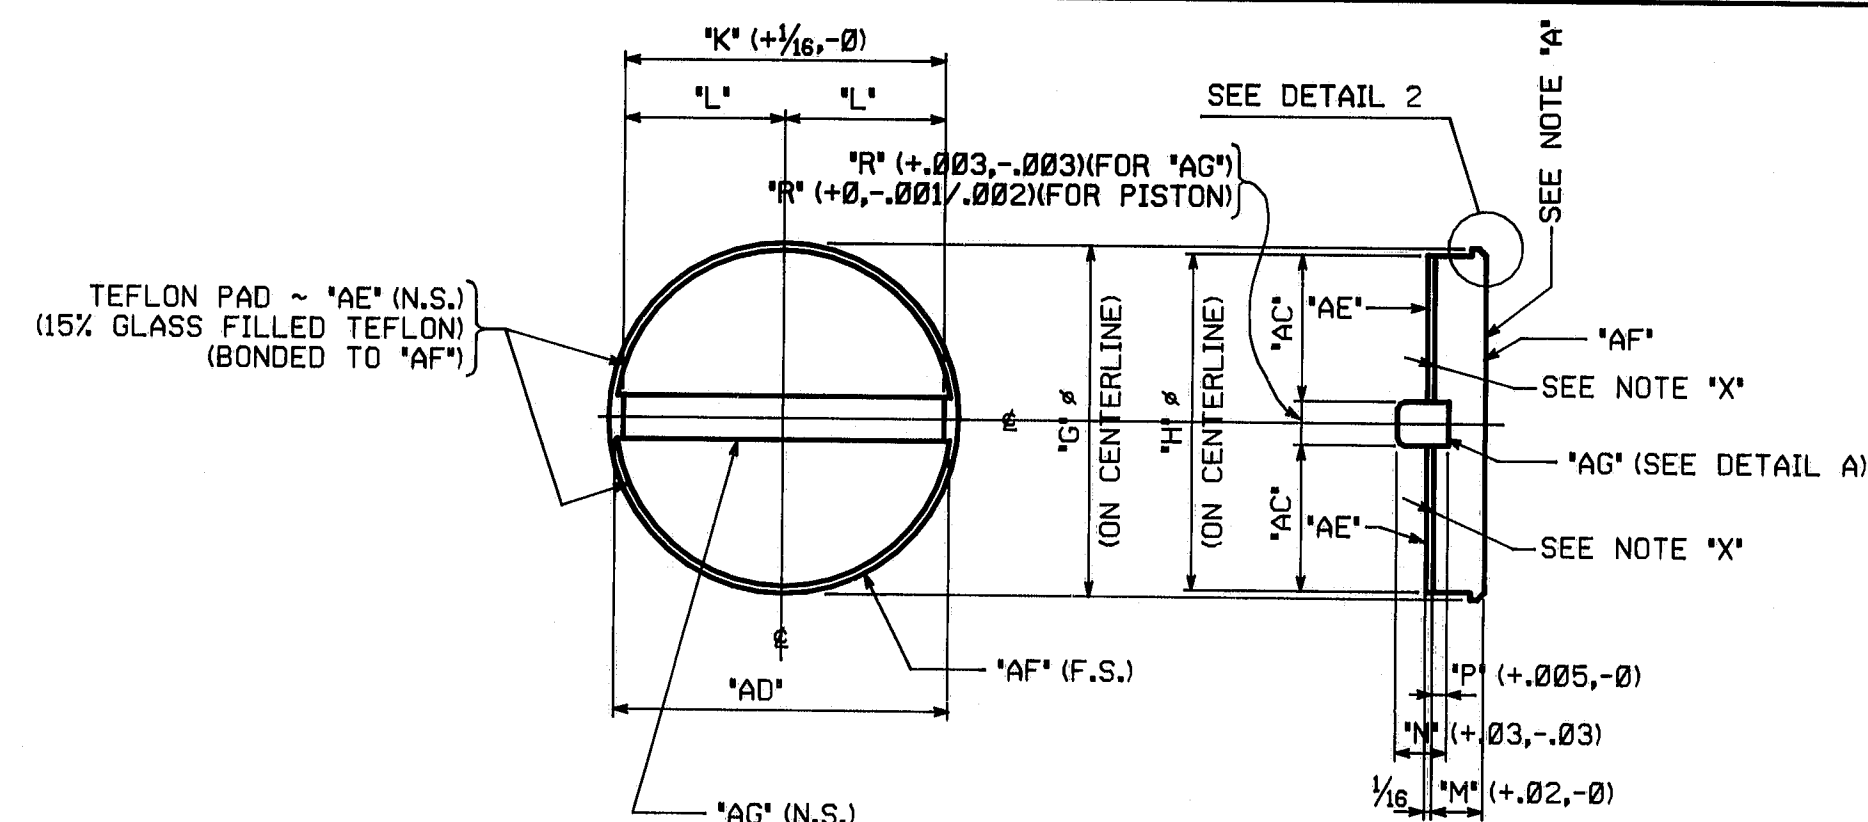


PISTONS - GUIDED


LOCATION	GIRDER	BRG. TYPE	'G' Δ	'H' Δ	'K' Δ	'L' Δ	'M' Δ	'N' Δ	'P' Δ	'R' Δ	'S' Δ	'T' Δ	'U' Δ	'AC' Δ	'AD' Δ	'AE' Δ	'AF' Δ	'AG' Δ
PIER 2 SPAN 2	4,7	G-350(2)	10.72 (+0, -.008)	10.58	10 1/16	5 1/2	1.33	1'	.37	.500	.07	.13	.37	5.04	10.5682	by	bak	bba
ABUT. 1	4,7	G-400(2)	11.87 (+0, -.009)	11.71	11 1/16	5 1/2	1.36	1'	.37	.500	.08	.13	.37	5.605	11.6993	baa	bam	bbb
ABUT. 2	4,5	G-400(7)	11.87 (+0, -.009)	11.71	11 1/16	5 1/2	1.36	1'	.37	.500	.08	.13	.37	5.605	11.6993	baa	bam	bbb
PIER 1	12.35 6.63.18	G-900(2)	18.43 (+0, -.010)	18.25	1'-5 1/8	8 1/16	1.73	1 1/4	.45	.750	.09	.17	.50	8.75	18.2346	bac	bap	bba
PIER 6	12.35 6.63.18	G-1000(3)	19.04 (+0, -.012)	18.84	1'-6 1/4	9 1/16	1.77	1 1/4	.45	.750	.10	.18	.50	9.045	18.8251	bad	bas	bbf
PIER 7	12.35 6.63.18	G-1100(5)	20.11 (+0, -.012)	19.91	1'-7 3/16	9 1/16	1.83	1 1/2	.55	1.000	.10	.21	.50	9.455	19.8849	baf	bat	bbg
PIER 5	12.35 6.63.18	G-1100(2)	20.11 (+0, -.012)	19.91	1'-7 3/16	9 1/16	1.83	1 1/2	.55	1.000	.10	.21	.50	9.455	19.8849	baf	bat	bbg
PIER 4	12.35 6.63.18	G-1500(3)	23.27 (+0, -.012)	23.05	1'-10 1/16	11 1/32	2.04	1 1/2	.55	1.000	.11	.24	.56	11.025	23.0283	bog	baw	bhh
PIER 3	12.35 6.63.18	G-1800(7)	25.58 (+0, -.012)	25.36	2'-0 3/4	1'-0 3/8	2.14	1 3/4	.68	1.000	.11	.27	.56	12.18	25.3403	bah	bay	bbk

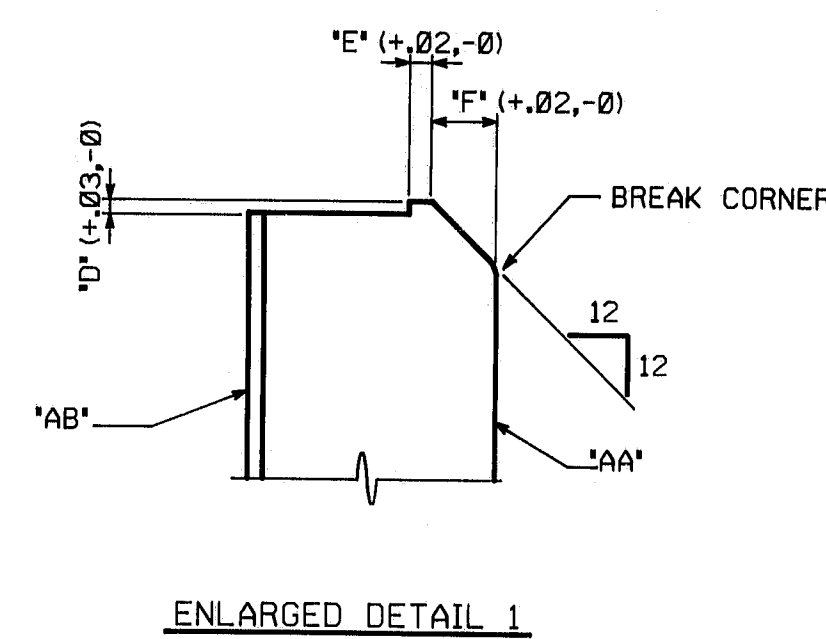

ENLARGED DETAIL 1

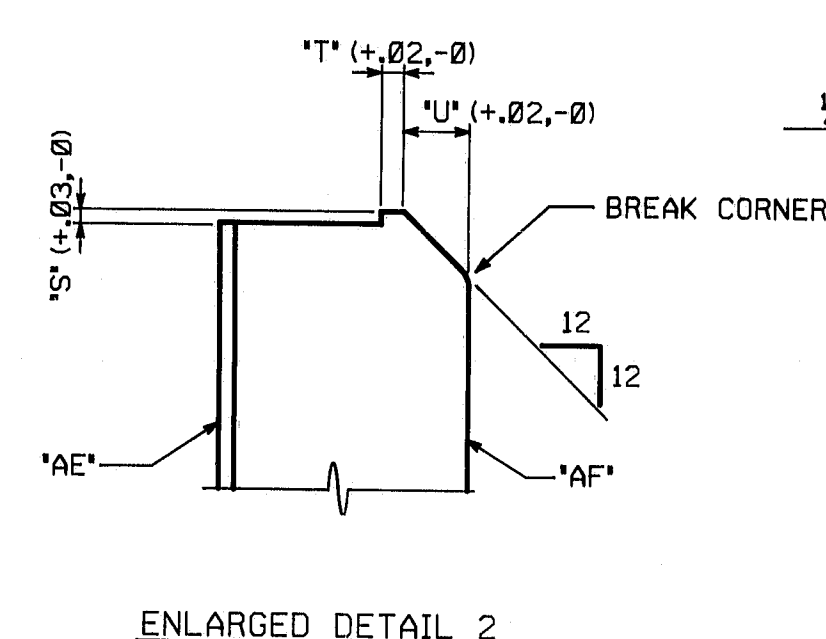

ENLARGED DETAIL 2

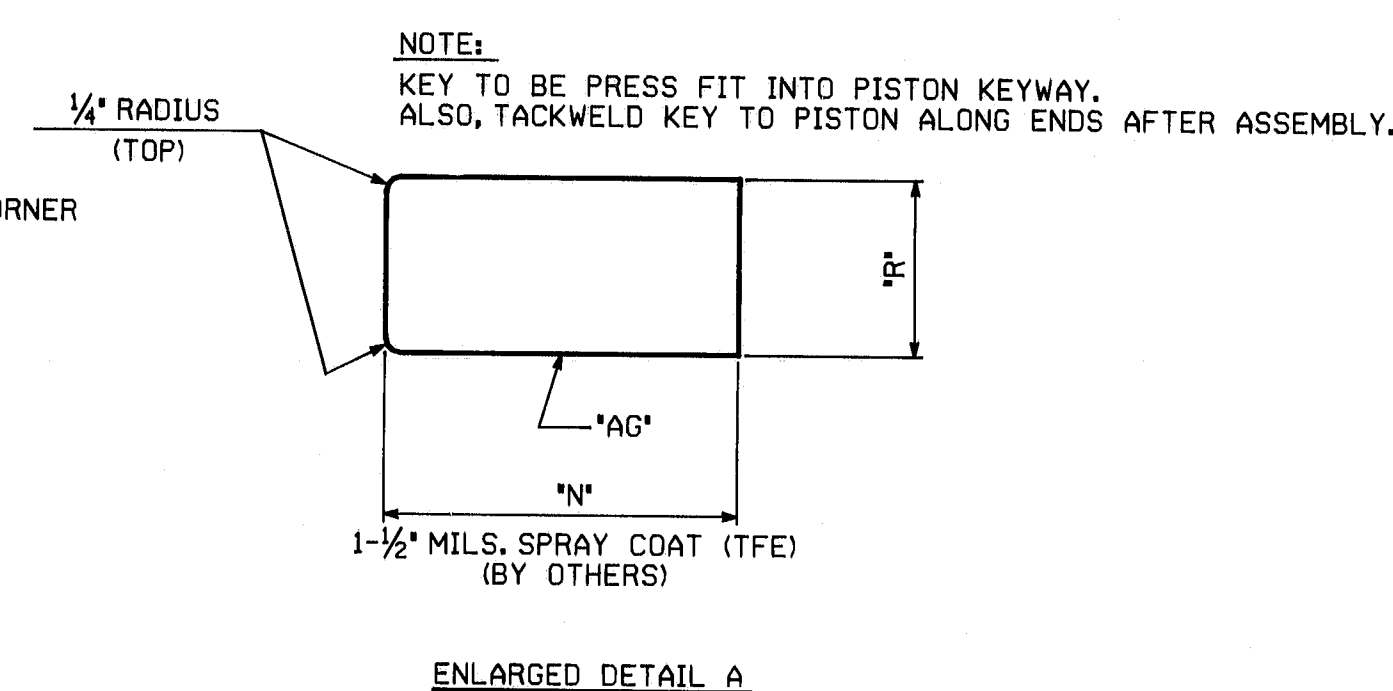

ENLARGED DETAIL A

NOTES:

NOTE 'A': SURFACES INDICATED ARE TO BE STRAIGHT AND TRUE; FINISH IF NECESSARY.

NOTE 'X': SURFACES INDICATED ARE TO BE MACHINED FLAT TO .01'/.04' MAXIMUM

ALL DIMENSIONS GIVEN THUS: 12.21 ARE DECIMALS OF AN INCH. FOR NOTES AND REFERENCE, SEE DRAWING D-1001-1A. MATERIAL TO BE ASTM A588 (U.N.)

SHOP NOTE

HOLES: NONE
BOLTS: NONE

REQUIRED PER SHIPMENT		
#1	#2	#3
10	--	--
10	--	8
--	8	--
10	--	--
--	--	8
--	--	16
--	8	--
--	8	--

BILL OF MATERIAL

REQUIRED PER SHIPMENT		
#1	#2	#3
8	--	--
8	--	6
--	6	--
--	--	6
--	--	6
--	6	--
--	6	--
8	--	--

BILL OF MATERIAL


PER SHIPMENT			DESCRIPTION OF MATERIAL					ITEM	SHIP WEIGHT KG.
NO.	MARK	DESCRIPTION	LENGTH	REMARKS					
#1	#2	#3							
PISTONS-NON-GUIDED									
8	--	--	8	ba	10.72" x 1.33" THK.	FOR BRG. TYPE 350	1A	30	
8	--	--	6	bb	11.87" x 1.36" THK.	FOR BRG. TYPE 400	1A	29	
--	--	--	6	bc	14.07" x 1.46" THK.	FOR BRG. TYPE 600	1A	28	
--	--	--	6	bd	19.04" x 1.77" THK.	FOR BRG. TYPE 1000	1A	26	
--	--	--	6	bf	20.11" x 1.83" THK.	FOR BRG. TYPE 1100	1A	25	
--	--	--	6	bg	23.27" x 2.04" THK.	FOR BRG. TYPE 1500	1A	24	
--	--	--	6	bh	25.58" x 2.14" THK.	FOR BRG. TYPE 1800	1A	23	
8	--	--	8	bk	PAD 10.58" x 1/8" THK.	ISOGLOSS FILL TEFLON FOR BRG. TYPE 350	1E	9	
--	--	--	6	bl	PAD 11.71" x 1/8" THK.	ISOGLOSS FILL TEFLON FOR BRG. TYPE 400	1E	8	
--	--	--	6	bn	PAD 13.91" x 1/8" THK.	ISOGLOSS FILL TEFLON FOR BRG. TYPE 600	1E	7	
--	--	--	6	bp	PAD 18.84" x 1/8" THK.	ISOGLOSS FILL TEFLON FOR BRG. TYPE 1000	1E	6	
--	--	--	6	bs	PAD 19.91" x 1/8" THK.	ISOGLOSS FILL TEFLON FOR BRG. TYPE 1100	1E	5	
--	--	--	6	bt	PAD 23.05" x 1/8" THK.	ISOGLOSS FILL TEFLON FOR BRG. TYPE 1500	1E	4	
--	--	--	6	bw	PAD 25.36" x 1/8" THK.	ISOGLOSS FILL TEFLON FOR BRG. TYPE 1800	1E	3	
PISTONS-GUIDED									
2	--	--	2	bak	10.72" x 1.33" THK.	FOR BRG. TYPE 350	1A	30	
--	--	--	2	bam	11.87" x 1.36" THK.	FOR BRG. TYPE 400	1A	29	
--	--	--	2	ban	14.07" x 1.46" THK.	FOR BRG. TYPE 600	1A	28	
8	--	--	8	bap	18.43" x 1.73" THK.	FOR BRG. TYPE 900	1A	27	
--	--	--	2	bas	19.04" x 1.77" THK.	FOR BRG. TYPE 1000	1A	26	
--	--	--	8	bat	20.11" x 1.83" THK.	FOR BRG. TYPE 1100	1A	25	
--	--	--	2	baw	23.27" x 2.04" THK.	FOR BRG. TYPE 1500	1A	24	
--	--	--	2	bay	25.58" x 2.14" THK.	FOR BRG. TYPE 1800	1A	23	
2	--	--	2	bba	BAR 1' x .5 0 10/16	FOR BRG. TYPE 350 COLD DRAWN (C1018)	1B	30	
--	--	--	2	bbb	BAR 1' x .5 0 1 1/16	FOR BRG. TYPE 400 COLD DRAWN (C1018)	1B	29	
--	--	--	2	bbc	BAR 1 1/4 x .75 1 15/16	FOR BRG. TYPE 600 COLD DRAWN (C1018)	1B	8	
8	--	--	8	bbd	BAR 1 1/4 x .75 1 5/8	FOR BRG. TYPE 900 COLD DRAWN (C1018)	1B	7	
--	--	--	2	bbf	BAR 1 1/4 x .75 1 6/16	FOR BRG. TYPE 1000 COLD DRAWN (C1018)	1B	6	
--	--	--	8	bbg	BAR 1 1/2 x 1' 1 7/16	FOR BRG. TYPE 1100 COLD DRAWN (C1018)	1B	5	
--	--	--	2	bbh	BAR 1 1/2 x 1' 1 10/16	FOR BRG. TYPE 1500 COLD DRAWN (C1018)	1B	4	
--	--	--	2	bbk	BAR 1 3/4 x 1' 2 0/16	FOR BRG. TYPE 1800 COLD DRAWN (C1018)	1B	3	
4	--	--	4	bu	PAD 5.0405"x10.5682	ISOGLOSS FILL TEFLON FOR BRG. TYPE 350	1E	18	
4	--	--	4	baa	PAD 5.6055"x11.6993	ISOGLOSS FILL TEFLON FOR BRG. TYPE 400	1E	17	
--	--	--	4	bab	PAD 6.5805"x13.8898	ISOGLOSS FILL TEFLON FOR BRG. TYPE 600	1E	16	
16	--	--	16	bac	PAD 8.7555"x18.2346	ISOGLOSS FILL TEFLON FOR BRG. TYPE 900	1E	15	
--	--	--	4	bad	PAD 9.0455"x18.8251	ISOGLOSS FILL TEFLON FOR BRG. TYPE 1000	1E	14	
--	--	--	16	baf	PAD 9.4555"x19.8849	ISOGLOSS FILL TEFLON FOR BRG. TYPE 1100	1E	13	
--	--	--	4	bag	PAD 11.0255"x23.0283	ISOGLOSS FILL TEFLON FOR BRG. TYPE 1500	1E	12	
--	--	--	4	bah	PAD 12.1855"x25.3403	ISOGLOSS FILL TEFLON FOR BRG. TYPE 1800	1E	11	

△

NO. △	REVISION	DATE	9-28-84
HIGH STEEL STRUCTURES, INC.			
POT BEARING DETAILS			
I-395 BRIDGE OVER PENOBSCOT RIVER			
I-395 BRIDGE STA. 164+60.00			
PENOBSCOT COUNTY			
STATE OF MAINE			
DEPARTMENT OF TRANSPORTATION			
STATE CONTRACT OR REF. NO.	6	CONTRACTOR	CIANBRO CORP.
IN CHARGE	HINKLE	MADE BY	B.J.K.
CHK.D. BY	JCH	DATE	7-2-84
CONTRACT NUMBER	ME-84088-1,2,3	DRAWING NUMBER	D-1001-1C


R95-155

CODE:6000

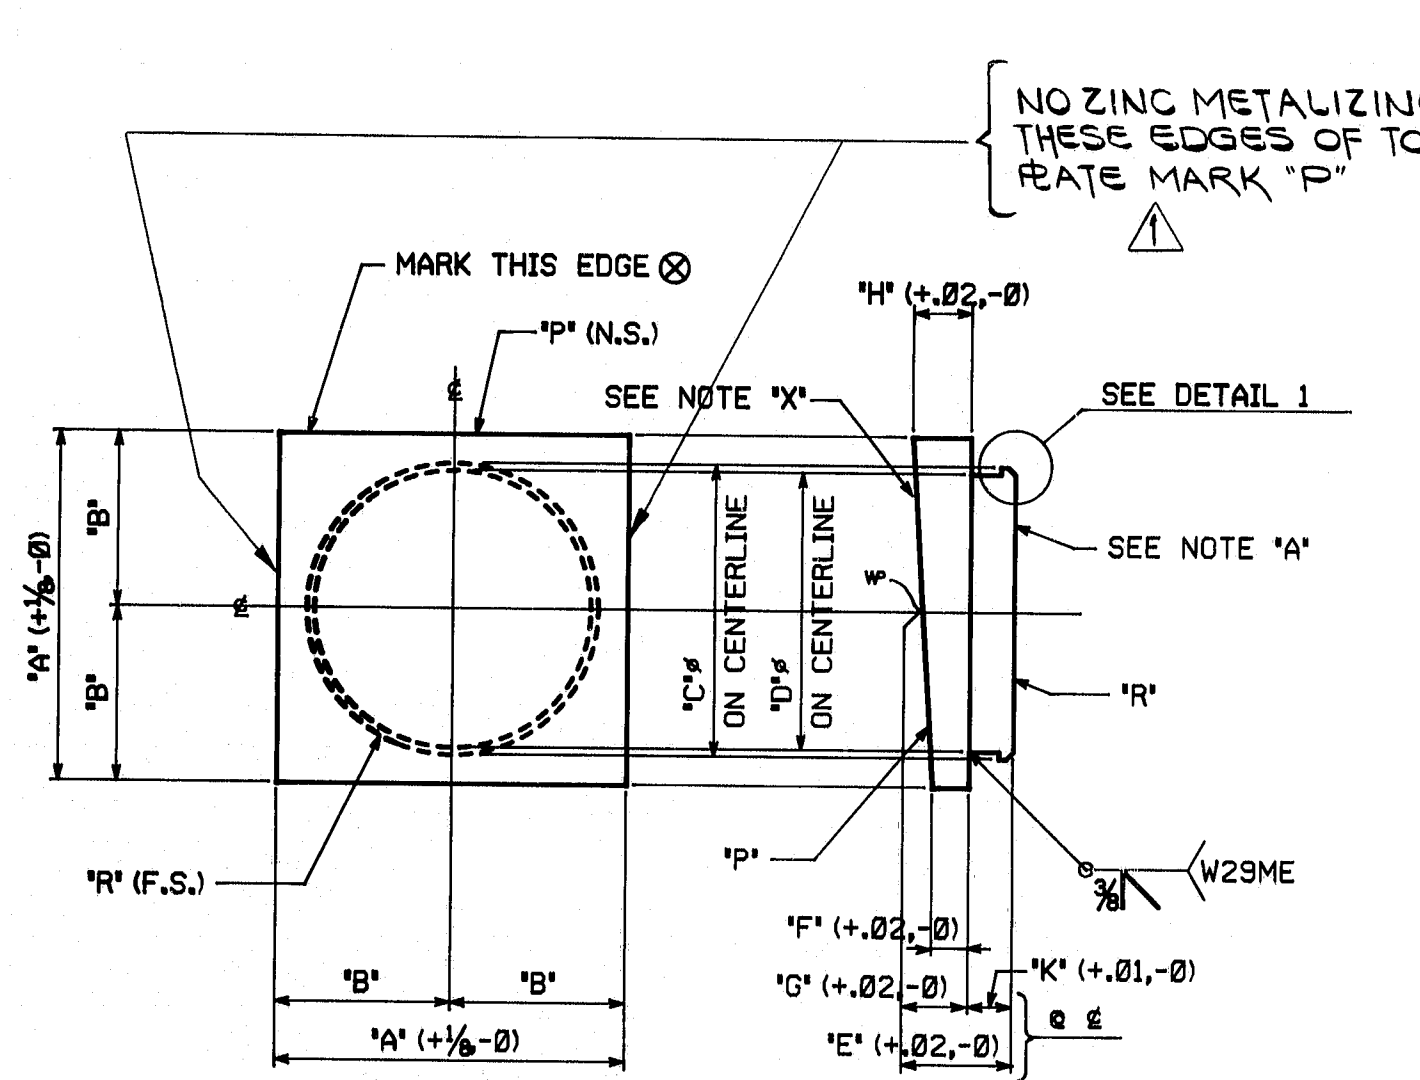


SOLE PLATE/PISTON PLATE - FIXED

LOCATION	GIRDER	BRG. TYPE	'A'	'B'	'C'	'D'	'E'	'F'	'G'	'H'	'I'	'J'	'K'	'L'	'M'	'N'	'O'

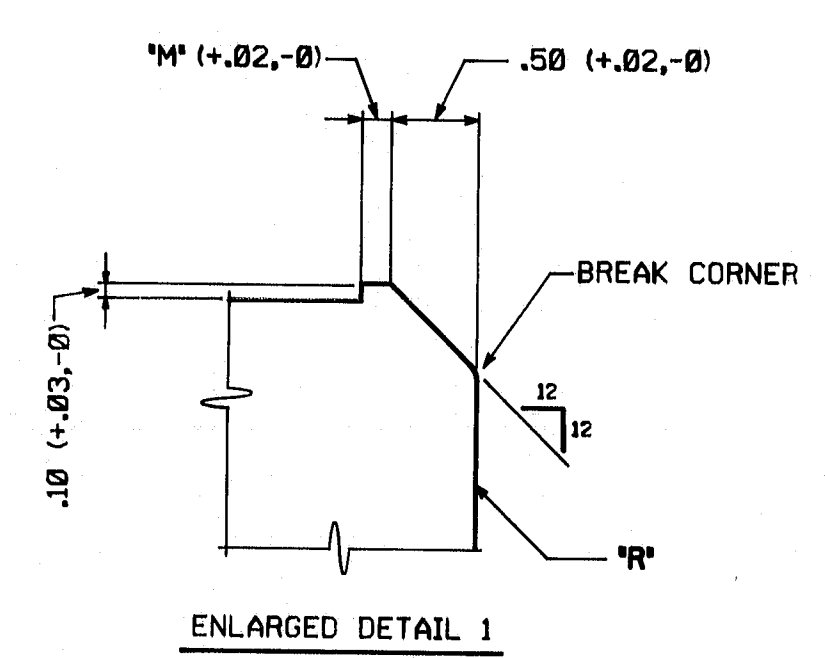

NO ZINC METALIZING THESE EDGES OF TOP PLATE MARK 'AN' FOR ALL BRGS. TYPE 350(2) & 400(2)

NO ZINC METALIZING THESE EDGES OF TOP PLATE MARK 'P' FOR ALL BRGS. TYPE 1500(3); 1800(7) & 400(7)

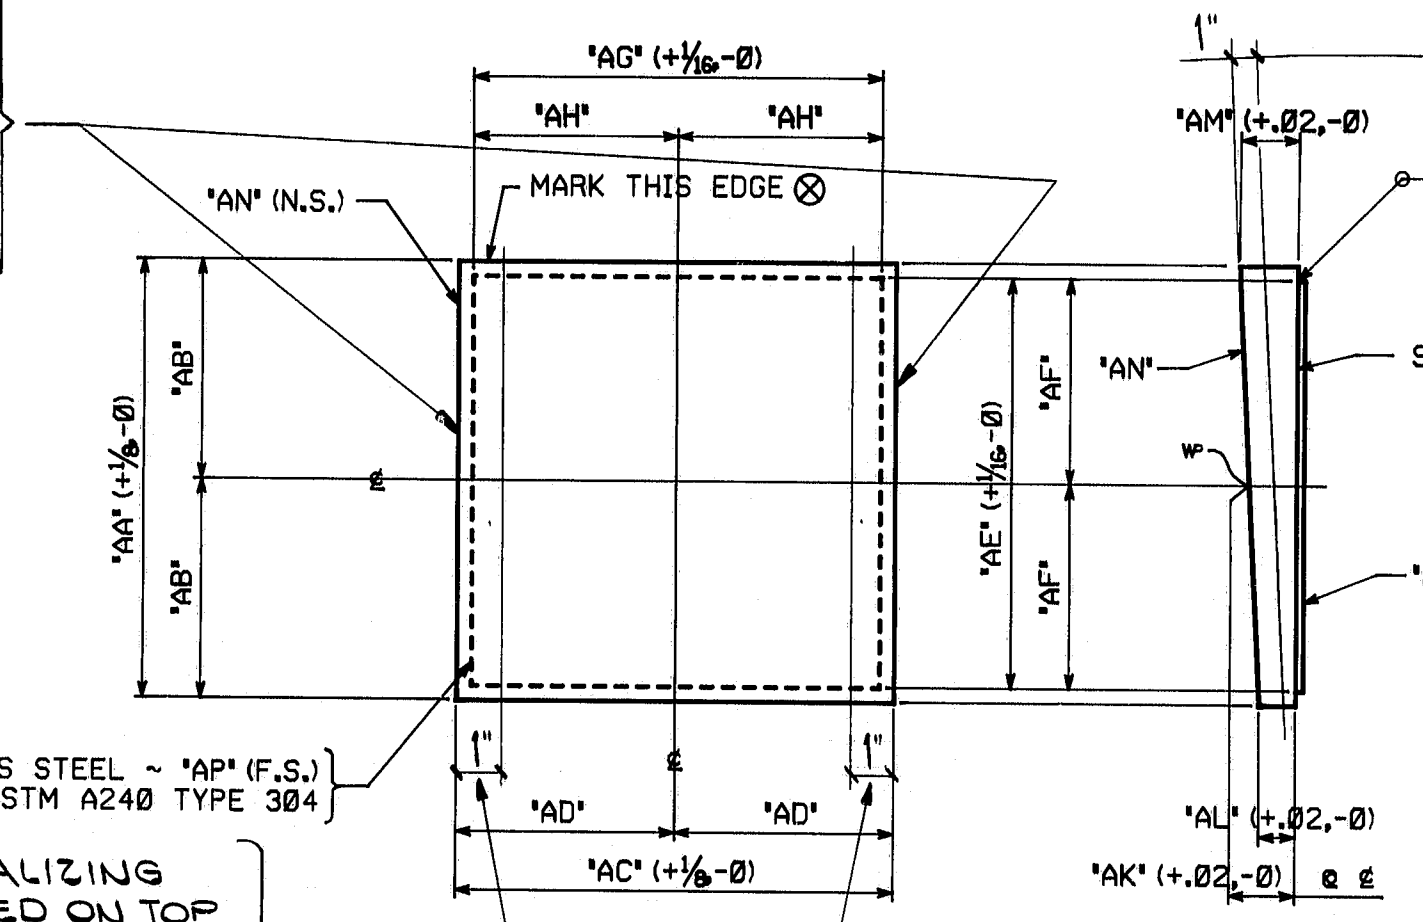

SOLE PLATES - NON GUIDED

LOCATION	GIRDER	BRG. TYPE	'AA'	'AB'	'AC'	'AD'	'AE'	'AF'	'AG'	'AH'	'AI'	'AJ'	'AK'	'AL'	'AM'	'AN'	'AO'

NOTES:

NOTE 'A' SURFACES INDICATED ARE TO BE STRAIGHT AND TRUE; FINISH IF NECESSARY.

NOTE 'X' SURFACES INDICATED ARE TO BE MACHINED FLAT TO .01"/FT. (0.4" MAXIMUM)

ALL DIMENSIONS GIVEN THUS: 2.95 ARE DECIMALS OF AN INCH. FOR NOTES AND REFERENCE, SEE DRAWING D-1001-1A.

MATERIAL TO BE ASTM A588 (U.N.)

SHOP NOTE

HOLES: NONE

BOLTS: NONE

REQUIRED PER SHIPMENT		NO.	MARK	DESCRIPTION	LENGTH	REMARKS	ITEM	QTY
#1	#2	#3						
1	--	1	bbm	222 1/2" x 1.47 x .375	1	10% FOR BRG. TYPE 900	1B	24
1	--	1	bbn	222 1/2" x 1.49 x .351	1	10% FOR BRG. TYPE 900	1B	24
--	2	2	bbp	225 1/2" x 1.48 x 1.04	2	1% FOR BRG. TYPE 1100	1B	27
2	--	2	bbq	218.43 1/2" x 1.73 THK.		FOR BRG. TYPE 900	1A	27
--	2	2	bbt	220.11 1/2" x 1.83 THK.		FOR BRG. TYPE 1100	1A	25
SOLE PLATES - NON GUIDED								
1	--	1	bbw	214 1/2" x 1.46 x 1.04	1	3% FOR BRG. TYPE 350	1B	26
1	--	1	bbx	214 1/2" x 1.45 x 1.05	1	3% FOR BRG. TYPE 350	1B	26
2	--	2	bca	214 1/2" x 1.43 x 1.07	1	3% FOR BRG. TYPE 350	1B	26
4	--	4	ccb	214 1/2" x 1.42 x 1.08	1	3% FOR BRG. TYPE 350	1B	26
1	--	1	bcc	215 1/2" x 1.45 x 1.00	1	4% FOR BRG. TYPE 400	1B	25
2	--	2	bcd	215 1/2" x 1.43 x 1.03	1	4% FOR BRG. TYPE 400	1B	25
1	--	1	bce	215 1/2" x 1.42 x 1.04	1	4% FOR BRG. TYPE 400	1B	25
4	--	4	bcd	215 1/2" x 1.45 x 1.01	1	4% FOR BRG. TYPE 400	1B	25
--	1	1	bch	216 1/2" x 1.36 x 1.36	1	9% FOR BRG. TYPE 400	1B	23
--	5	5	bck	216 1/2" x 1.37 x 1.35	1	9% FOR BRG. TYPE 400	1B	23
--	6	6	bcy	225 1/2" x 2.21 x 1.61	2	1 FOR BRG. TYPE 1000	1B	18
--	4	4	bda	225 1/2" x 2.45 x 1.65	2	4% FOR BRG. TYPE 1100	1B	14
--	2	2	bdb	225 1/2" x 2.46 x 1.64	2	4% FOR BRG. TYPE 1100	1B	14
--	1	1	bdc	229 1/2" x 2.11 x 2.07	2	6 1/2% FOR BRG. TYPE 1500	1B	21
--	2	2	bdd	229 1/2" x 2.09 x 2.09	2	6 1/2% FOR BRG. TYPE 1500	1B	21
--	1	1	bdf	229 1/2" x 2.15 x 2.03	2	6 1/2% FOR BRG. TYPE 1500	1B	21
--	1	1	bdg	229 1/2" x 2.16 x 2.00	2	6 1/2% FOR BRG. TYPE 1500	1B	16
--	1	1	bde	229 1/2" x 2.21 x 1.97	2	6 1/2% FOR BRG. TYPE 1500	1B	16
--	1	1	bdk	233 1/2" x 2.45 x 2.11	3	1 FOR BRG. TYPE 1800	1B	13
--	1	1	bdl	233 1/2" x 2.43 x 2.13	3	1 FOR BRG. TYPE 1800	1B	13
--	1	1	bdl	233 1/2" x 2.41 x 2.15	3	1 FOR BRG. TYPE 1800	1B	13
--	1	1	bdp	233 1/2" x 2.37 x 2.19	3	1 FOR BRG. TYPE 1800	1B	15
--	1	1	bds	233 1/2" x 2.35 x 2.21	3	1 FOR BRG. TYPE 1800	1B	15
--	1	1	bdt	233 1/2" x 2.34 x 2.22	3	1 FOR BRG. TYPE 1800	1B	15
8	--	8	bdw	214 1/2" x 14GA.	1	3 1/2% A240 TYPE 304 FOR BRG. TYPE 350	1C	12
8	--	8	bdu	215 1/2" x 14GA.	1	4% A240 TYPE 304 FOR BRG. TYPE 400	1C	9
--	6	6	bfa	215 1/2" x 14GA.	1	9 1/2% A240 TYPE 304 FOR BRG. TYPE 400	1C	9
--	6	6	bfc	223 1/2" x 14GA.	2	0 1/2% A240 TYPE 304 FOR BRG. TYPE 1000	1C	6
--	6	6	bfd	224 1/2" x 14GA.	2	3% A240 TYPE 304 FOR BRG. TYPE 1100	1C	6
--	6	6	bff	228 1/2" x 14GA.	2	5 1/2% A240 TYPE 304 FOR BRG. TYPE 1500	1C	4
--	6	6	bfg	231 1/2" x 14GA.	3	0 1/2% A240 TYPE 304 FOR BRG. TYPE 1800	1C	3

NO. 1 REVISION altered as per 10-11-84 appv. DATE 10-11-84

805 Old Philadelphia Pike
Lancaster, Pennsylvania 17603
Phone 717/299-3333

A Subsidiary of HSA Industries, Inc.

POT BEARING DETAILS

I-395 BRIDGE OVER PENOBSCOT RIVER

I-395 BRIDGE STA. 164+60.00

PENOBSCOT COUNTY

STATE OF MAINE


DEPARTMENT OF TRANSPORTATION

STATE CONTRACT OR REFUND: 6 CONTRACTOR: CIANBRO CORP.

IN CHARGE: HINKLE MADE BY: B.J.K. CHK'D BY: JCH DATE: 8-16-84


CONTRACT NUMBER: ME-84088-1,2,3 DRAWING NUMBER: D-1001-1D DATE: 7-2-84

R95-156

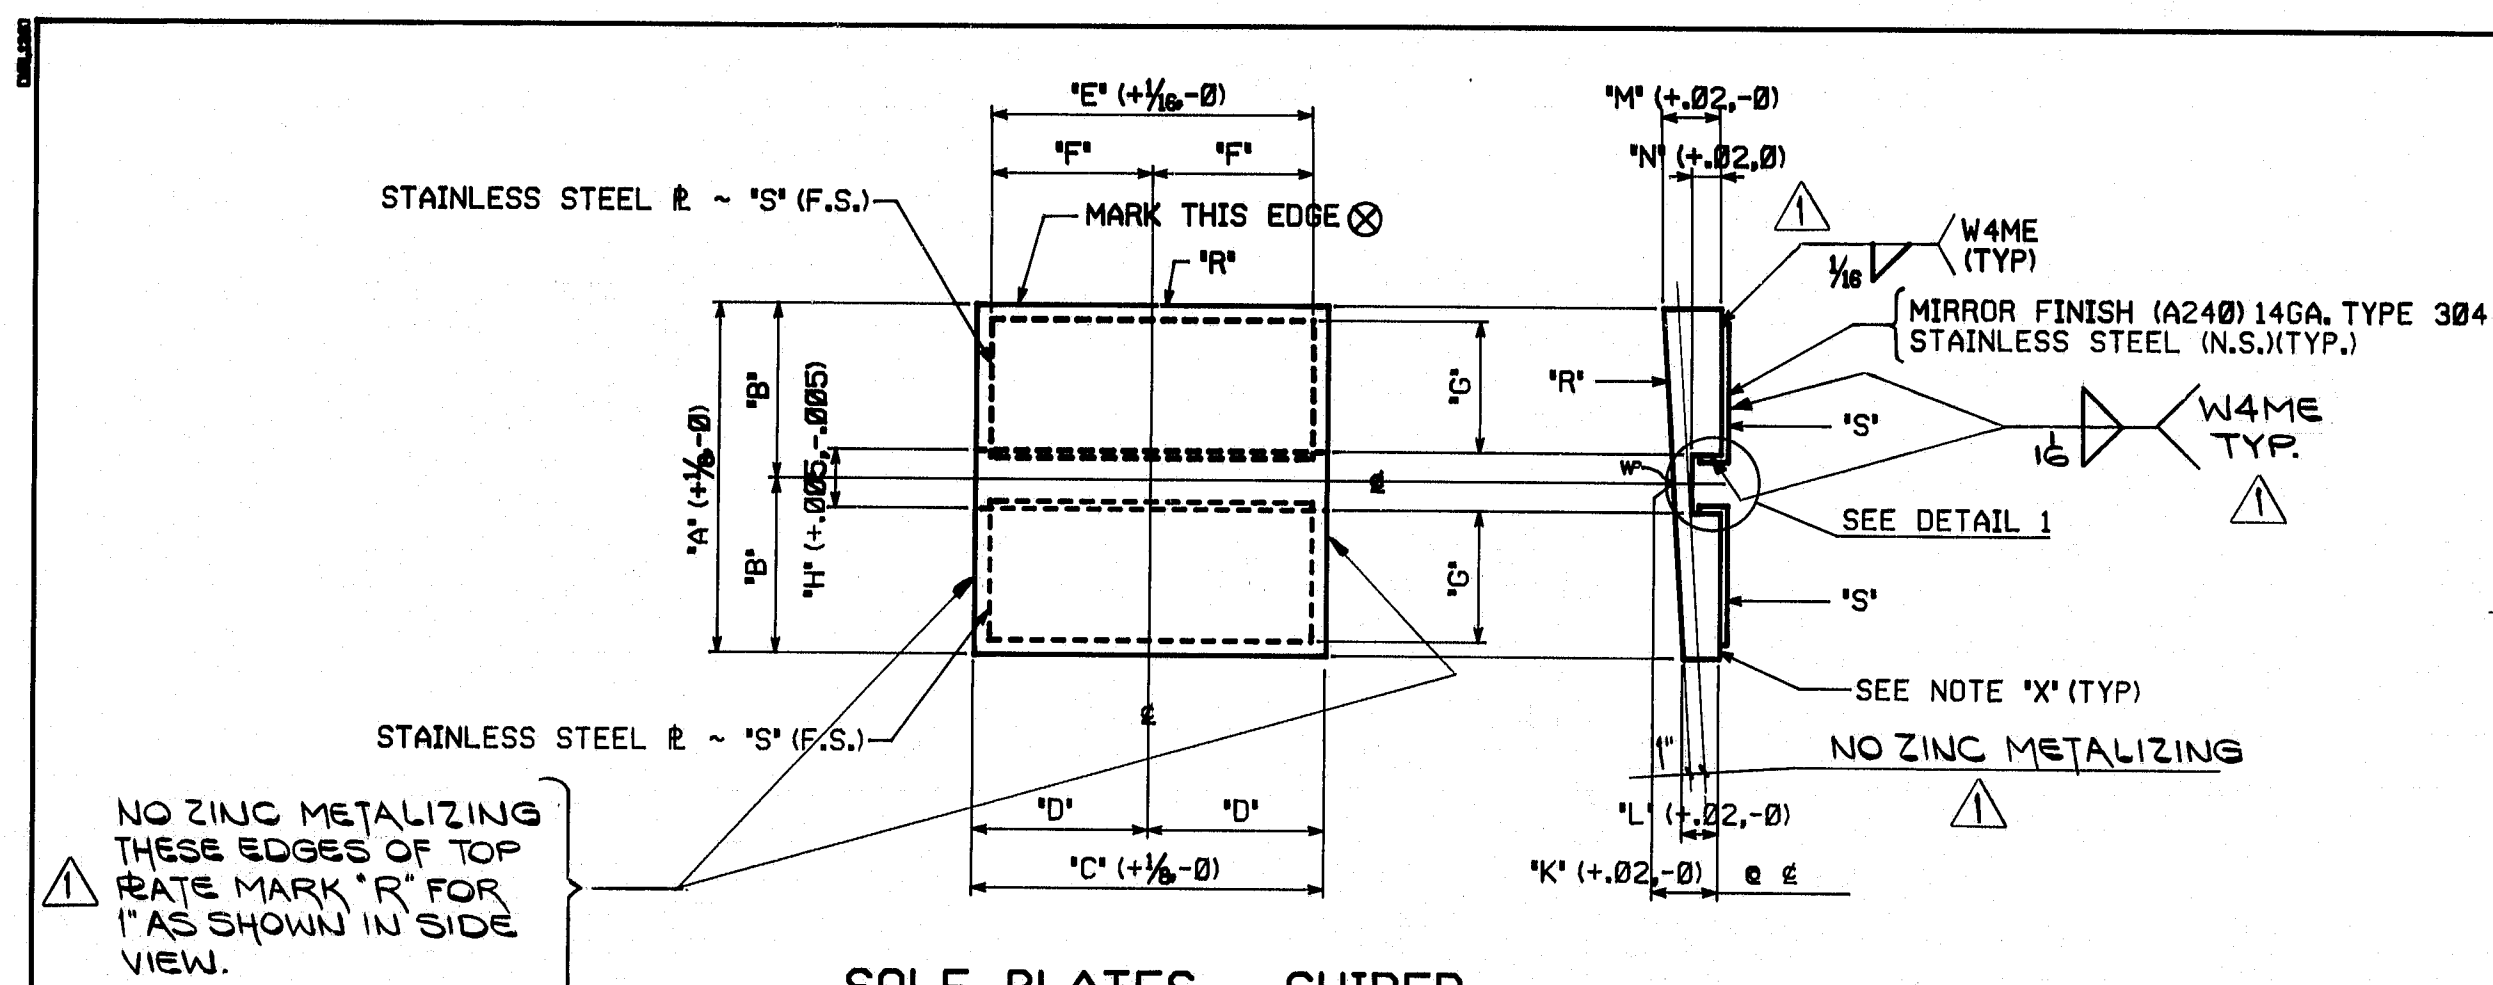



SOLE PLATES - GUIDED

LOCATION	GIRDER	BRG. TYPE	'A'	'B'	'C'	'D'	'E'	'F'	'G'	'H'	'I'	'J'	'K'	'L'	'M'	'N'	'P'	'R'	'S'
PIER 1	1	G-900(2)	1'-10 7/8	11 7/8	1'-11	11 1/2	1'-10 1/2	11 1/4	10 3/4	1.06	1.30	1.59	2.21	.75	%	bgb	bhc		
	2	G-900(2)													1.60	2.20		bgc	
	3,8,9,10	G-900(2)													1.63	2.17		bgd	
	5,6	G-900(2)	1'-10 7/8	11 7/8	1'-11	11 1/2	1'-10 1/2	11 1/4	10 3/4	1.06	1.30	1.61	2.19	.75	%	bgi	bhc		
PIER 5	1,2,3	G-1100(2)	2'-1 3/4	1'-0 1/8	2'-1 3/4	1'-0 1/8	2'-0 7/8	1'-0 7/8	11 1/8	1.31	2.01	1.86	2.16	.93	%	bgi	bhd		
	6	G-1100(2)													1.83	2.19		bgh	
	7	G-1100(2)													1.82	2.20		bgk	
	8	G-1100(2)	2'-1 3/4	1'-0 1/8	2'-1 3/4	1'-0 1/8	2'-0 7/8	1'-0 7/8	11 1/8	1.31	2.01	1.81	2.21	.93	%	bgm	bhd		

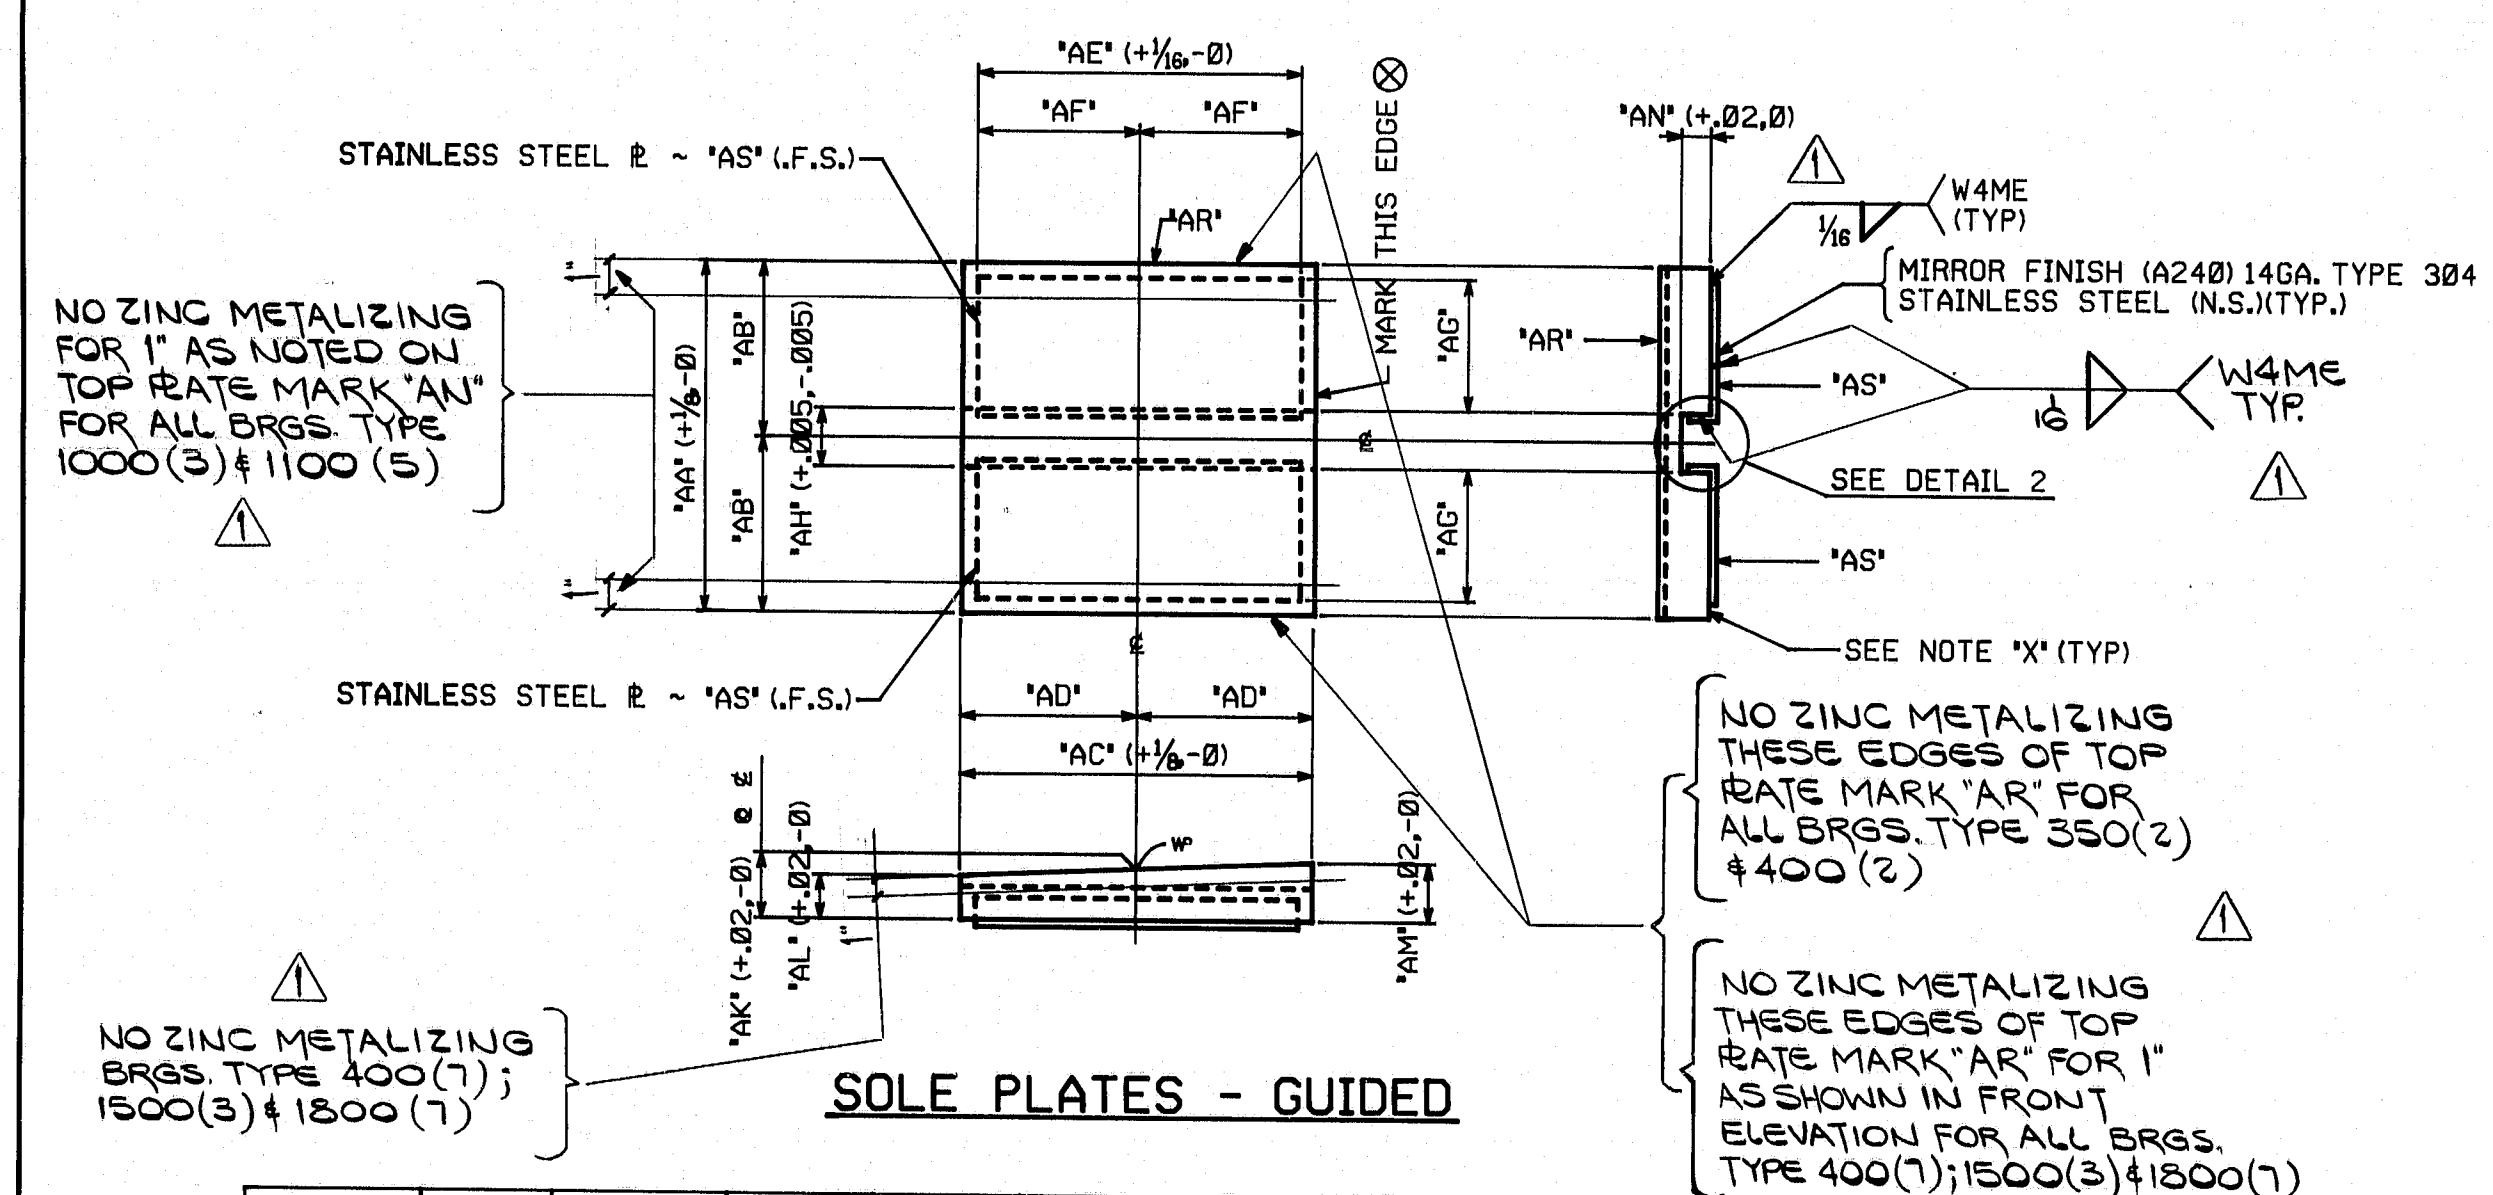

SOLE PLATES - GUIDED

LOCATION	GIRDER	BRG. TYPE	'AA'	'AB'	'AC'	'AD'	'AE'	'AF'	'AG'	'AH'	'AI'	'AJ'	'AK'	'AL'	'AM'	'AN'	'AP'	'AR'	'AS'
PIER 2	4,7	G-350(2)	1'-2 3/4	7 3/4	1'-3 3/4	7 3/4	1'-3 3/4	7 3/4	8 3/4	.81	1.25	1.07	1.43	.56	%	bfn	bgm		
ABUT. 1	4	G-400(2)	1'-3 3/4	7 3/4	1'-4 3/4	8 3/4	1'-4 3/4	8 3/4	7 3/4	.81	1.23	1.05	1.41	.56	%	bfn	bgp		
	7	G-400(2)	1'-3 3/4	7 3/4	1'-4 3/4	8 3/4	1'-4 3/4	8 3/4	7 3/4	.81	1.23	1.02	1.44	.56	%	bfn	bgp		
ABUT. 2	4,5	G-400(7)	1'-4 1/4	8 3/4	1'-9 3/4	10 3/4	1'-9 3/4	10 3/4	7 3/4	.81	1.66	1.35	1.97	.56	%	bfn	bgg		
PIER 6	4,5	G-1000(3)	2'-1 1/2	1'-0 1/4	2'-1	1'-0 1/2	2'-0 1/2	1'-0 1/4	11 1/8	1.06	1.91	1.61	2.21	.75	%	bfs	bgw		
PIER 7	4,5	G-1100(5)	2'-1 3/4	1'-0 1/8	2'-1 3/4	1'-0 1/8	2'-0 7/8	1'-0 7/8	11 1/8	1.31	2.05	1.65	2.45	.93	%	bfs	bgw		
PIER 4	4,5	G-1500(3)	2'-5 1/4	1'-2 3/4	2'-6 1/4	1'-3 3/4	2'-5 3/4	1'-2 3/4	1'-1 1/8	1.31	2.09	2.04	2.14	.93	%	bfs	bha		
PIER 3	4	G-1800(7)	2'-9	1'-4 1/2	3'-1	1'-6 1/2	3'-0 1/2	1'-6 1/4	1'-3 3/4	1.31	2.28	2.15	2.41	.93	%	bfs	bhb		
	5	G-1800(7)	2'-9	1'-4 1/2	3'-1	1'-6 1/2	3'-0 1/2	1'-6 1/4	1'-3 3/4	1.31	2.28	2.17	2.39	.93	%	bfs	bhb		

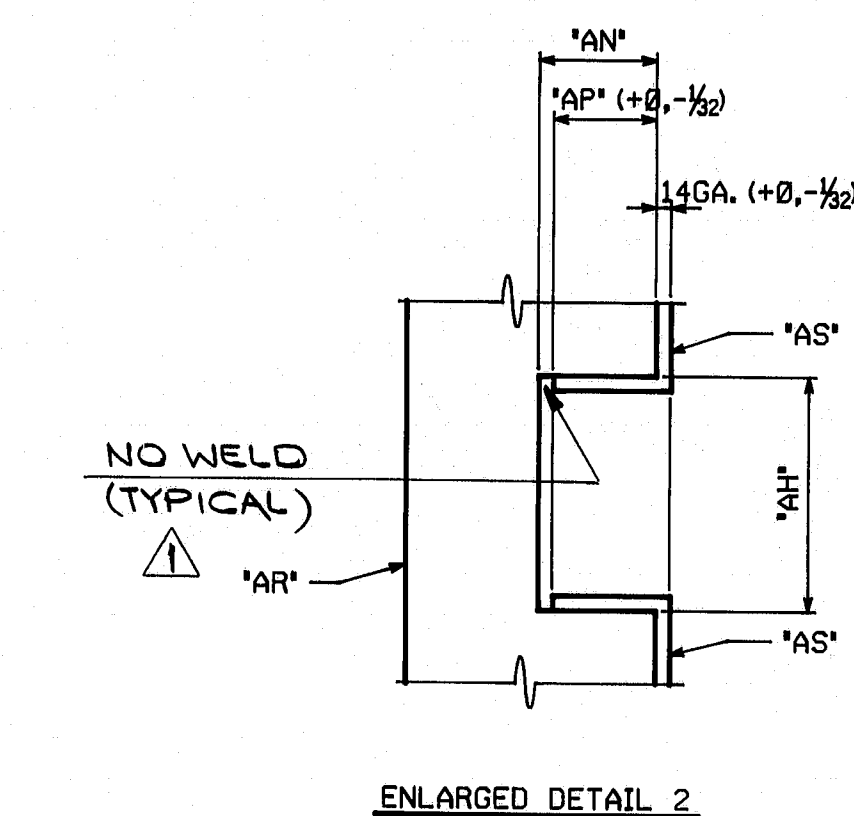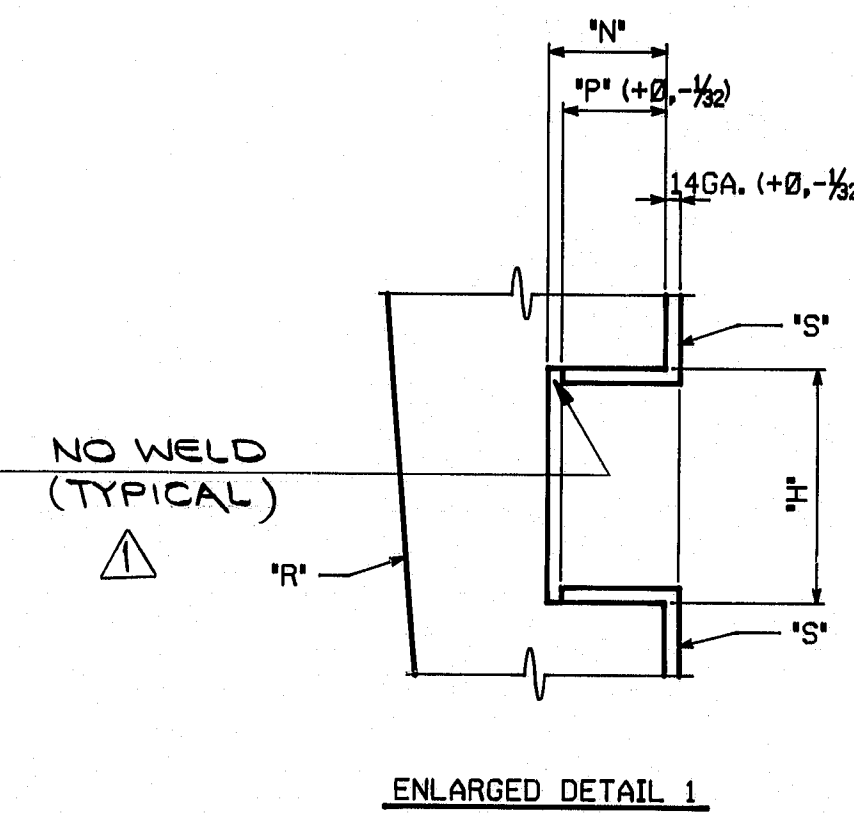

NOTES:

NOTE 'A': SURFACES INDICATED ARE TO BE STRAIGHT AND TRUE; FINISH IF NECESSARY.

NOTE 'X': SURFACES INDICATED ARE TO BE MACHINED FLAT TO .01"/FT. (0.4" MAXIMUM)

ALL DIMENSIONS GIVEN THUS: 2.21 ARE DECIMALS OF AN INCH. FOR NOTES AND REFERENCE, SEE DRAWING D-1001-1A. MATERIAL TO BE ASTM A588 (U.N.)




SHOP NOTE

HOLES: NONE
BOLTS: NONE

REQUIRED PER SHIPMENT		BILL OF MATERIAL										FED. ROAD DIV. NO.		STATE		FED. AID PROJ. NO.	
#1	#2	#3	NO.	MARK	DESCRIPTION	LENGTH	REMARKS	ITEM	WEIGHT	EA.		1	ME.	1-10-395-8182176			
SOLE PLATES - GUIDED																	
2	--	--	2	bfn	14 3/4 x (1.43 x 1.07)	1	3%	FOR BRG. TYPE 350	26								
1	--	--	1	bfn	15 1/2 x (1.41 x 1.05)	1	4%	FOR BRG. TYPE 400	25								
1	--	--	1	bfn	15 1/2 x (1.44 x 1.02)	1	4%	FOR BRG. TYPE 400	25								
--	--	2	2	bfn	16 1/4 x (1.97 x 1.35)	1	9%	FOR BRG. TYPE 400	23								
--	--	2	2	bfs	25 1/2 x (2.21 x 1.61)	2	1	FOR BRG. TYPE 1000	18								
--	--	2	2	bft	25 1/2 x (2.45 x 1.65)	2	4%	FOR BRG. TYPE 1100	14								
--	--	2	2	bfw	29 1/4 x (2.14 x 2.04)	2	6%	FOR BRG. TYPE 1500	21								
--	--	1	1	bfs	33 x (2.41 x 2.15)	3	1	FOR BRG. TYPE 1800	13								
--	--	1	1	bgs	33 x (2.39 x 2.17)	3	1	FOR BRG. TYPE 1800	13								
1	--	--	1	bgs	22 1/2 x (2.21 x 1.59)	1	11	FOR BRG. TYPE 900	19								
1	--	--	1	bgs	22 1/2 x (2.20 x 1.60)	1	11	FOR BRG. TYPE 900	19								
4	--	--	4	bgs	22 1/2 x (2.17 x 1.63)	1	11	FOR BRG. TYPE 900	19								
2	--	--	2	bgs	22 1/2 x (2.19 x 1.61)	1	11	FOR BRG. TYPE 900	19								
--	--	3	3	bgs	25 1/2 x (2.16 x 1.86)	2	1%	FOR BRG. TYPE 1100	17								
--	--	1	1	bgh	25 1/2 x (2.19 x 1.83)	2	1%	FOR BRG. TYPE 1100	17								
--	--	1	1	bgi	25 1/2 x (2.20 x 1.82)	2	1%	FOR BRG. TYPE 1100	17								
--	--	1	1	bgm	25 1/2 x (2.21 x 1.81)	2	1%	FOR BRG. TYPE 1100	17								
4	--	--	4	bgn	7 1/2 x 14GA.	1	3%	A240 TYPE 304 FOR BRG. TYPE 350	20								
4	--	--	4	bgs	7 1/2 x 14GA.	1	4%	A240 TYPE 304 FOR BRG. TYPE 400	19								
--	--	4	4	bgs	7 1/2 x 14GA.	1	9%	A240 TYPE 304 FOR BRG. TYPE 400	18								
--	--	4	4	bgw	11 1/2 x 14GA.	2	0%	A240 TYPE 304 FOR BRG. TYPE 1000	15								
--	--	4	4	bgw	12 1/2 x 14GA.	2	3%	A240 TYPE 304 FOR BRG. TYPE 1100	13								
--	--	4	4	bha	14 1/2 x 14GA.	2	5%	A240 TYPE 304 FOR BRG. TYPE 1500	11								
--	--	4	4	bhb	16 1/2 x 14GA.	3	0%	A240 TYPE 304 FOR BRG. TYPE 1800	8								
16	--	--	16	bhc	11 1/2 x 14GA.	1	10%	A240 TYPE 304 FOR BRG. TYPE 900	16								
--	--	12	12	bhd	12 1/2 x 14GA.	2	0%	A240 TYPE 304 FOR BRG. TYPE 1100	14								

NO. 1	REVISION altered as per 10-11-84 app'.	DATE 10-17-84
POT BEARING DETAILS		
I-395 BRIDGE OVER PENOBSCOT RIVER		
I-395 BRIDGE STA. 164+60.00		
PENOBSCOT COUNTY		
STATE OF MAINE		
DEPARTMENT OF TRANSPORTATION		
STATE CONTRACT OR REF. NO. 6	CONTRACTOR CIANBRO CORP.	
IN CHARGE: HINKLE	MADE BY: B.J.K.	CHECKED BY: JCH
DATE: 2-16-84	DATE: 7-2-84	
CONTRACT NUMBER: ME-84088-1,2,3	DRAWING NUMBER: D-1001-1E	

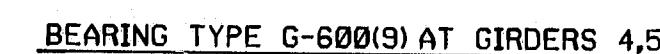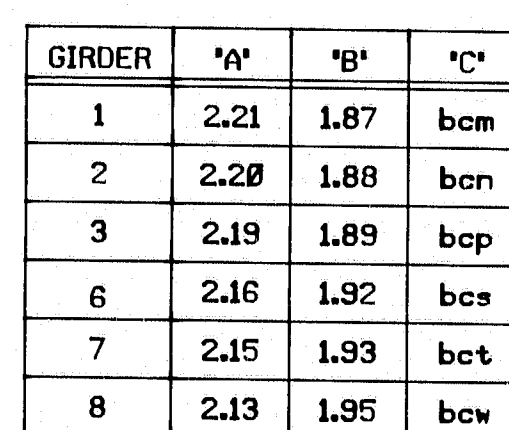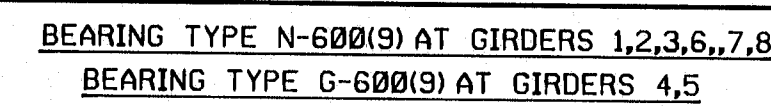

R95-157




R95-158

		FED. ROAD DIV. NO.	STATE	FED. AID PROJ. NO.		
		1	ME.	I-10-395-(8/21/7)		
BILL OF MATERIAL						
NO.	MARK	DESCRIPTION	LENGTH	REMARKS	ITEM	SW REV EA
		MASONRY PLATES		FOR BRG. TYPE 600		
16	bhf	BAR 4 1/4" x 1'	1	11	ASTM A514	1E 28
8	bhg	2 28 1/2" x 1.71	2	4 1/2		1A 8
		SOLE PLATES		FOR BRG. TYPE N-600(13)		
1	bcm	2 21 3/4" x (2.21 x 1.87)	2	2 1/2		1B 20
1	bcn	2 21 1/4" x (2.20 x 1.88)	2	2 1/2		1B 20
1	bcp	2 21 1/4" x (2.19 x 1.89)	2	2 1/2		1B 20
1	bcs	2 21 1/4" x (2.16 x 1.92)	2	2 1/2		1B 22
1	bct	2 21 1/4" x (2.15 x 1.93)	2	2 1/2		1B 22
1	bcw	2 21 1/4" x (2.13 x 1.95)	2	2 1/2		1B 22
6	bfb	2 18 3/8" x 14 GA.	2	2	A240 TYPE 304	1C 7
12	bhh	2 1 1/4" x 3 1/2" x (1.14 x 1.04)	0	6	MADE FROM SOLID BLOCK (ASTM A514)	1C 20
		SOLE PLATES		FOR BRG. TYPE G-600(13)		
2	bfp	2 21 1/4" x (2.17 x 1.91)	2	2 1/2		1B 22
4	bgf	2 9 3/8" x 14 GA.	2	2	A240 TYPE 304	1C 17
4	bhh					


ALL MATERIAL REQUIRED FOR SHIPMENT 22

NO. 	REVISION altered as per 10-11-84 appv	DATE 9-28-84 10-17-84
HIGH STEEL STRUCTURES, INC. 		808 Old Philadelphia Pike Lancaster, Pennsylvania 17603 Phone 717/299-852
		A Subsidiary of High Industries, Inc.
POT BEARING DETAILS		
I-395 BRIDGE OVER PENOBSCOT RIVER		
I-395 BRIDGE STA. 164+60.00		
PENOBSCOT COUNTY		
STATE OF MAINE		
DEPARTMENT OF TRANSPORTATION		
STATE CONTRACT OR REF. NO. 6 CONTRACTOR CIANBRO CORP.		
IN CHARGE HINKLE	MADE BY B.J.K.	CHECKED BY JCH. DATE 8-17-84
CONTRACT NUMBER ME-84088-2	DRAWING NUMBER	D-1001-1F

AF 22682A

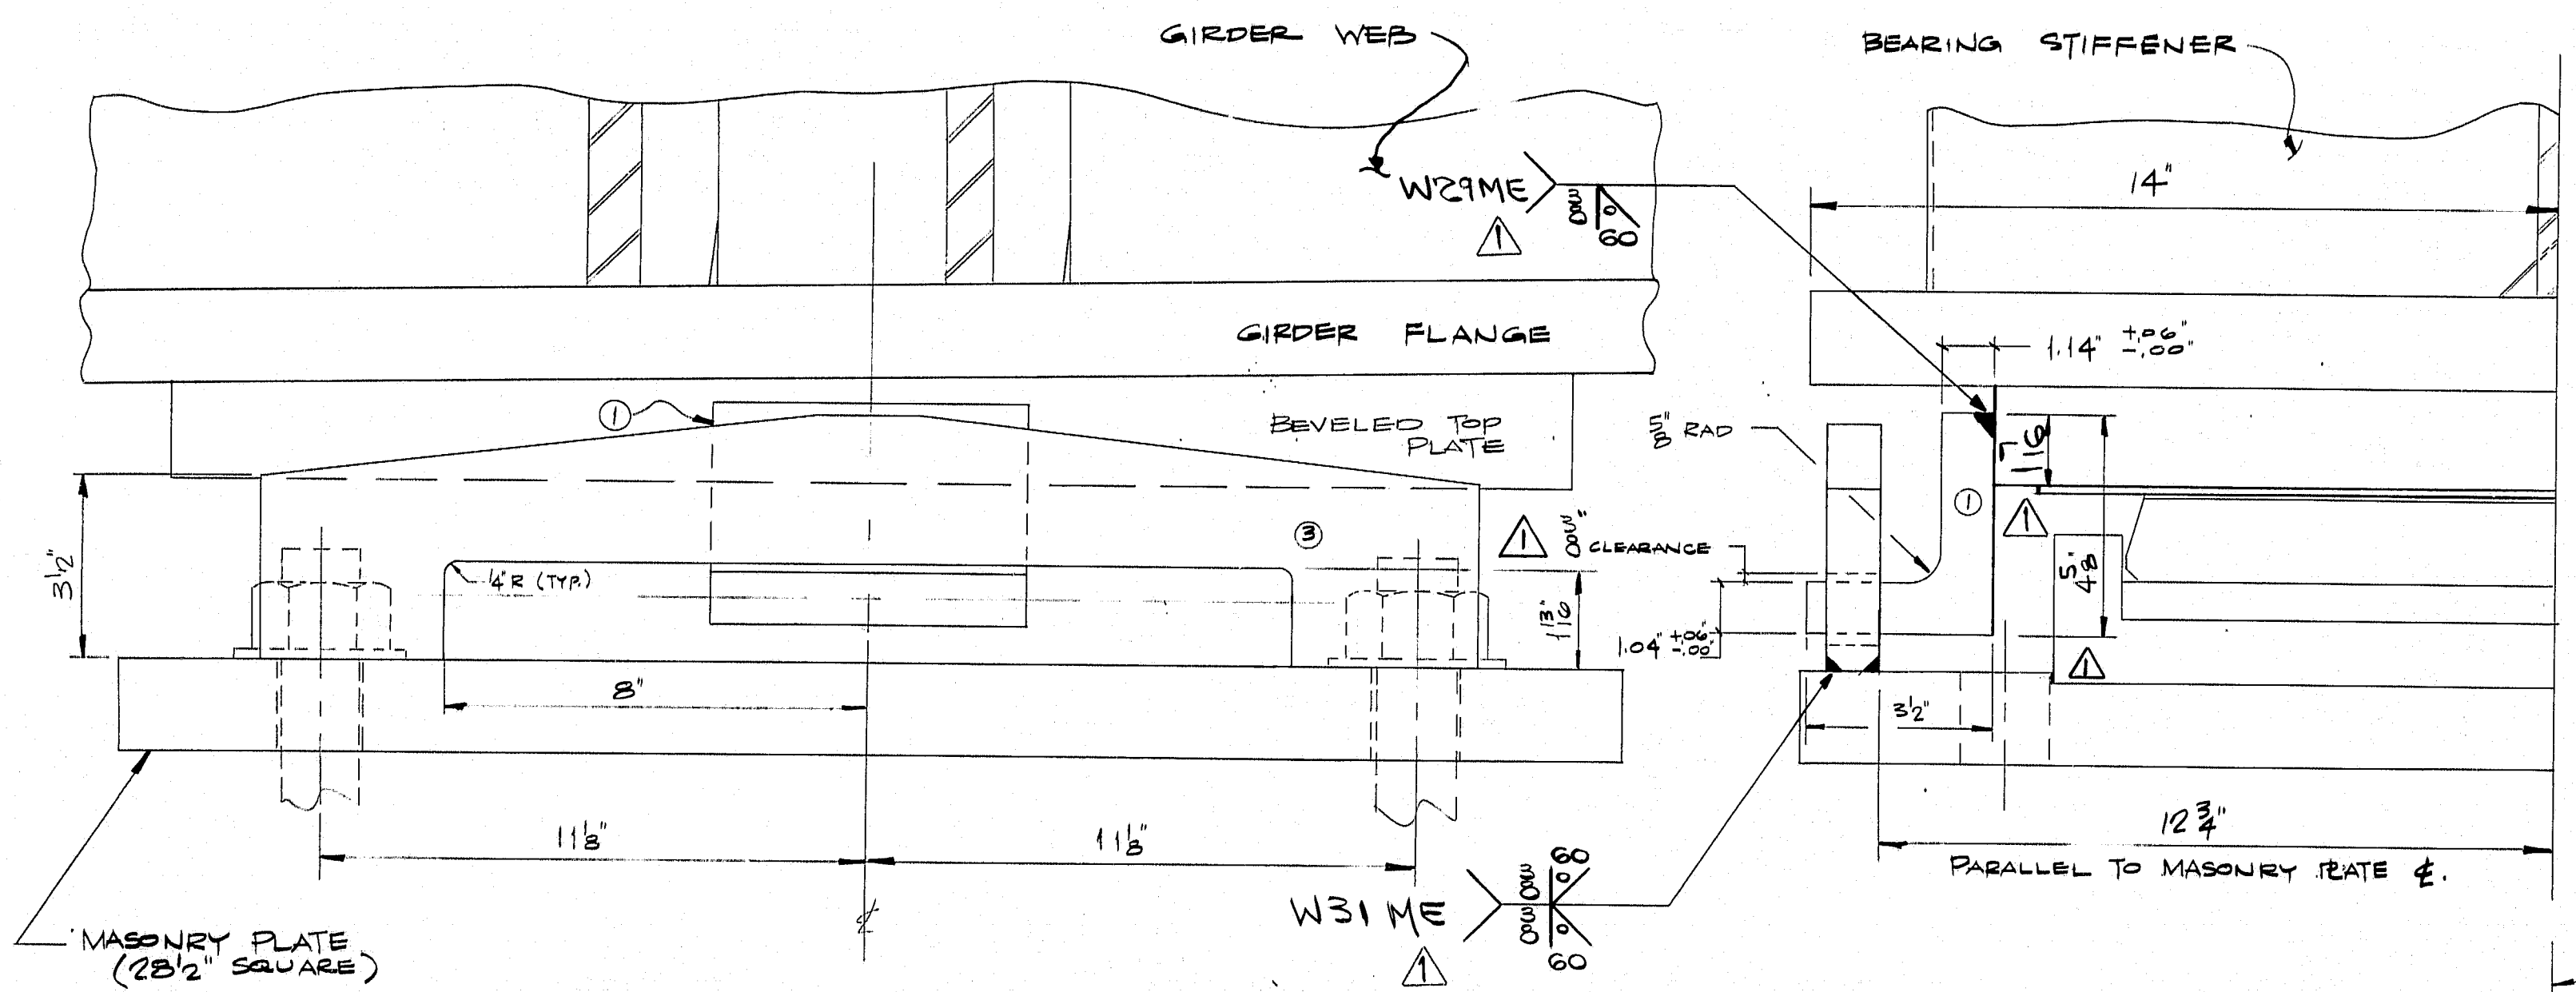

SIDE ELEVATION

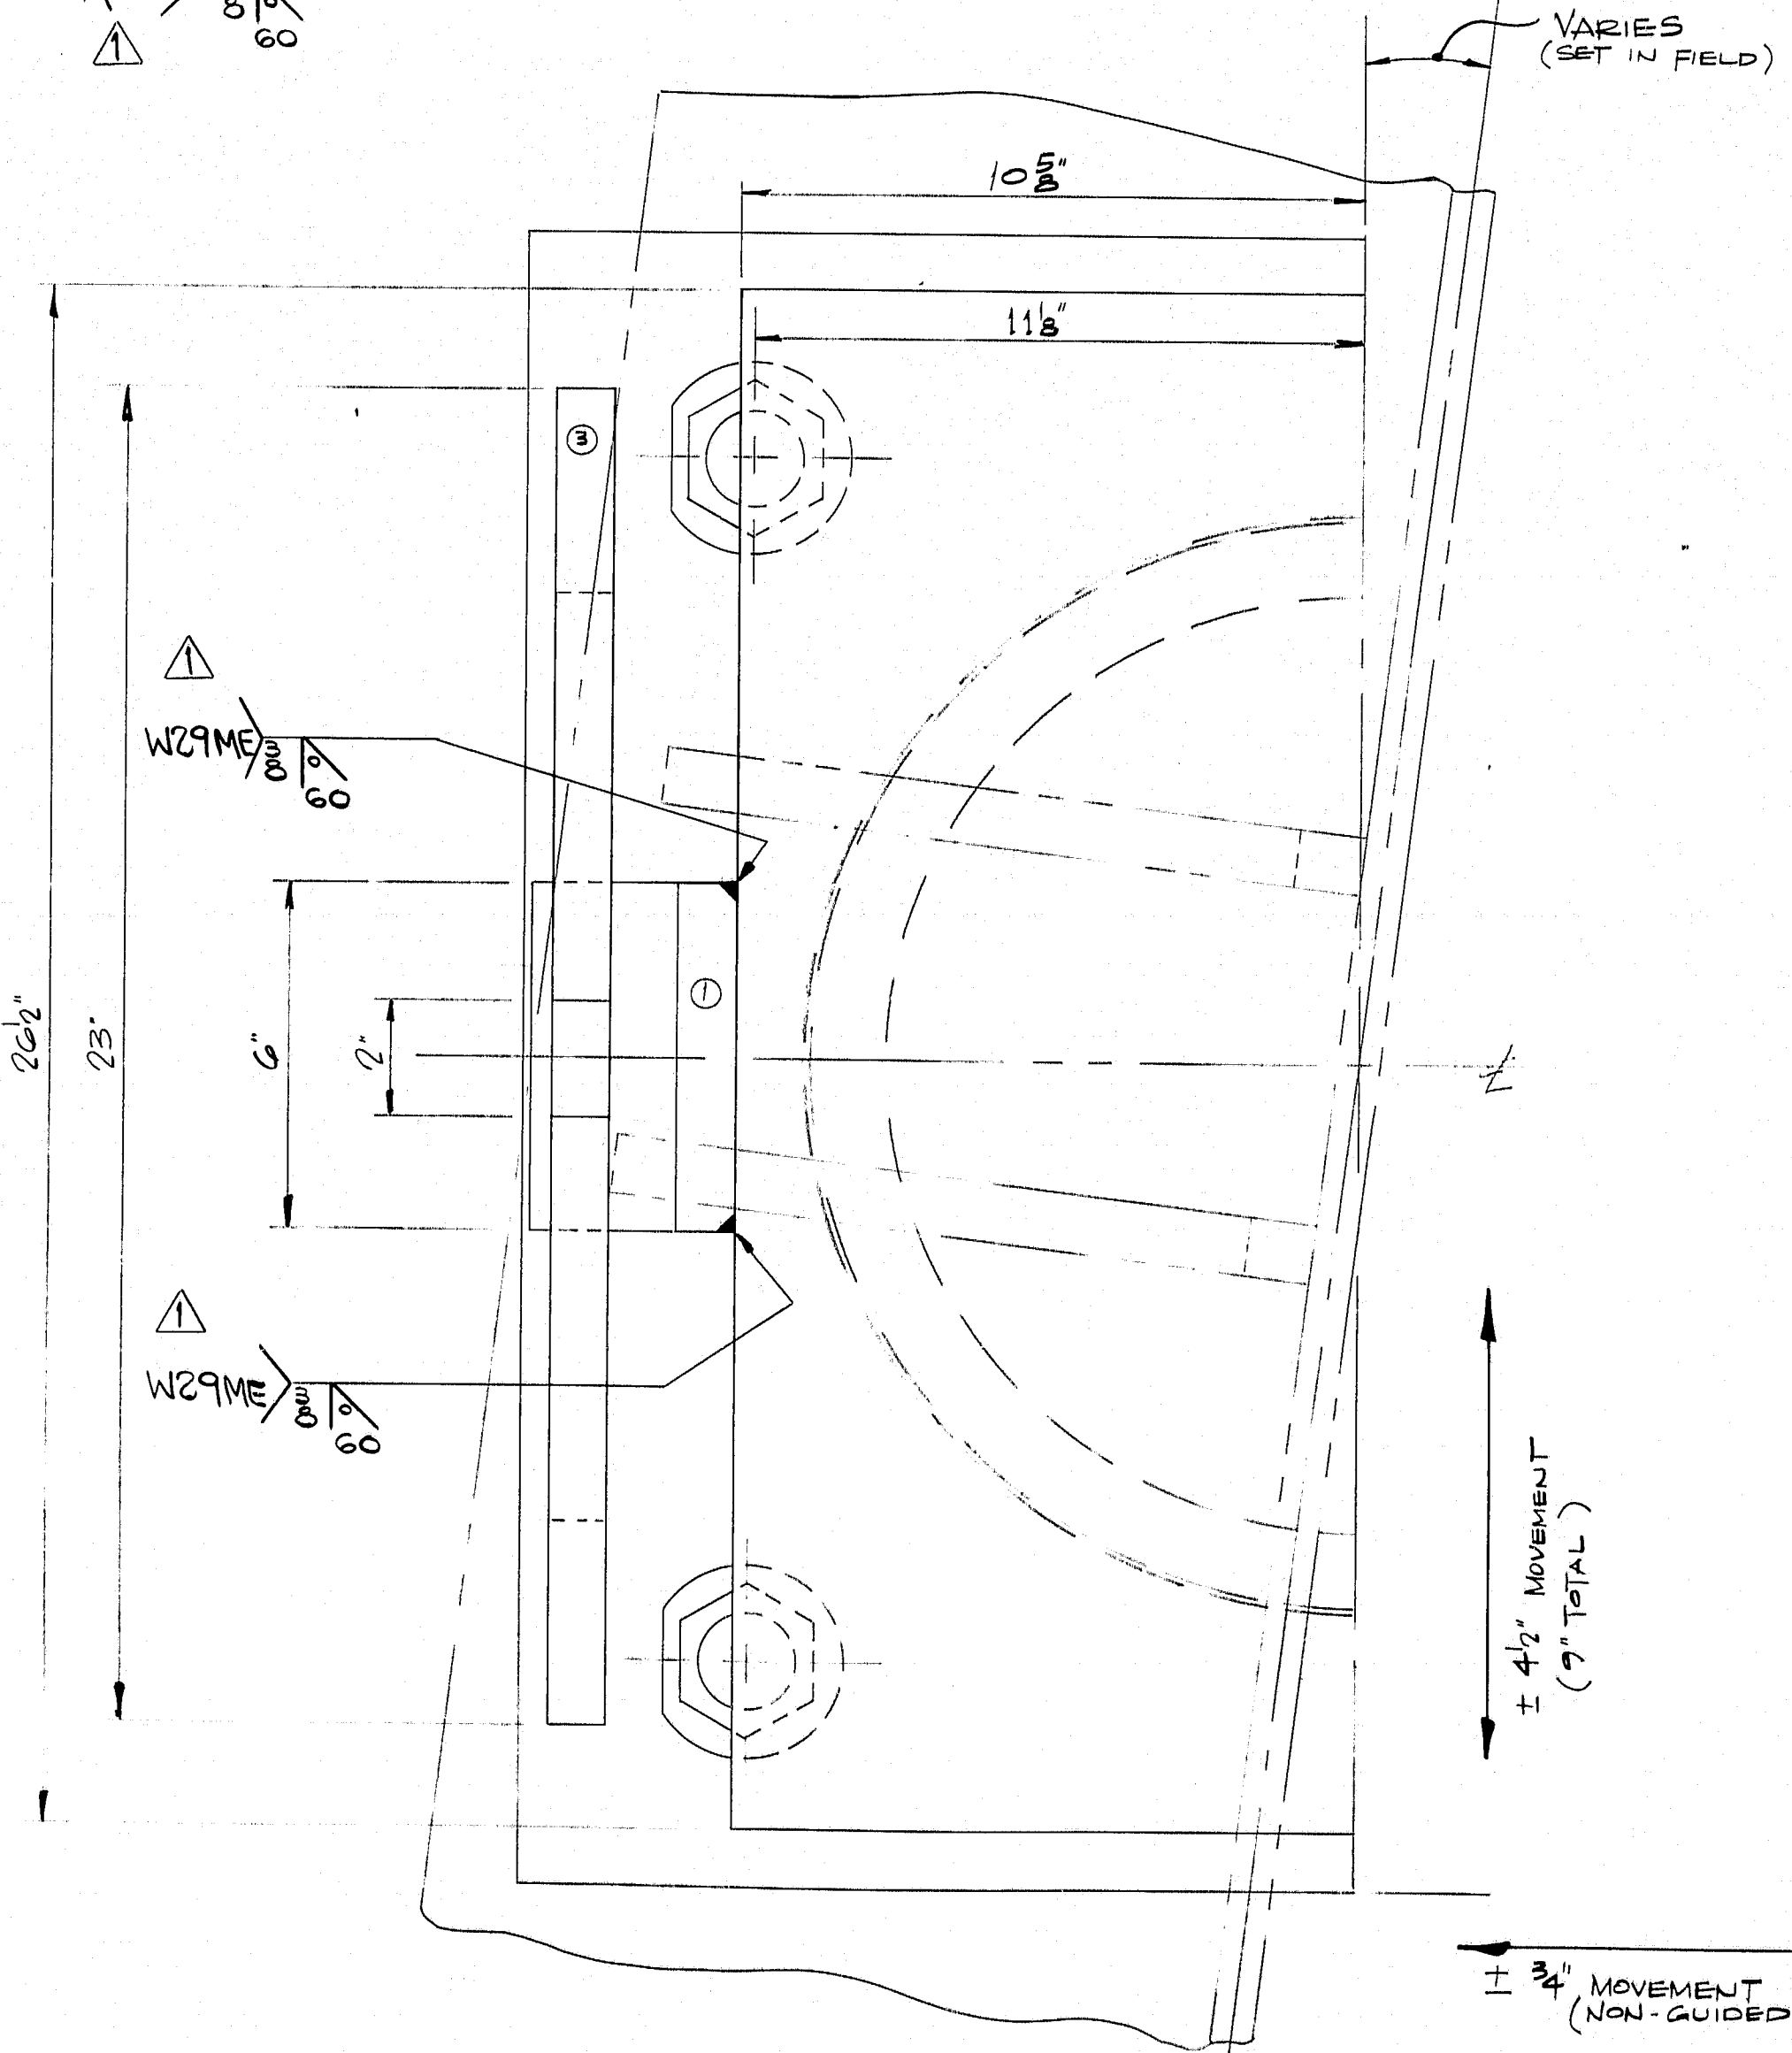

PLAN VIEW
(HALF OF DETAIL SHOWN)

- NOTES:
1. WORK THIS DRAWING WITH D-1001-1A.
 2. UPLIFT PER BEARING: 45K MIN.
 3. DIMENSIONS & CLEARANCES GIVEN ALLOW FOR REMOVAL OF BASE/CYLINDER. ALSO, ALLOWS FOR MOVEMENT TO EXTREME LIMIT AS REQUIRED ON CONTRACT DRAWINGS.

		FED. ROAD DIV. NO.	STATE	FED. AID PROJ. NO.		
BILL OF MATERIAL						
NO.	MARK	DESCRIPTION	LENGTH	REMARKS	ITEM	WEIGHT
	①	$4\frac{5}{8} \times 2\frac{1}{2} \times (11\frac{1}{4} \pm .04)$	—	6" $\sqrt{\text{ASTM A514}}$		
	②	$4\frac{3}{4} \times 1"$	11"	MACHINE ANGLE FRONT SHOLD PISE $\sqrt{\text{ASTM A514}}$		

SHOP NOTE

HOLES: REFER TO
BOLTS: DWG. D-1001-1A
PAINT:

R95-159

CODE: 6000

NO. 1	REVISION altered as per 10-11-84 appv	DATE 9-28-84 10-17-84
HIGH STEEL STRUCTURES, INC.		
1905 Old Philadelphia Pike Lancaster, Pennsylvania 17603 Phone 717/299-6211		
A Subsidiary of High Industries, Inc.		
STATE OF MAINE - DEPT. OF TRANSPORTATION		
I-395 BRIDGE OVER PENOBSCOT RIVER		
BANGOR - BEEFER PENOBSCOT COUNTY		
UPLIFT DETAILS FOR PIER 2 - SPAN 3		
BEARING DETAILS BY BERMAZ CORP. INT'L, FAIRFIELD, N.J. 07004-4		
STATE CONTRACT OR REF. NO. 6	CONTRACTOR CIANBRO CORP.	
IN CHARGE:	MADE IN U.S.A. CHK. D. BY: B.G.B.E. BY: DATE: 8-6-84	
CONTRACT ME-84088-1,2,3	DRAWING NUMBER: D-1003-1A	