


- Rail Bars:  
 △ HSS 8x4x $\frac{5}{16}$  (1)  
 HSS 4x4x $\frac{1}{4}$  (3)

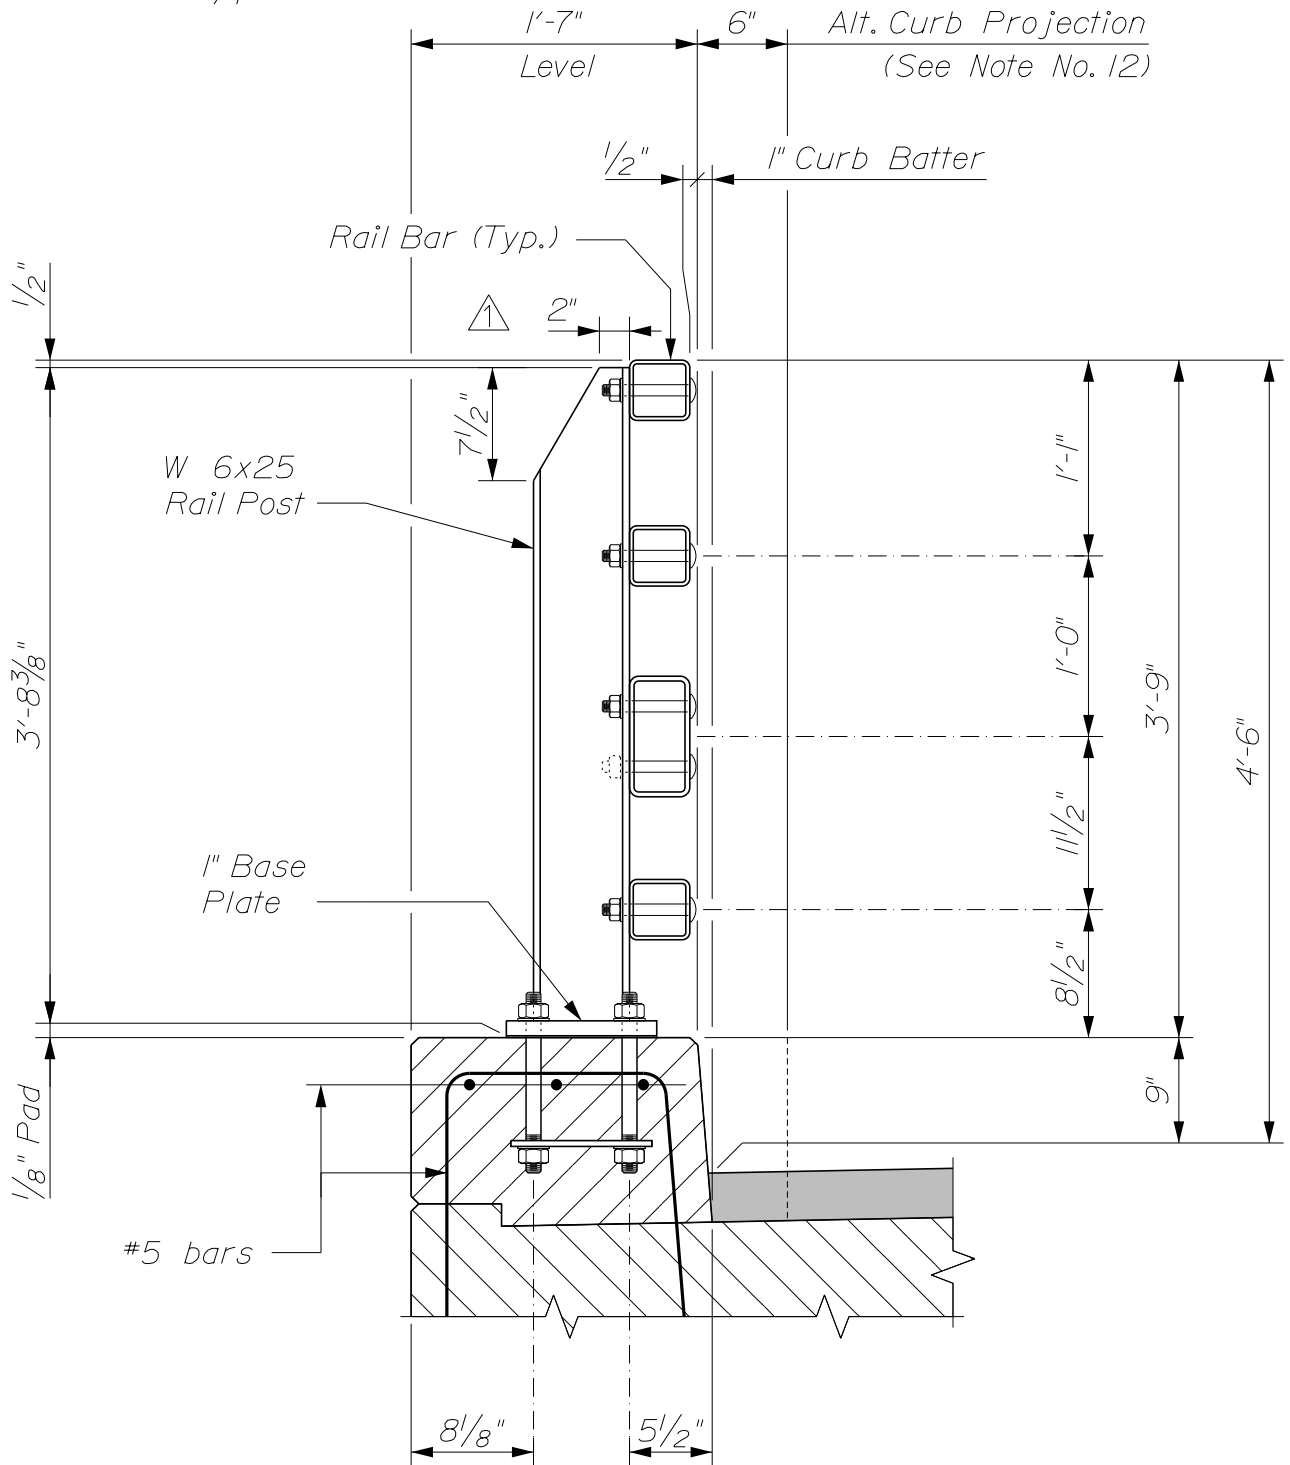

~ TYPICAL RAILING SECTION ~  
 (4 - Bar Traffic / Bicycle Railing)

STEEL BRIDGE RAILING  
 Supersedes 507(06)