


B ←

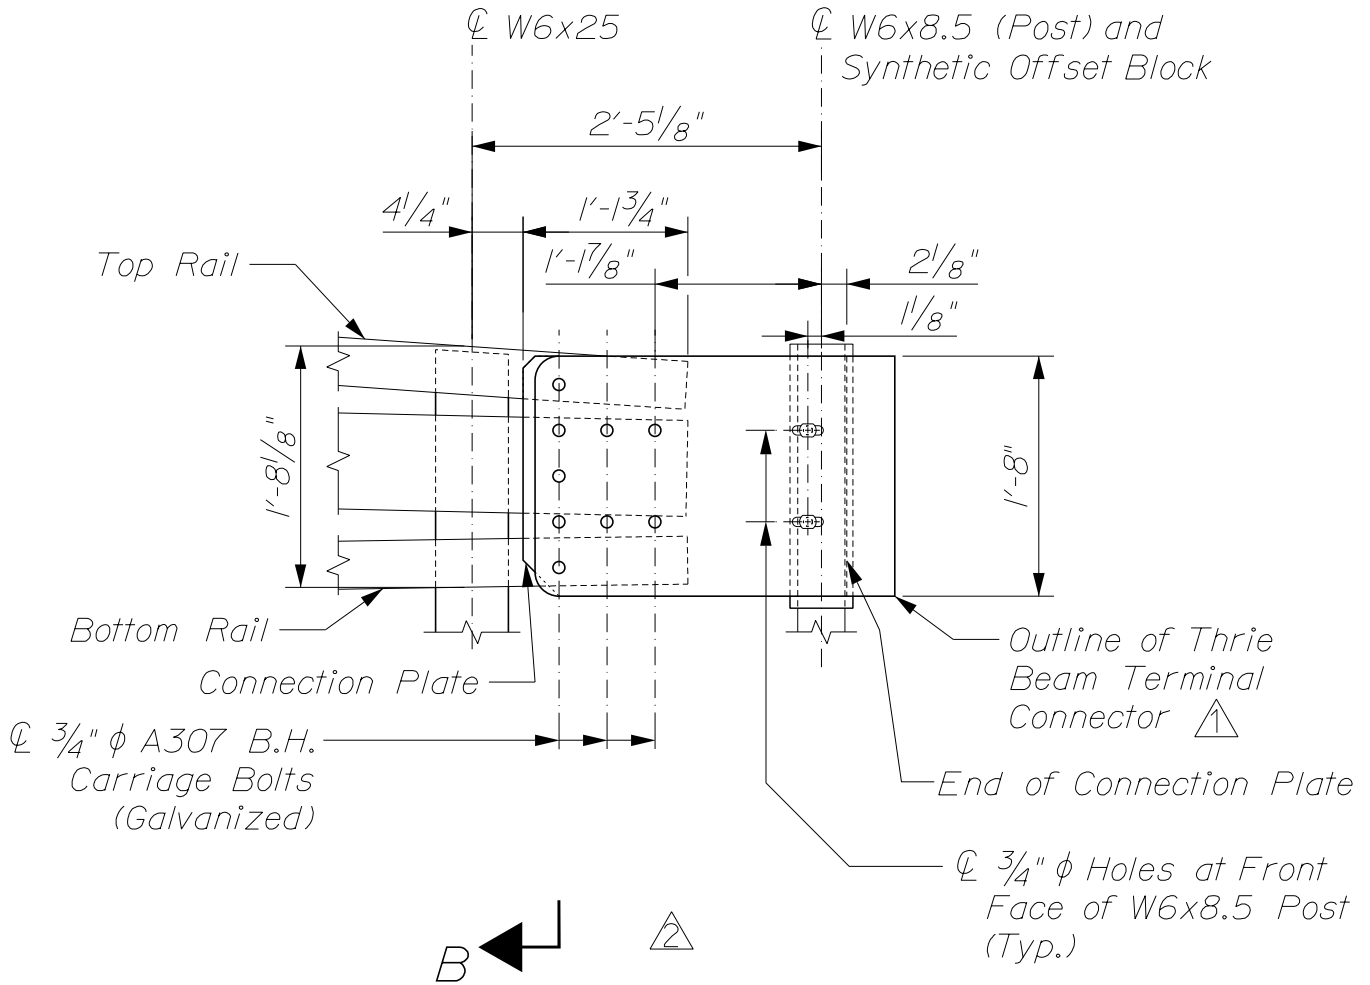

~ DETAIL "A" ~

(Overlapping of Double Nested Thrie-Beam not Shown for Clarity)

STEEL APPROACH RAILING, 3-BAR

Supersedes 507(23)

△ Dec. 22, 2020

△ Mar. 27, 2025