


~ TRANSITION BARRIER PLAN ~

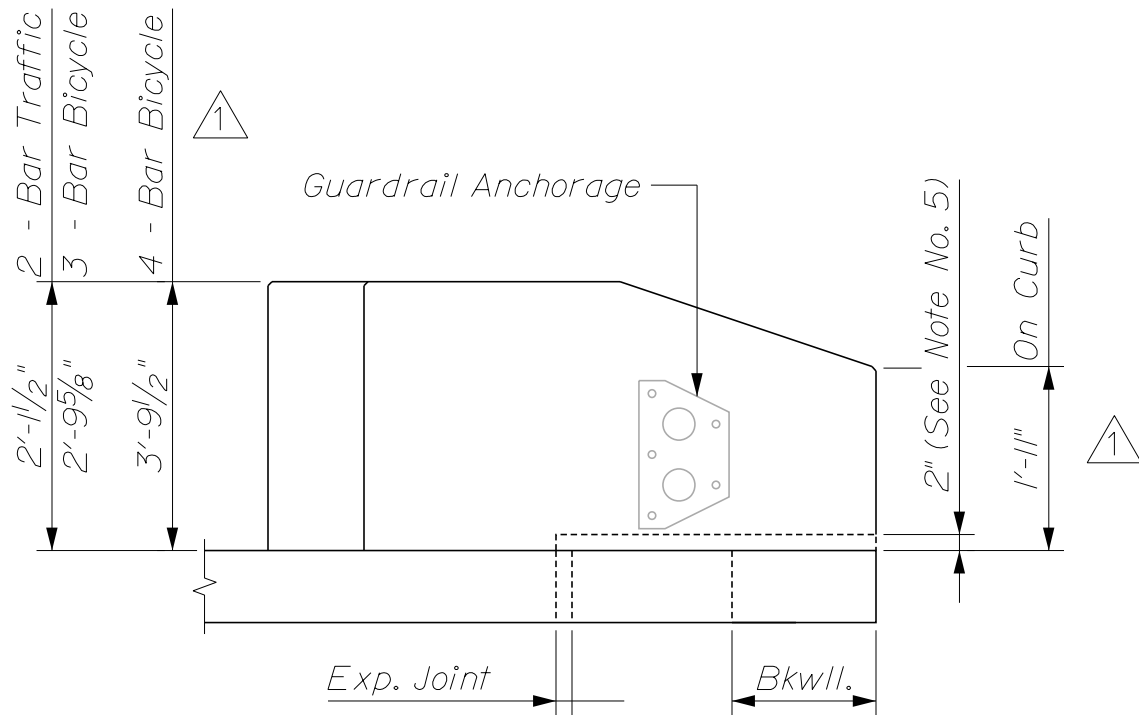

~ TRANSITION BARRIER ELEVATION ~

CONCRETE TRANSITION BARRIER  
Supersedes 526(23)