



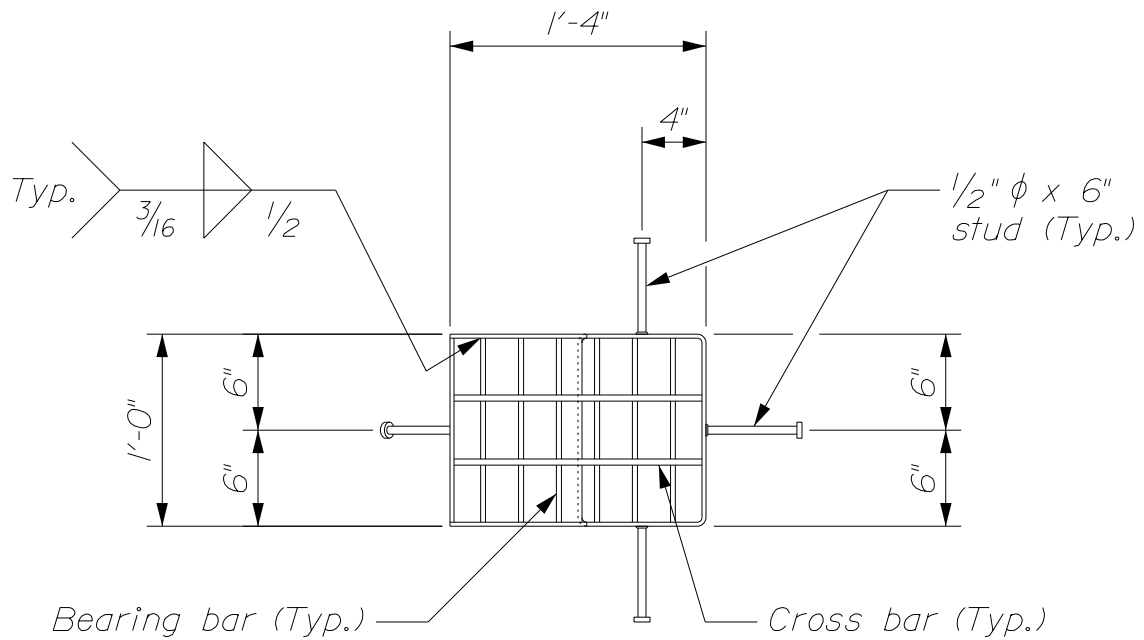

~ DRAIN TYPE "B" TOP VIEW ~

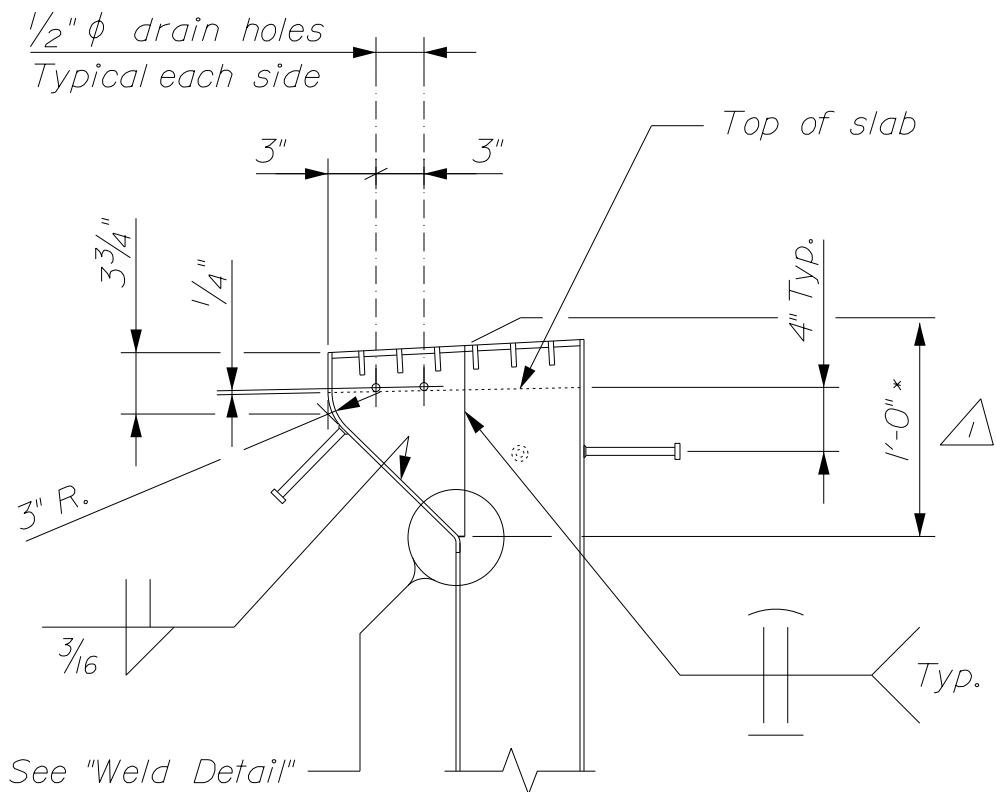

~ DRAIN TYPE "B" SECTION ~

$\triangle 1$ * 1'-0" For 3" Thick H.M.A. Wearing Surface.
0'-9" For A 1" Thick Integral Concrete Wearing Surface.