


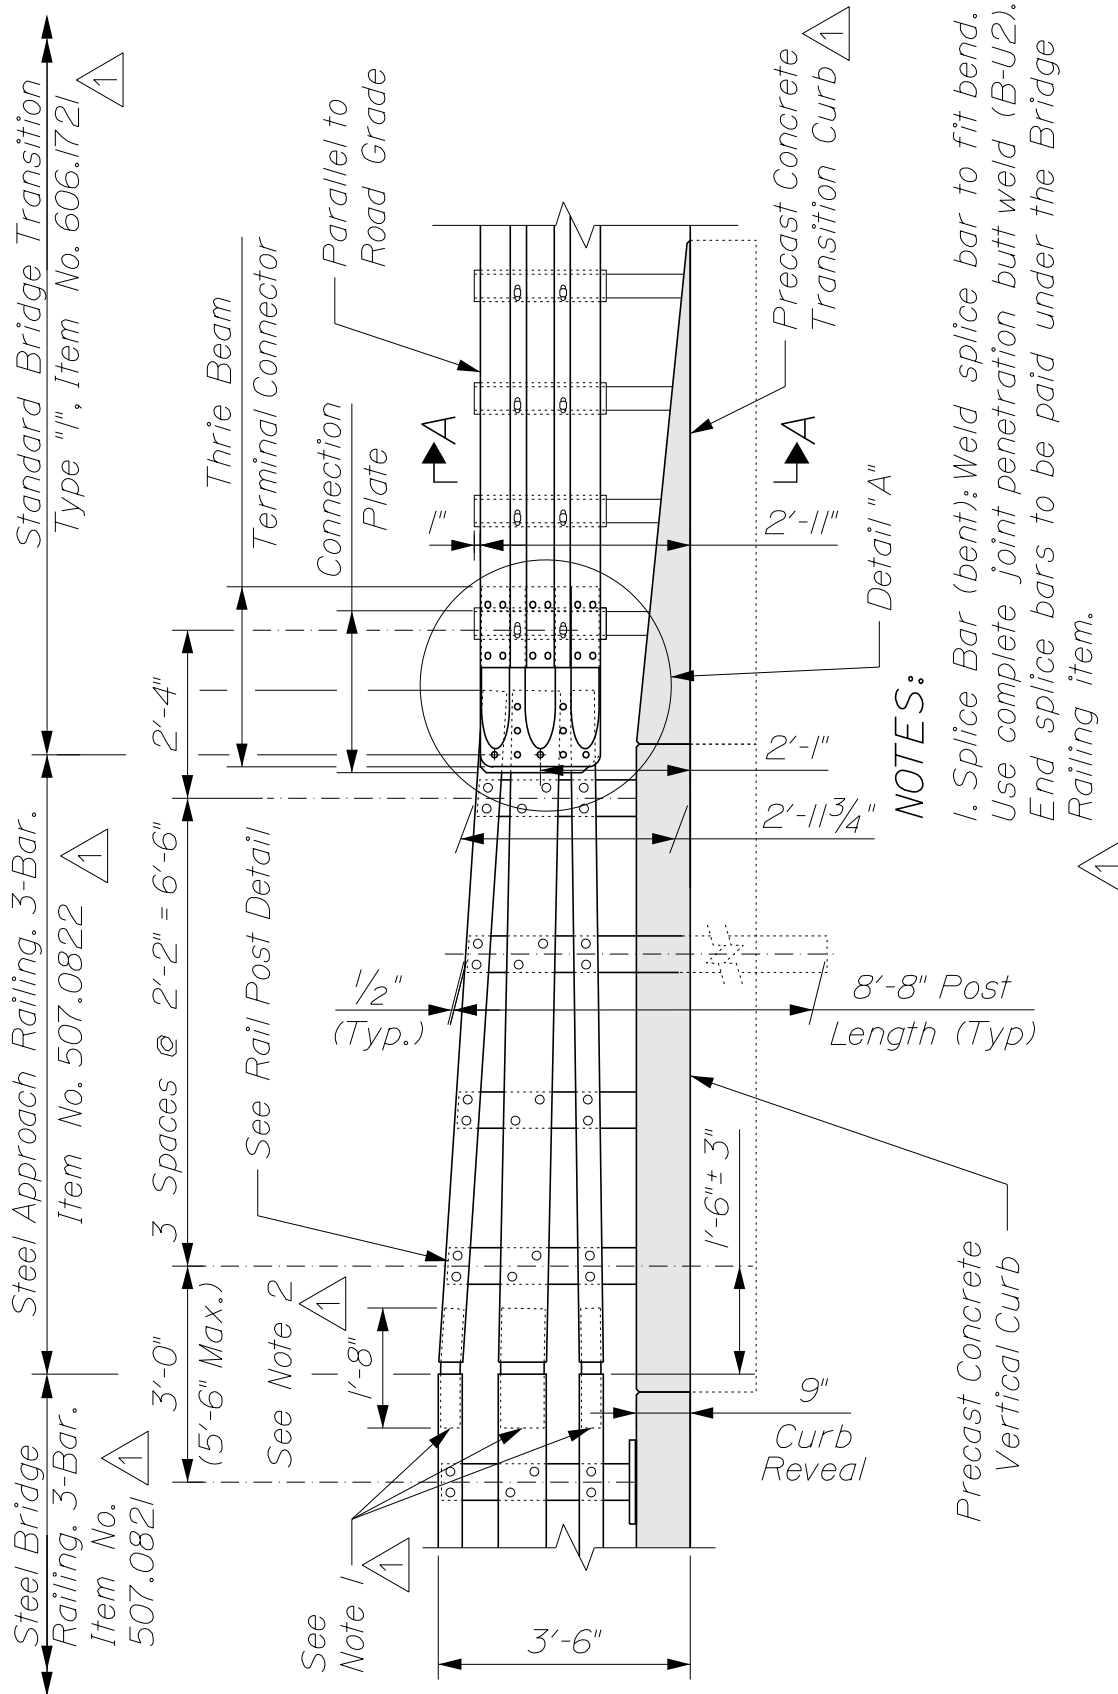

STEEL APPROACH RAILING, 3-BAR

Supplemental
Standard Detail

Supersedes 507(20)

Dec. 29, 2020