



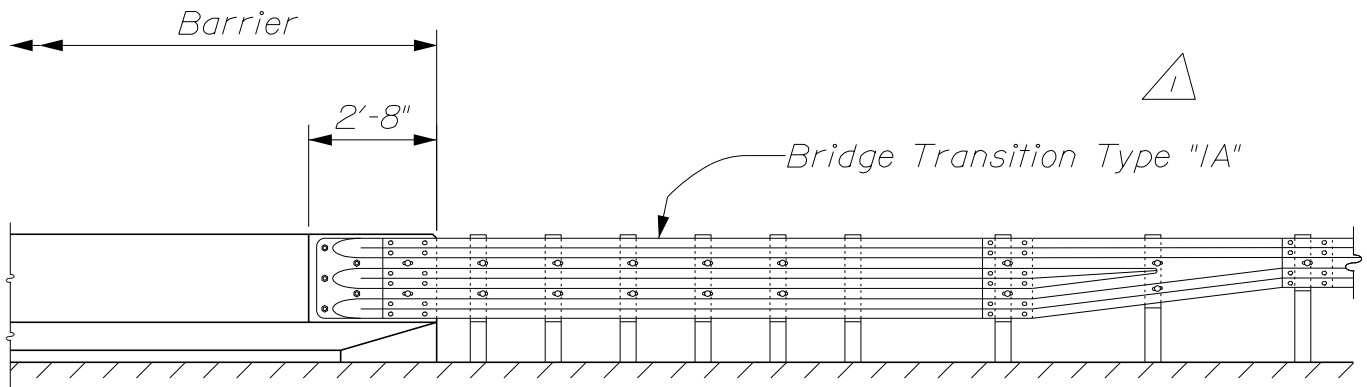

~ PERMANENT CONCRETE BARRIER TYPE IIIA ~

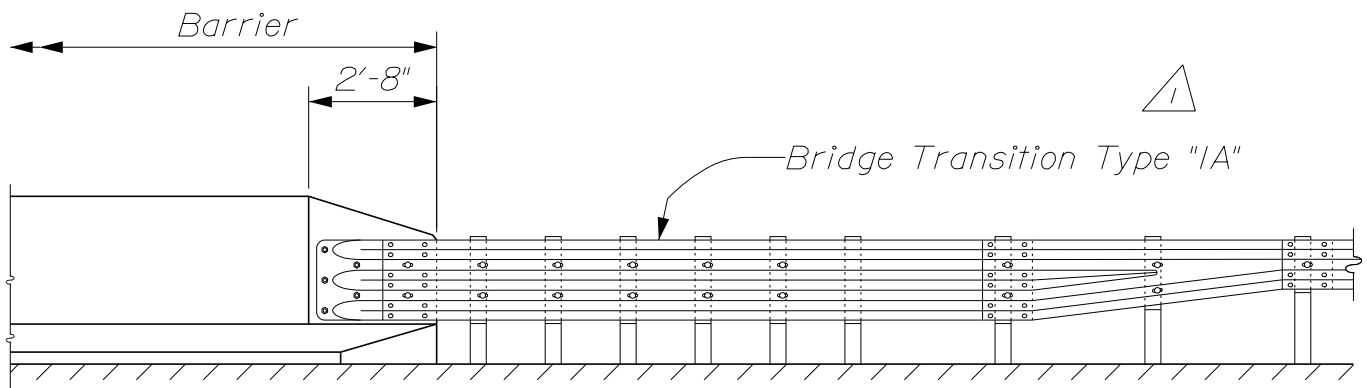

~ PERMANENT CONCRETE BARRIER TYPE IIIB ~

# PERMANENT CONCRETE BARRIER

Supersedes 526(05)

Supplemental  
Standard Detail

Jan. 3, 2023