




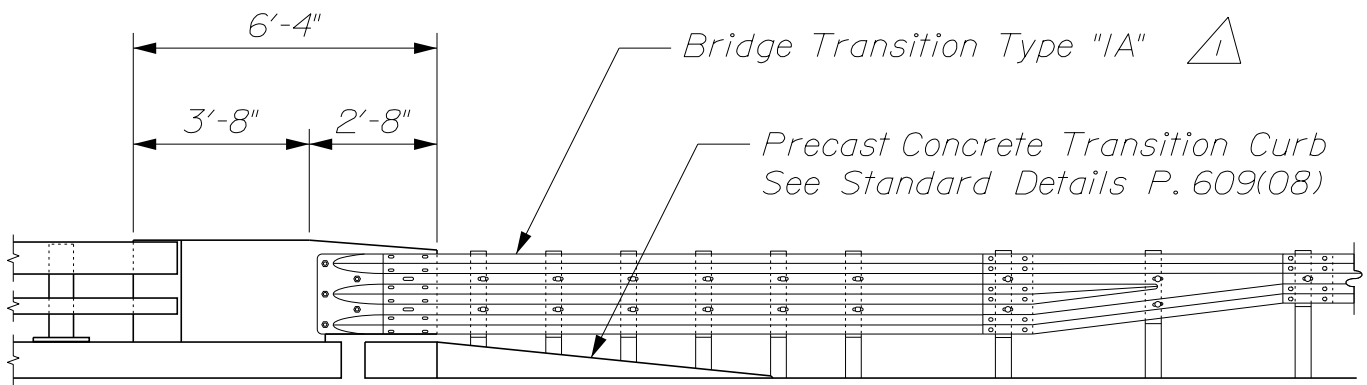

~ CONCRETE TRANSITION BARRIER ~
(2 - Bar Traffic Railing)

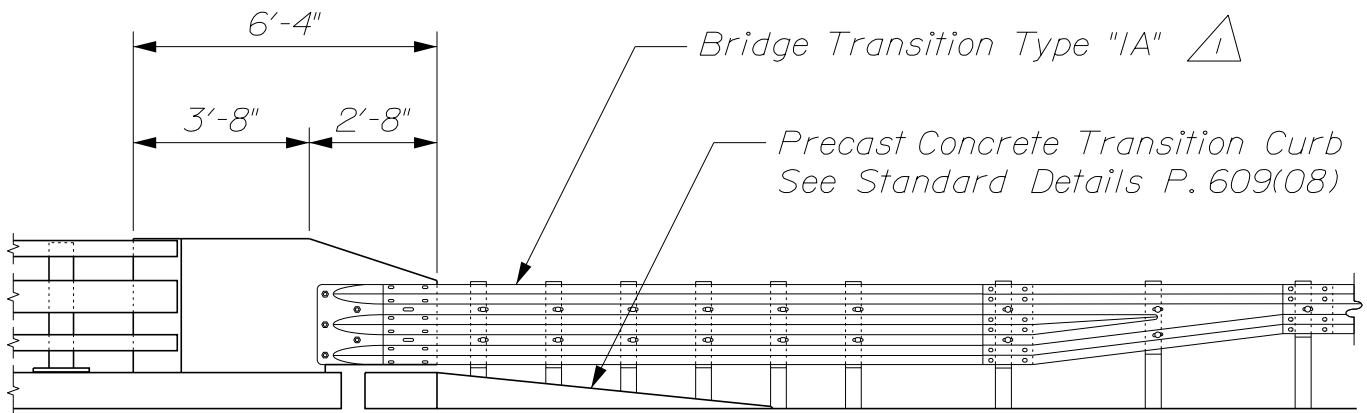

~ CONCRETE TRANSITION BARRIER ~
(3 - Bar Traffic / Bicycle Railing)
(4 - Bar Traffic / Bicycle Railing similar)

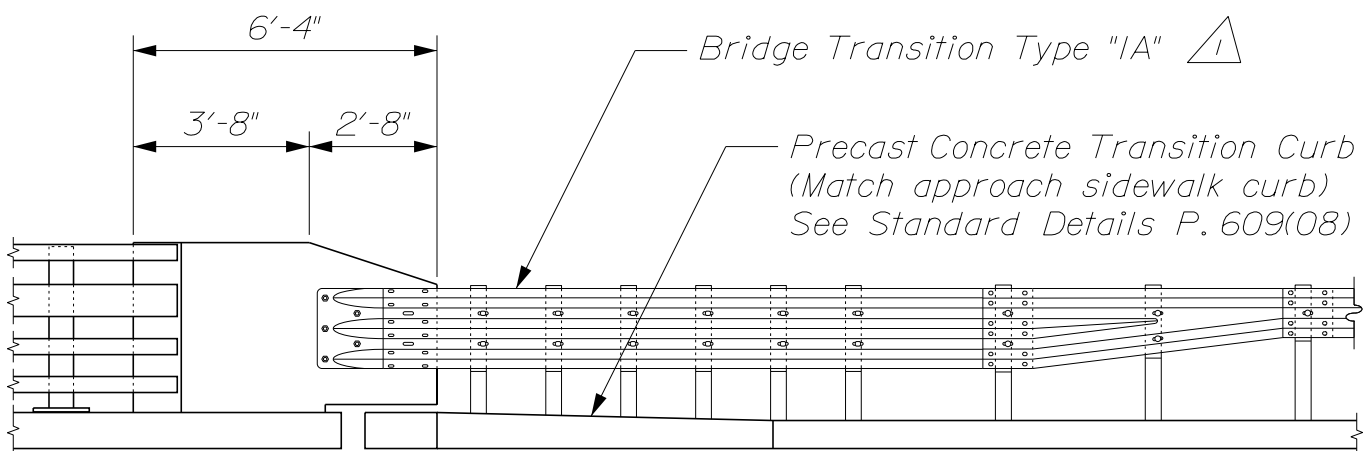

~ CONCRETE TRANSITION BARRIER ~
(4 - Bar Traffic / Pedestrian Railing)

CONCRETE TRANSITION BARRIER

Supplemental
Standard Detail

Supersedes 526(22)

 Jan. 3, 2023