



~ RAIL ELEVATION ~
(Traffic Rail shown; Sidewalk Rail similar)

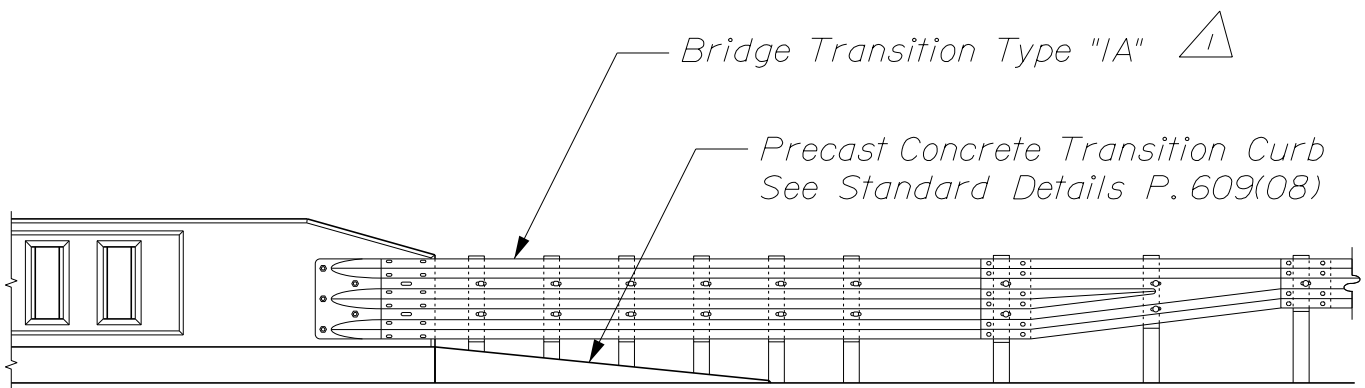

~ GUARDRAIL CONNECTION ~
(Traffic Rail)

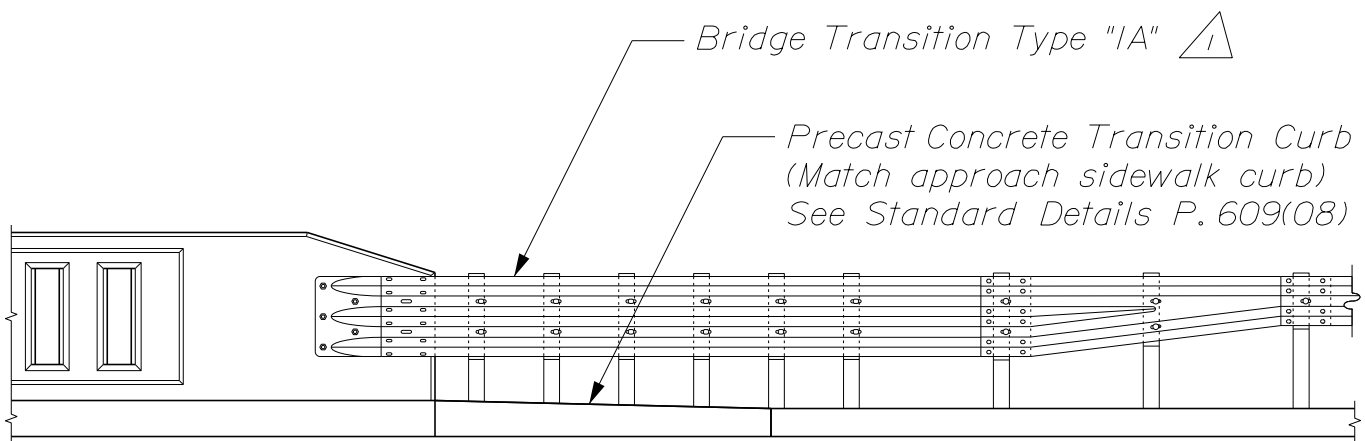

~ GUARDRAIL CONNECTION ~
(Sidewalk Rail)