


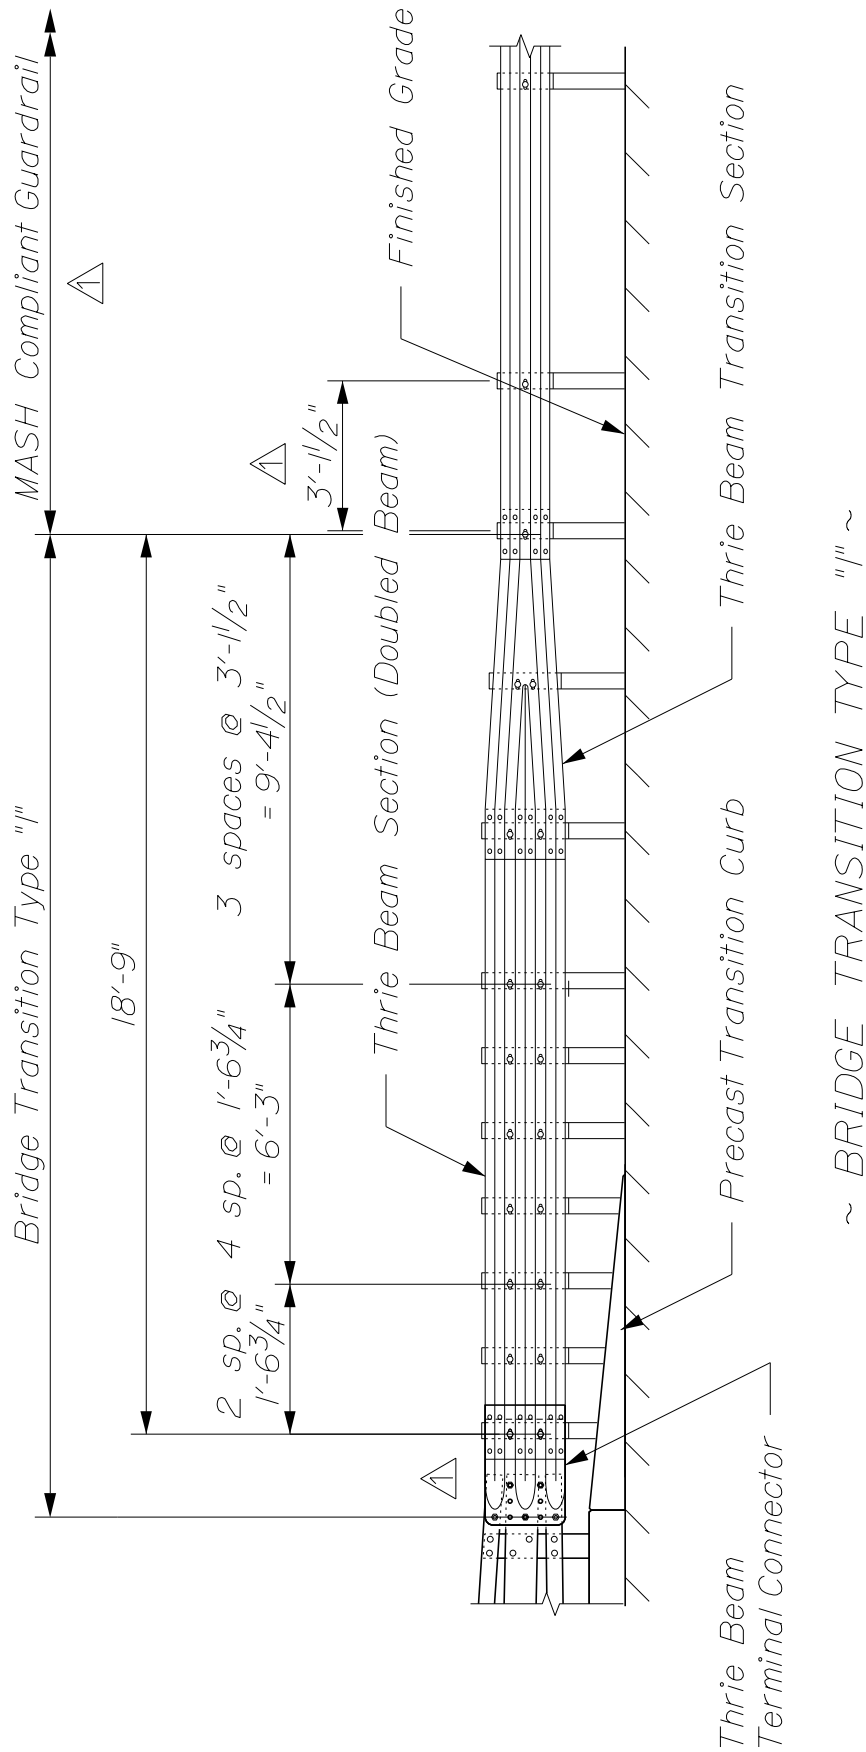

STANDARD BRIDGE TRANSITION - TYPE "I"

Supplemental
Standard Detail

Supersedes 606(23)

△ Dec. 29, 2020

NOTE: Part designations are shown in "A Guide to Standardized Highway Barrier Hardware" as prepared and approved by the AASHTO - AGC - ARTBA Joint Committee, Task Force 13 Report.